


This drawing and the design it covers are the property of BECHTEL. They are hereby loaned and as the borrower's express agreement that they will not be reproduced, copied, imitated, exhibited, nor used except in the limited way and private use permitted by any written consent given by the lender to the borrower.

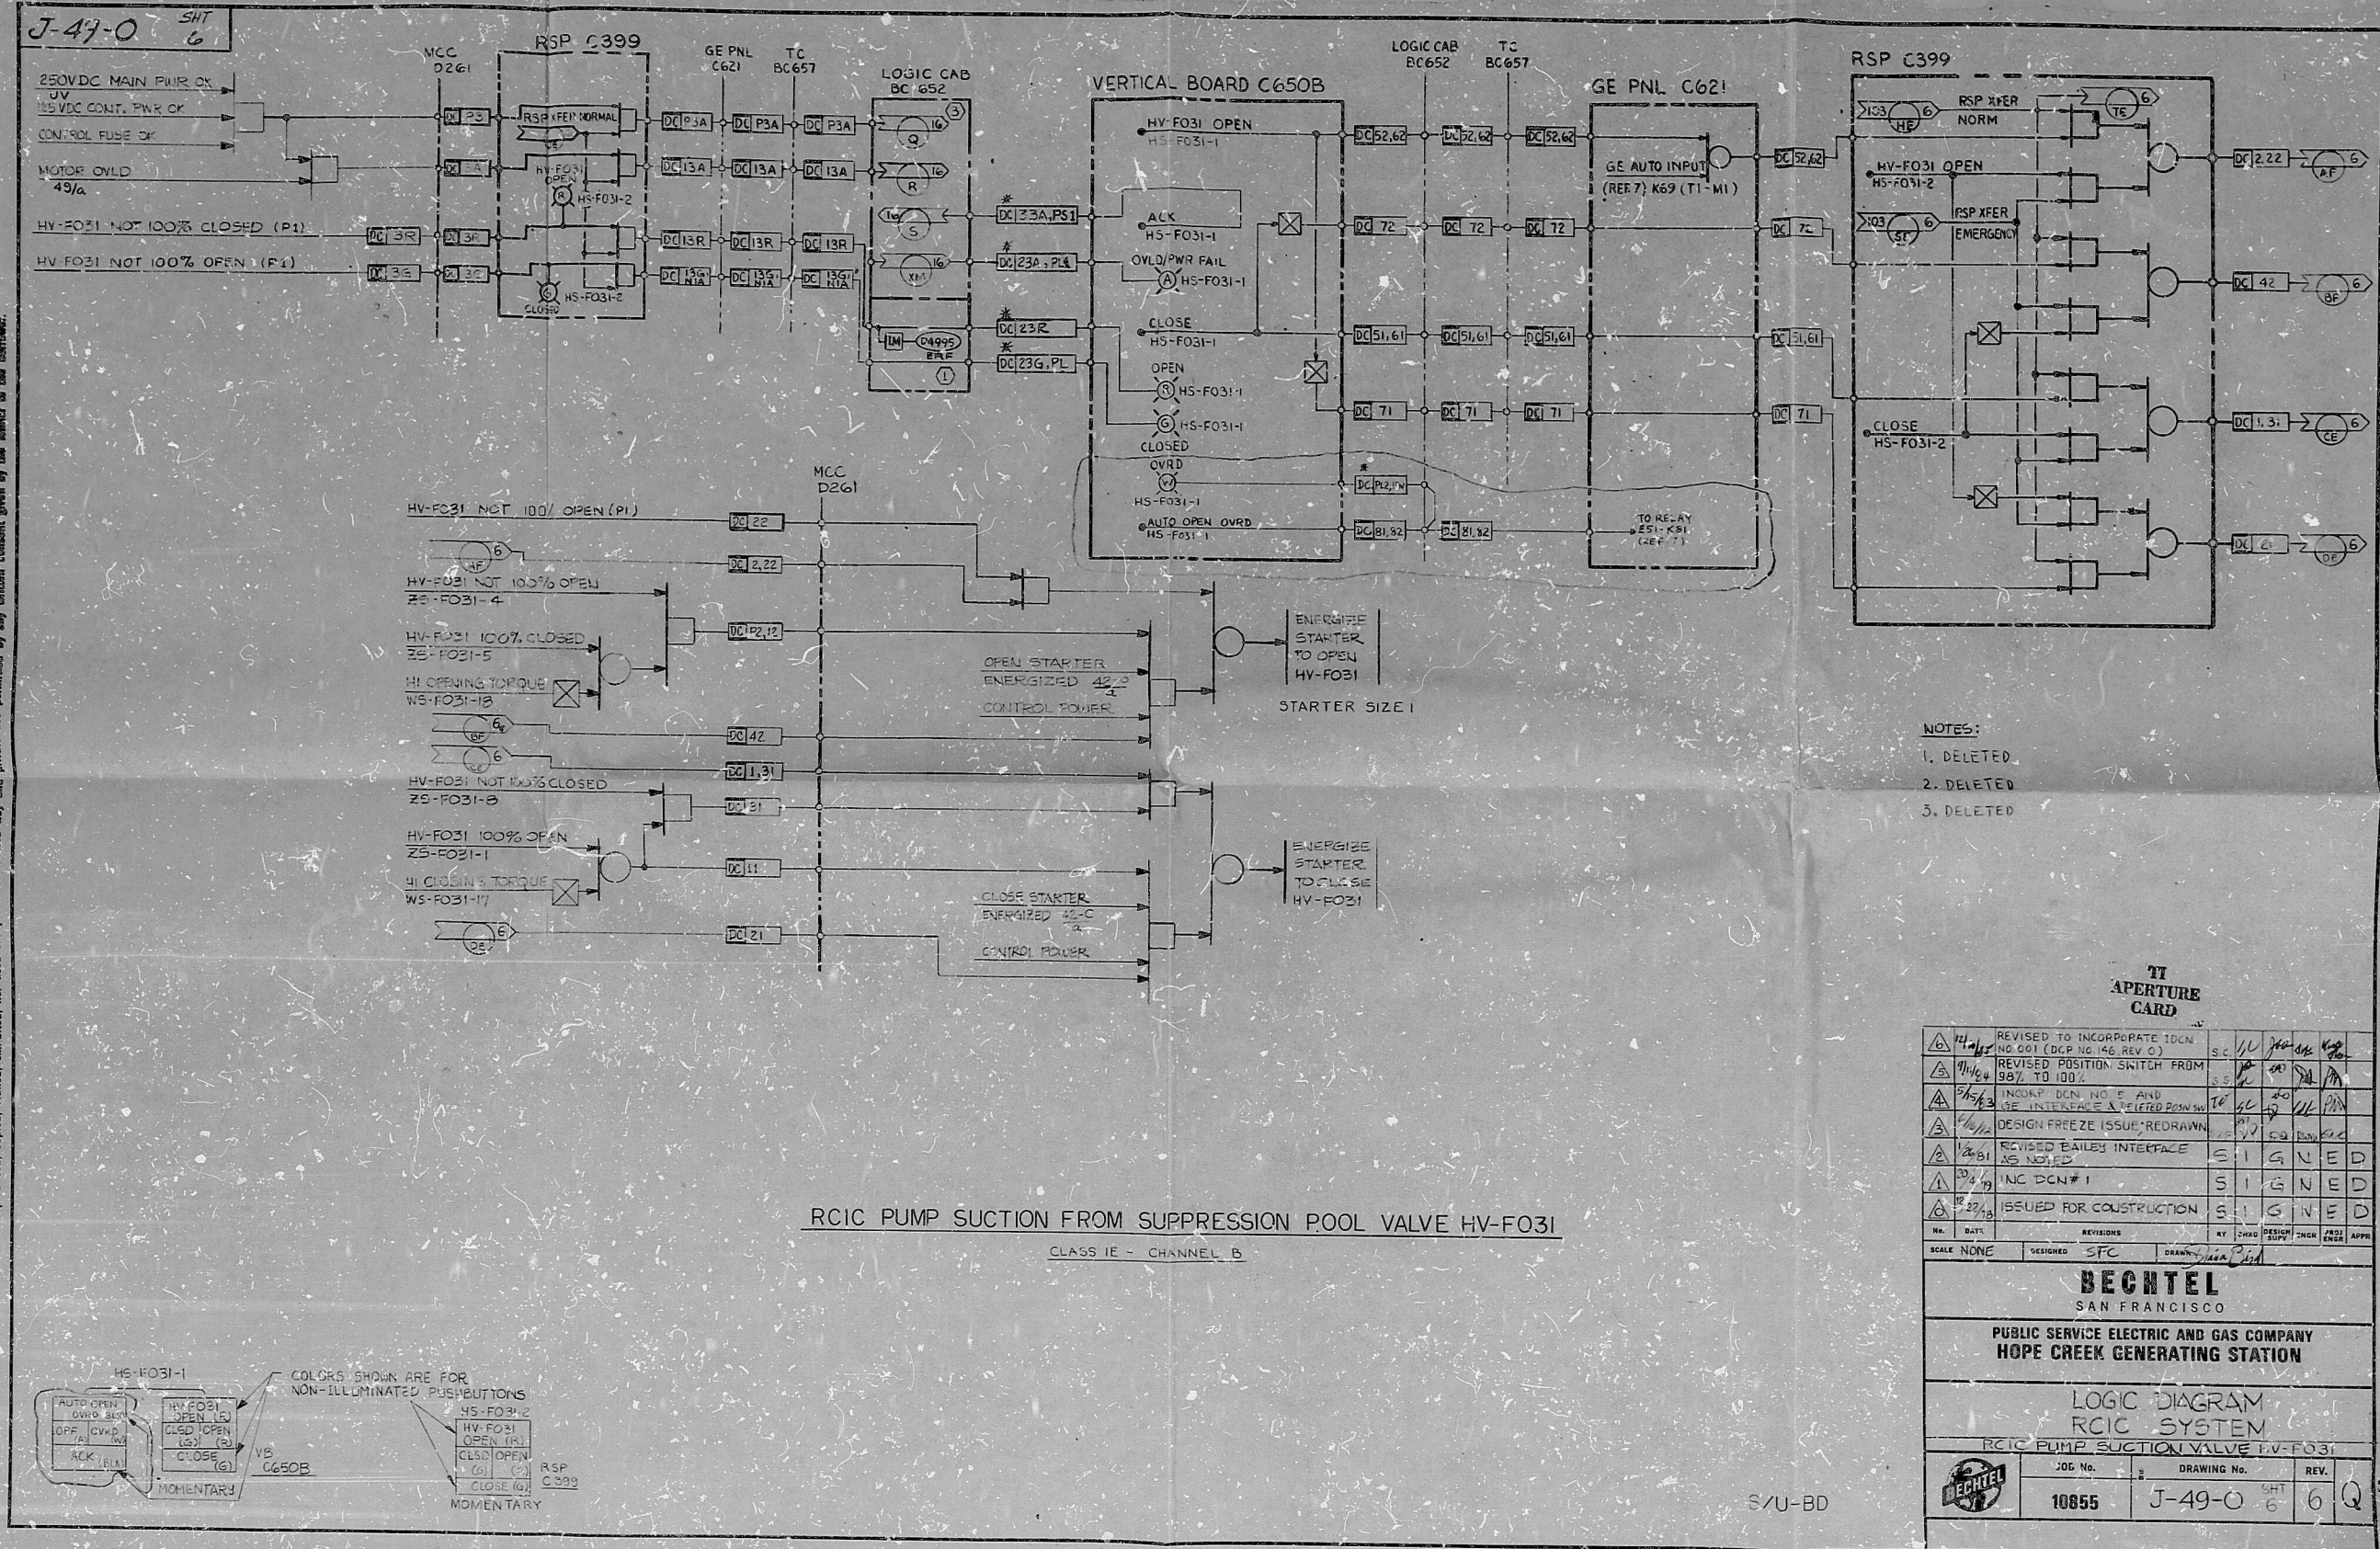

S/U-BD

PDR RIDS

8602260050

