


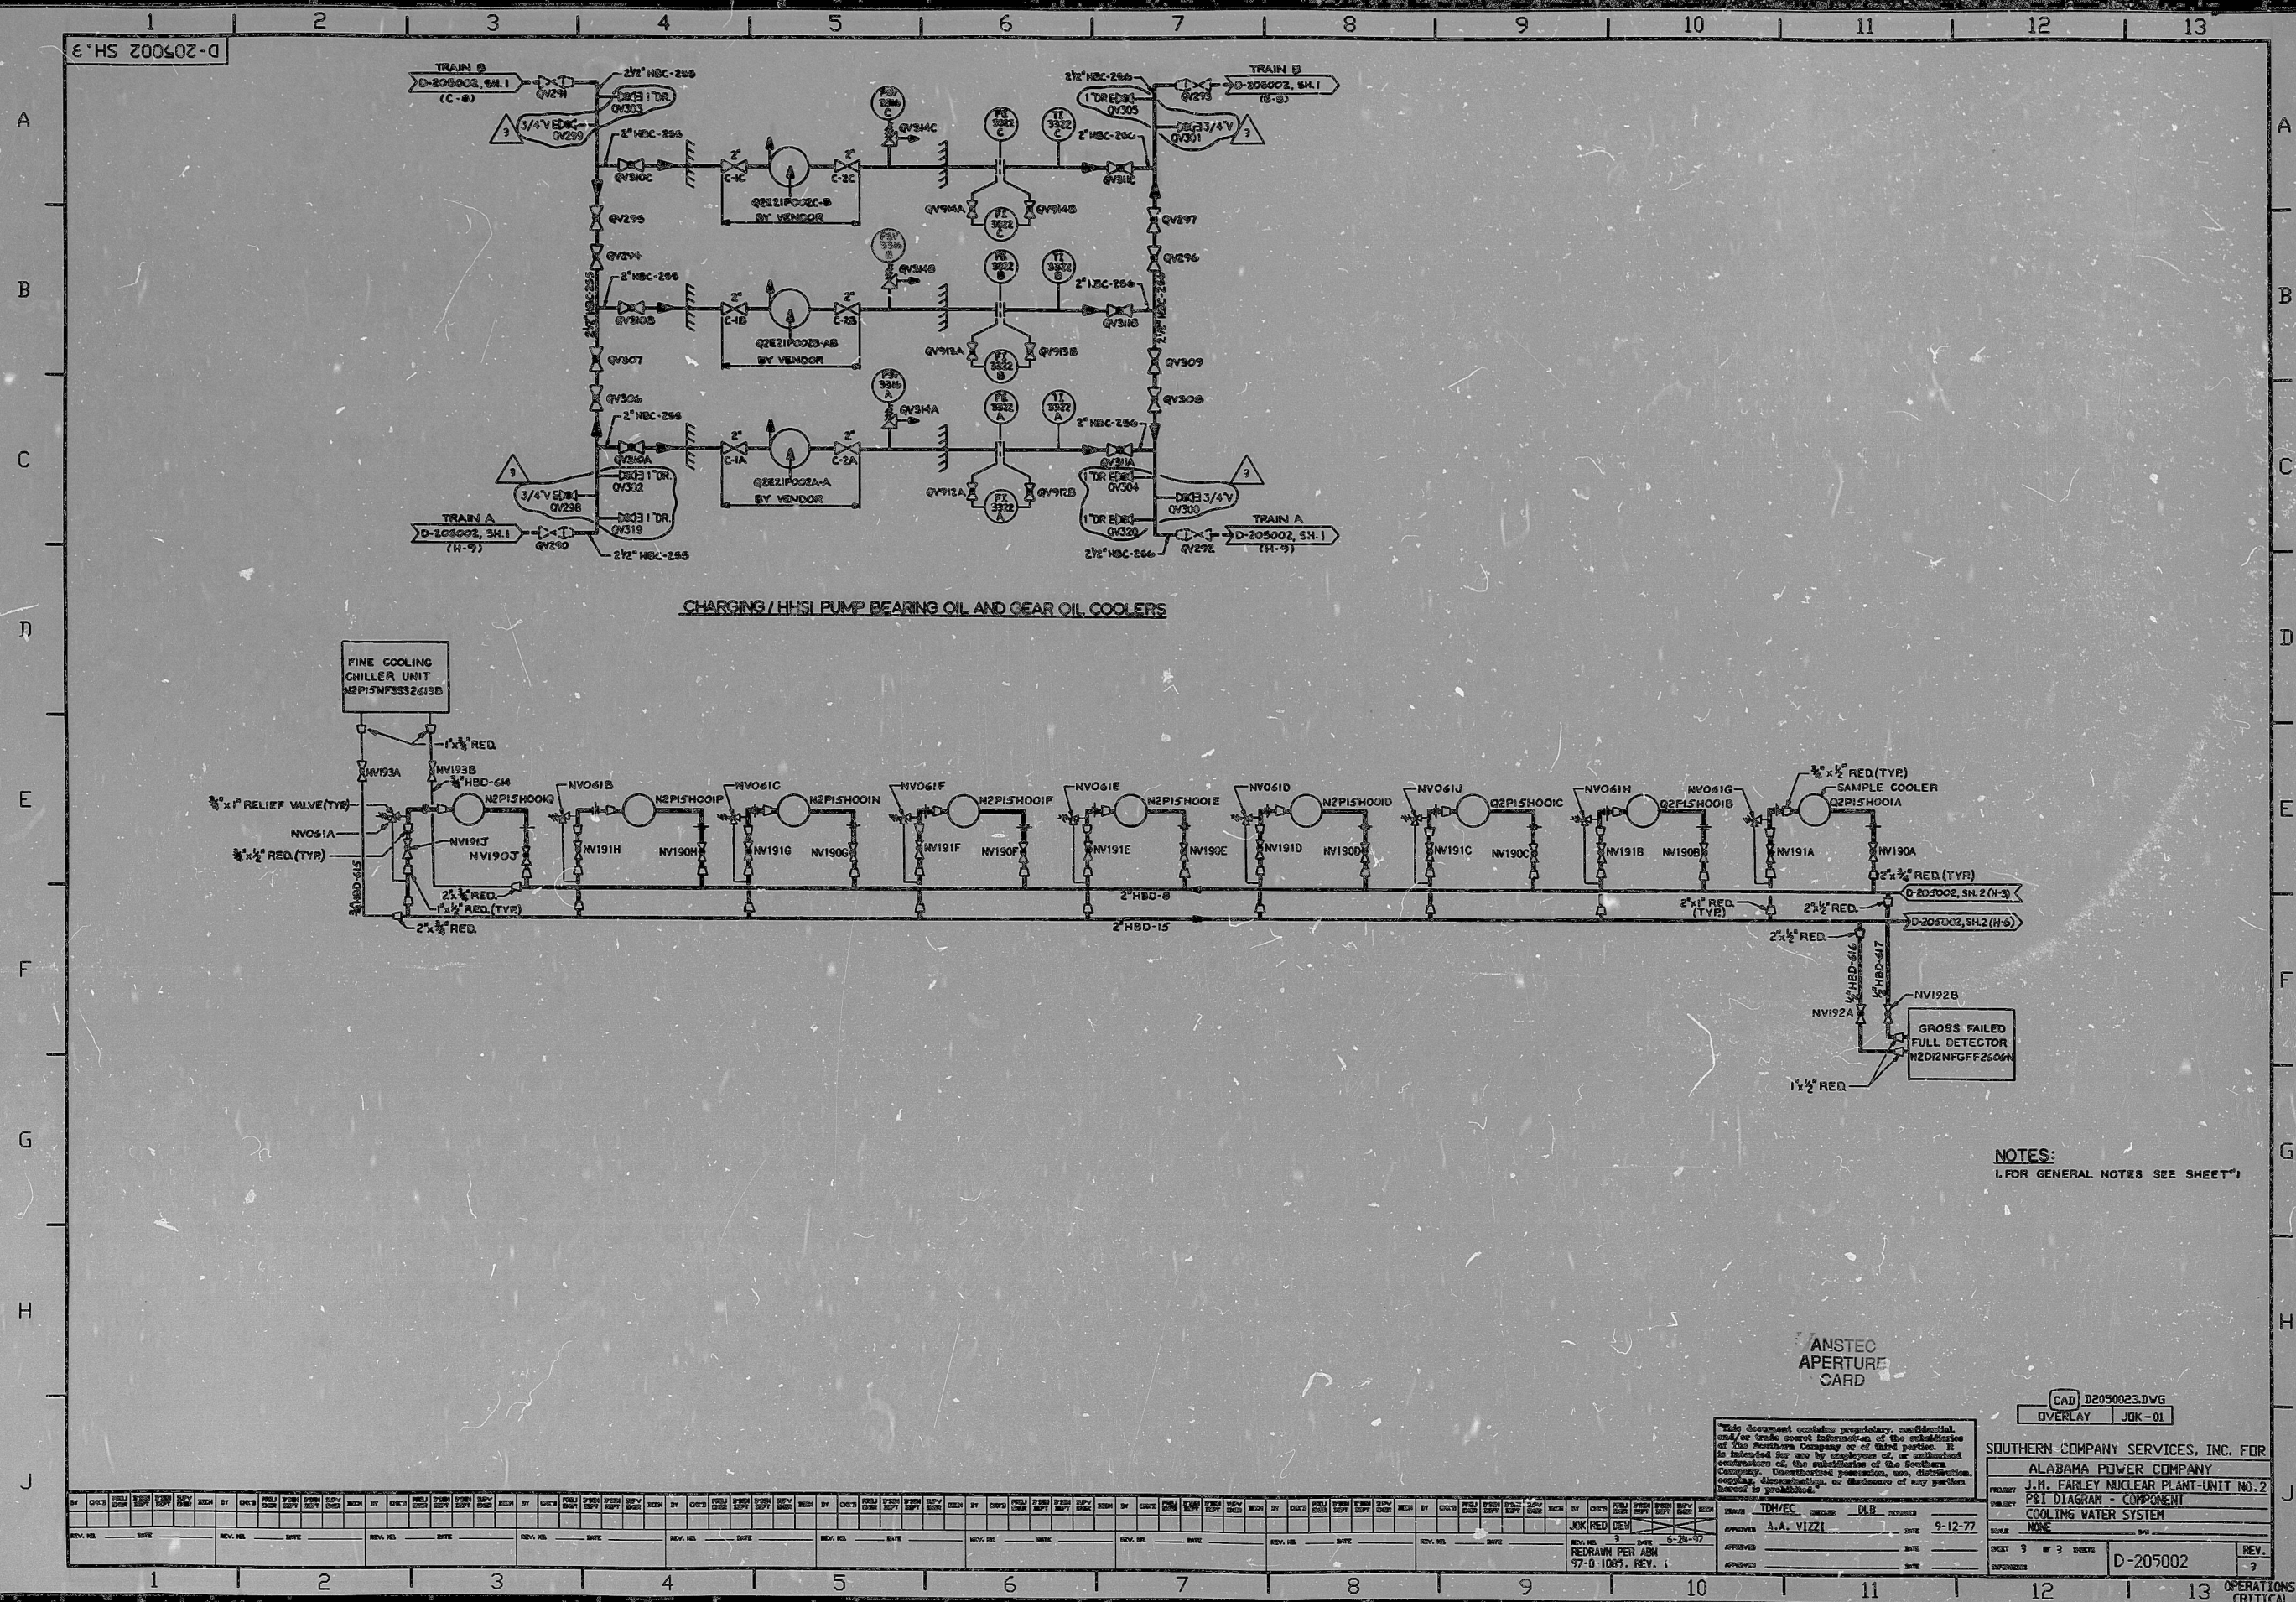

9709240006

PDR RIDS

9709240006

