


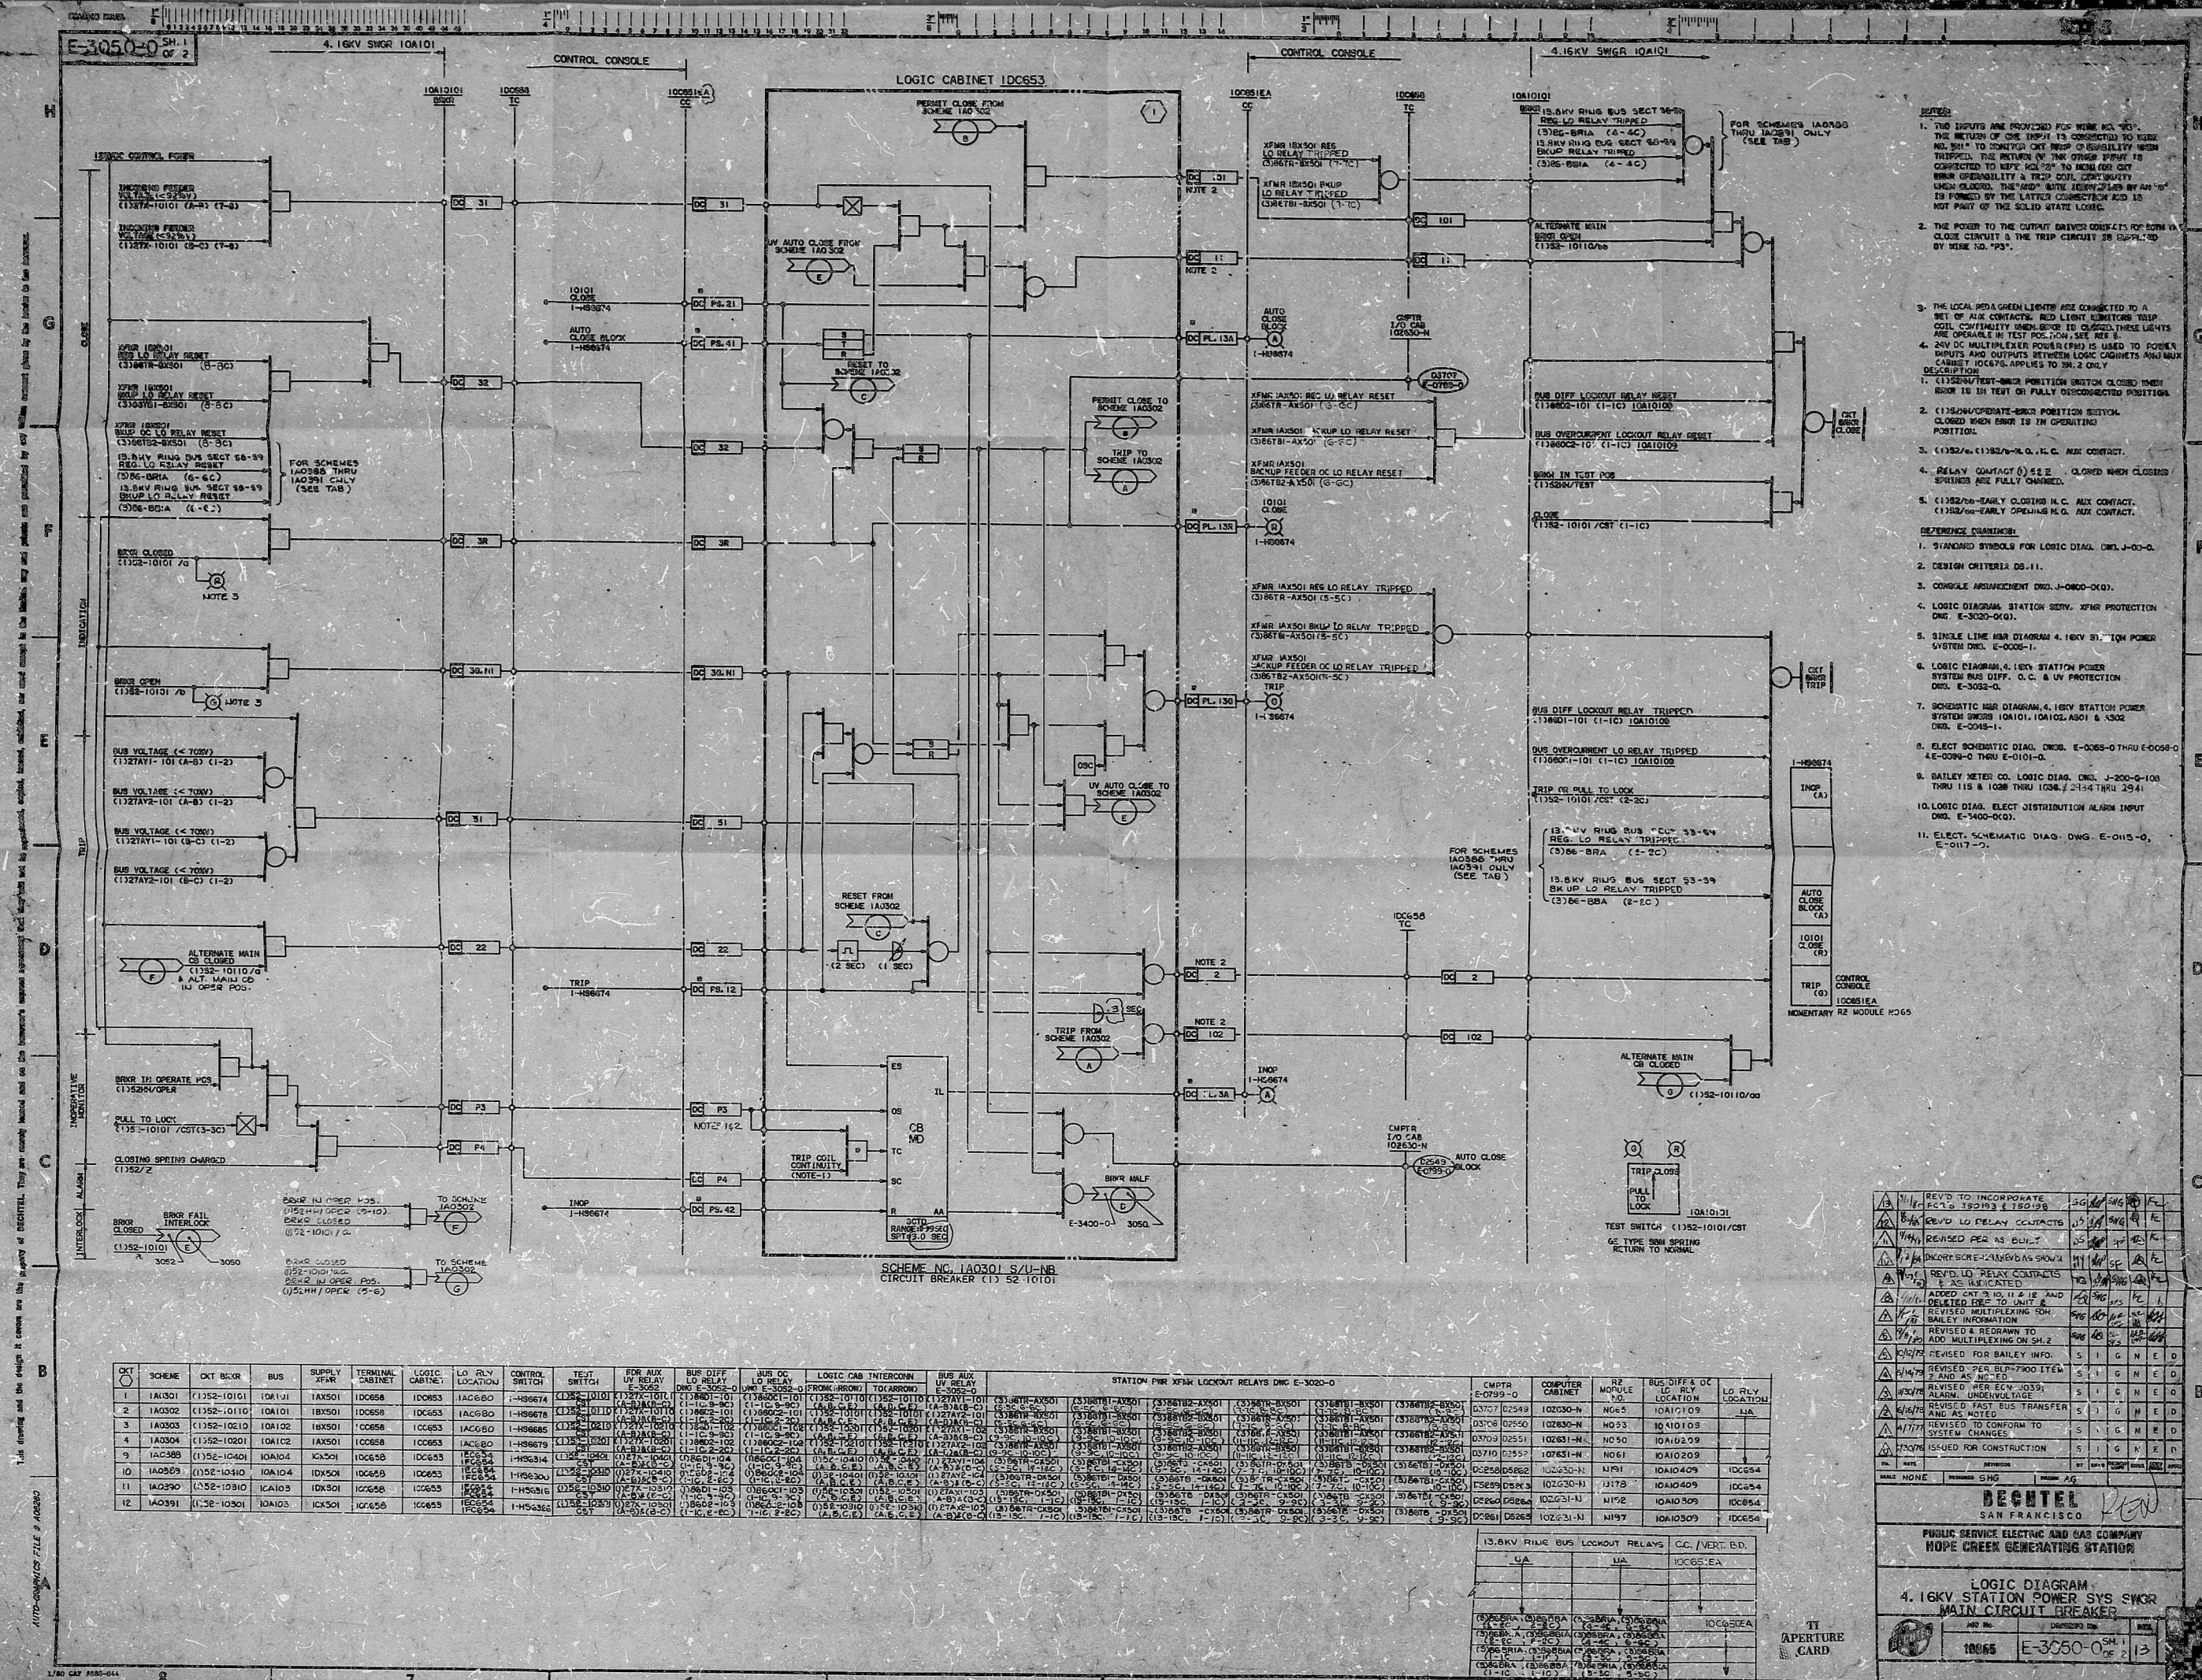



PDR RIDS

8603260324

