


06-M
 DATE 08-28-68
 BY 1111
 CHECKED BY 1111

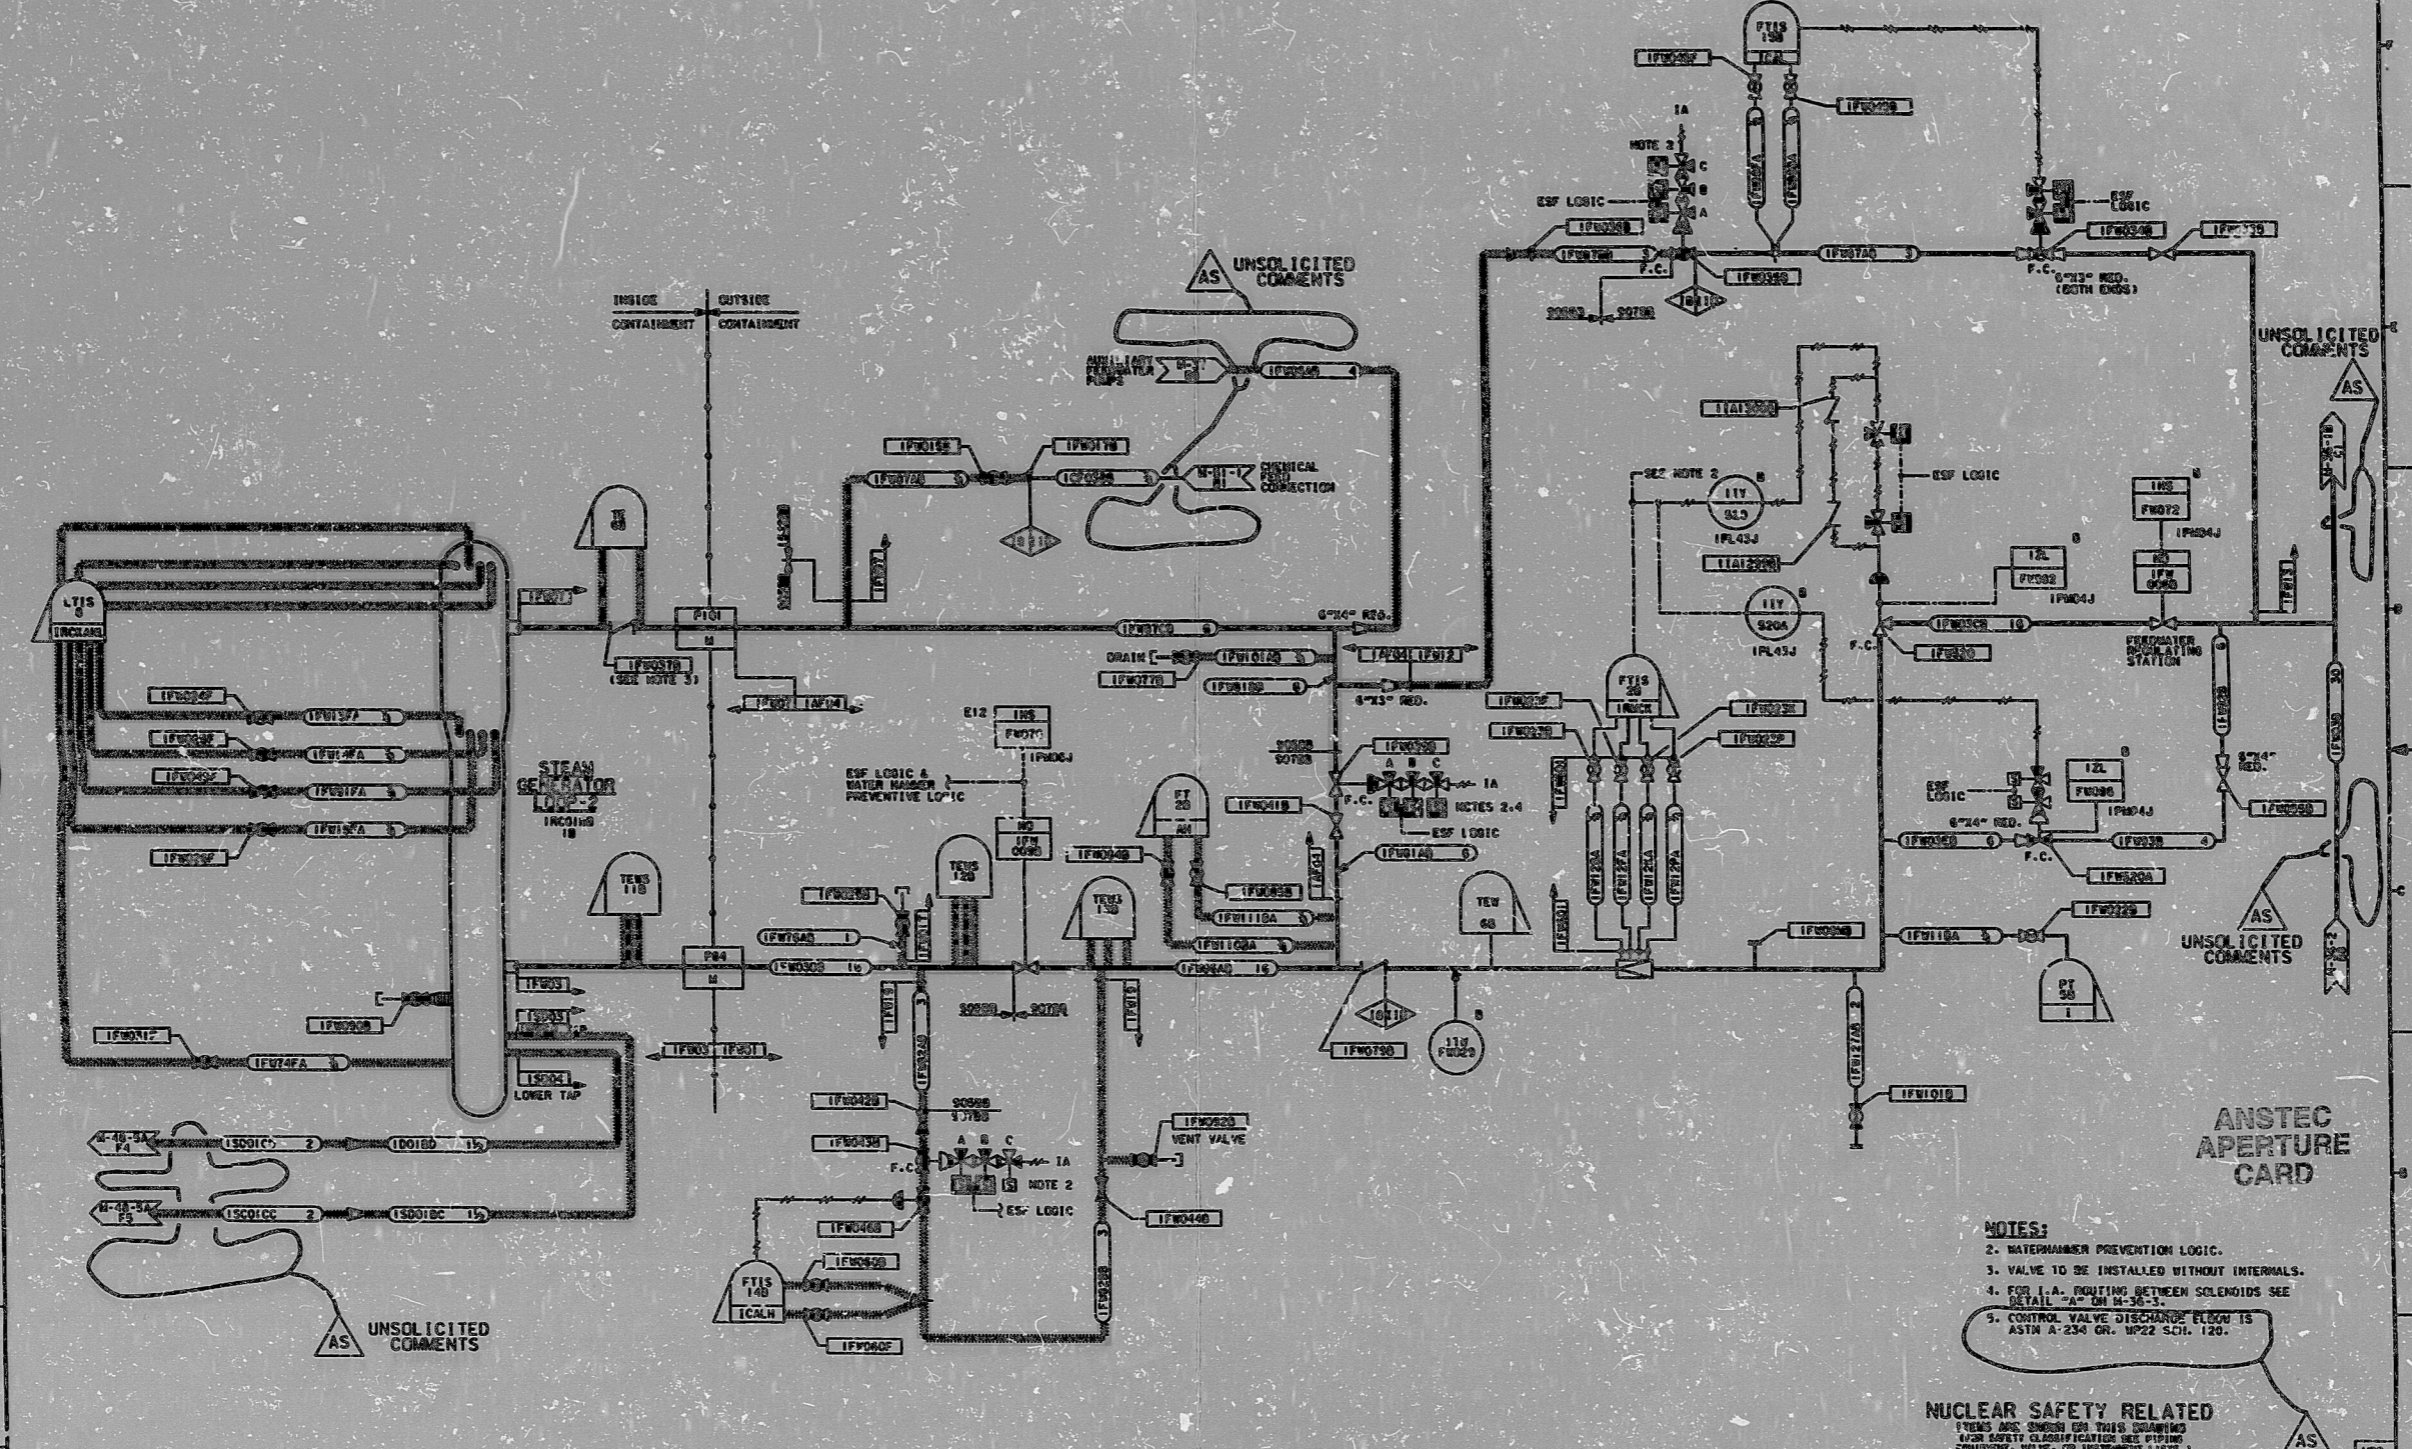


- NOTES:**
2. WATERHAMMER PREVENTION LOGIC.
 3. VALVE TO BE INSTALLED WITHOUT INTERNALS.
 4. FOR I.A. FIGHTING BETWEEN SOLENOIDS SEE DETAIL "A" ON M-36-3.
 5. CONTROL VALVE DISCHARGE ELBOW IS ASTM A 234 GR. WP22 SCH. 120.

NUCLEAR SAFETY RELATED

ITEMS ARE SHOWN ON THIS DRAWING
 WITH SAFETY CLASSIFICATION AND PIPING
 CONTINGENCY, VALVE OR INSTRUMENT LIST(S).

DRAWING RELEASE RECORD				DRAWING RELEASE RECORD			
REV.	DATE	BY	REASON	REV.	DATE	BY	REASON
AS	4-22-68	1111	ISSUED FOR RECORD	AS	4-22-68	1111	ISSUED FOR RECORD
AS	4-22-68	1111	ISSUED FOR RECORD	AS	4-22-68	1111	ISSUED FOR RECORD

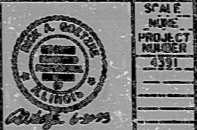

 DRAWING NO. M-36
 SHEET 1A OF 1

SARGENT & LUNDY
 239 N. LA SALLE ST.
 CHICAGO, ILLINOIS 60601
 DRAWING NO. M-36
 SHEET 1A OF 1

BCI

PDR RIDS

9603250176

