




9709240428

PDR RIDS

970924/0428

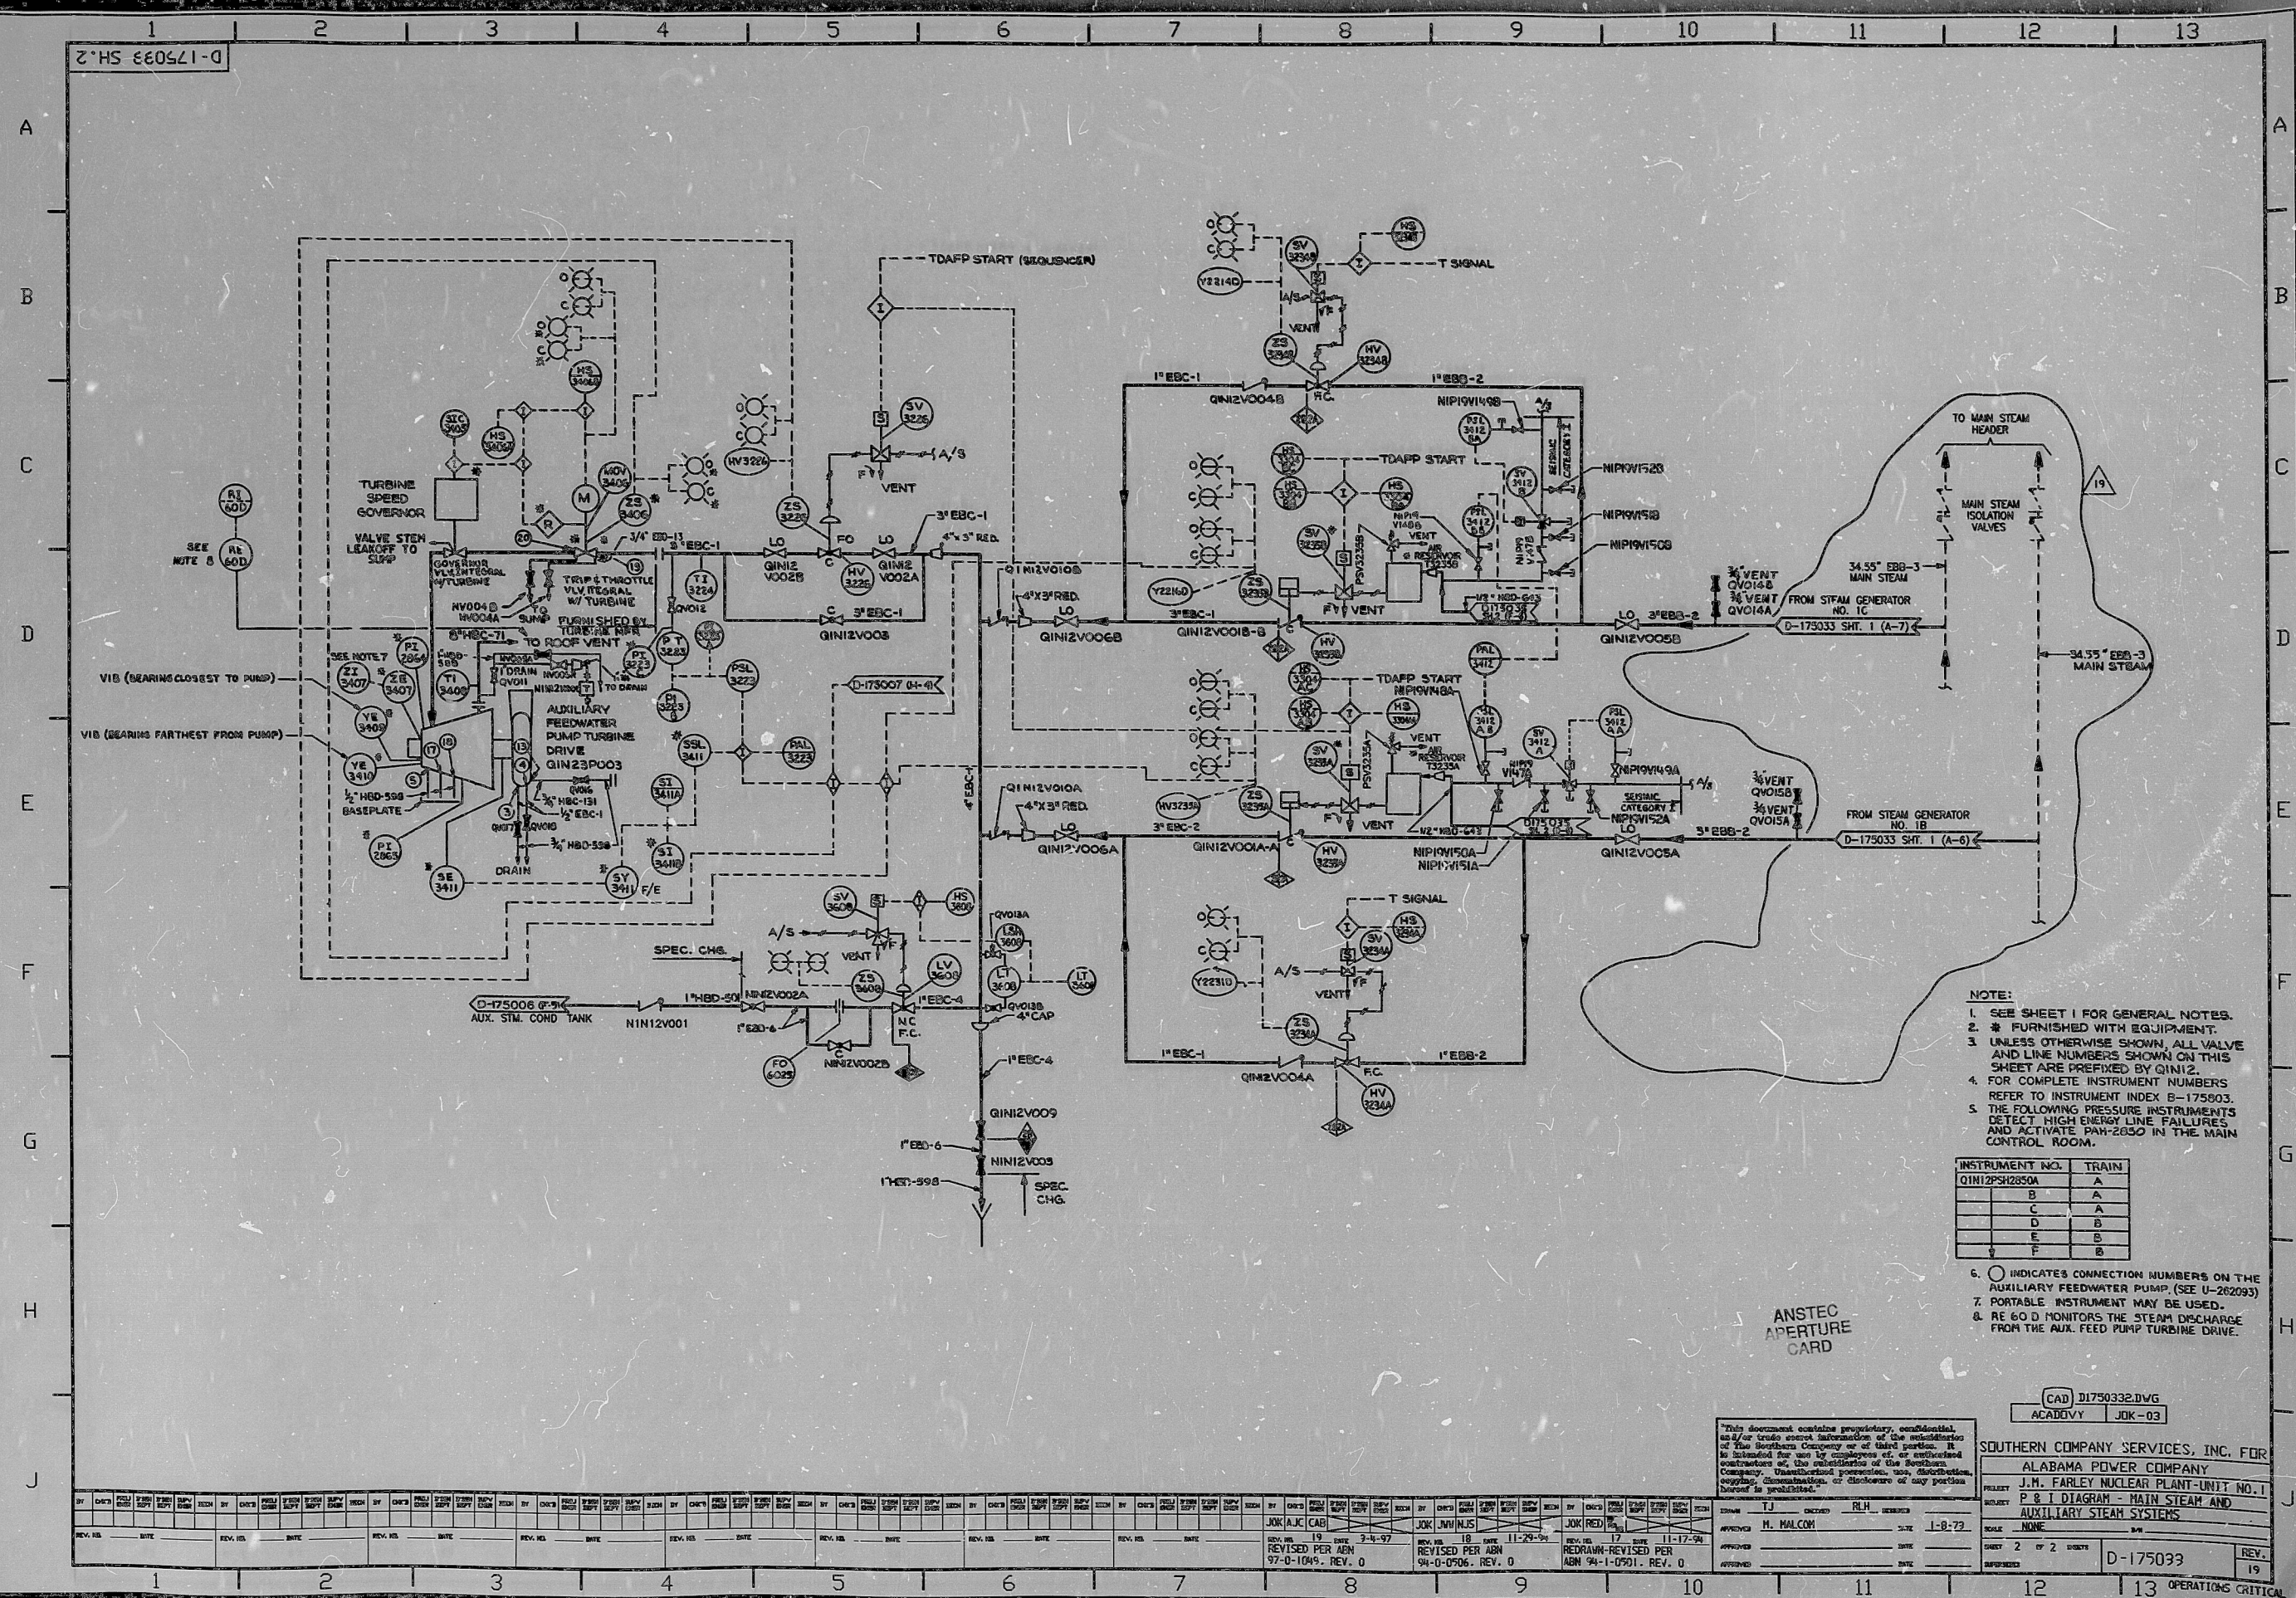