

20CF-7-1
20FHS 20FTI



HIGH ENERGY

25313
2/201
811119


BILL OF MATERIAL									
MAT'L L.D.	QUANTITY	MATERIAL CLASS TYPE	SPECIFICATION QTY GRADE	DESCRIPTION	CONST.	SIZE	SCH.	LOT NO.	
A	1	B	CS	90° ELL - (BW)	SMLS	16"	80	50. #1294-1111	N
B	1	CS		GRINNELL SUPPLIED PIPE & FITTINGS				DN-CW-CF-28	
C	1	CS						DN-CW-CF-38	
D	0	SS		THERMOWELL		1"		20FTW5770	
E	2	B	CS	HAIF CPLG. (SW) FOR		3/4"	2000	EM-1F4198436	I
F	0	CS	SA-105	ALIGNMENT BAR		6"x4"		50 REL 706	
G	0			PENETRATION				2M-2621	
H	5	B	CS	ACCESS HOLE PLUG FOR		1 1/2"			
J	2	B	SS	PIPE	SMLS	1/2"	80	1184A11F08044	
K	2	B	CS	PIPE	SMLS	3/4"	160	1184A11F08044	
L	2	B	SS	RED. INS. SW FOR		3/4"x1/2"	3000	EM-2F4198436	I
M	1	A	SS	VEIS TAGGED (SW)		3/4"		DN-0411-573	
N	1	B	SS	VEIS TAGGED (SW)		1/2"		DN-0411-573	
P	1	A	SS	VEIS TAGGED (SW)		3/4"		DN-0411-573	
Q	1	B	SS	VEIS TAGGED (SW)		1/2"		DN-0411-573	
R	0	B	SS	PIPE CAP SCRD FOR		1/2"	3000	EM-2F4198436	I
S	1	SS		TESTWELL		1"		20FTW5780	
T	1	B	CS	HAIF CPLG. (SW) FOR		1"	1000	EM-1F4198436	I
U	1	B	CS	20CF044 (CK) BW		16"	80	DN-0411-232	
V	0	B	SS	NIPPLE (SW) FOR	SMLS	1/2"	80	1184A11F08044	
W	0	CS		GRINNELL SUPPLIED PIPE & FITTINGS				DN-CW-CF-27	
X	0	CS		STEAM GENERATOR 2B		16"	80		
Y	2	B	SS	CAP (COMP)		1/2"		1120000920N	
Z	1	B	CS	H/CPLG. (S) FOR		1"	3000	EM-1F4198436	I
AA	1	SS		THERMOWELL		1"		DN-20FTW5780	
BB	4	CS	SA105	ALIGNMENT BAR		6"x4"		50 REL 706	
CC	2	B	CS	PIPE	SMLS	3/4"	1600	EM-1F4198436	I
DD	1	CS		NPT PLATE					

8	DELETE 7 JS DEL 10/24/85	CLM	2m
9	REV ITEM Y	2/15/86	2:11-87
10	DEL ITEM F	4/11/87	4:11-87
11	REV ITEM H	4/11/87	4:11-87
12	ADD WELD 35+36	5-4-88	5:4-88

SECTION A-A
PROCESS PIPE WITH RUB PADS

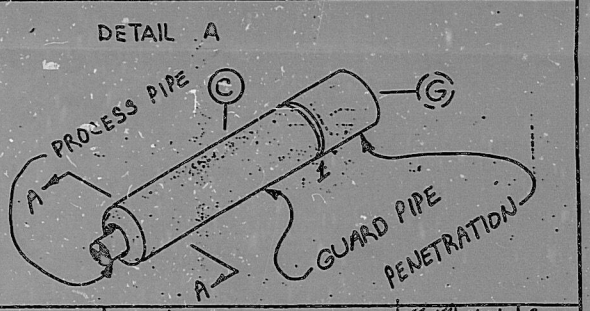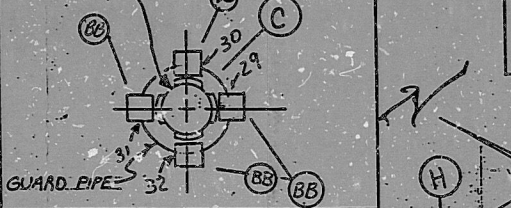

12	REV ITEM A-H	6-1-84	6:1-84
13	ADD ITEM CC	6-1-84	6:1-84
14	REV ITEM Y LOT NO.	6-1-84	6:1-84
15	ADD ITEM DD ADD WELD 41	6-1-84	6:1-84

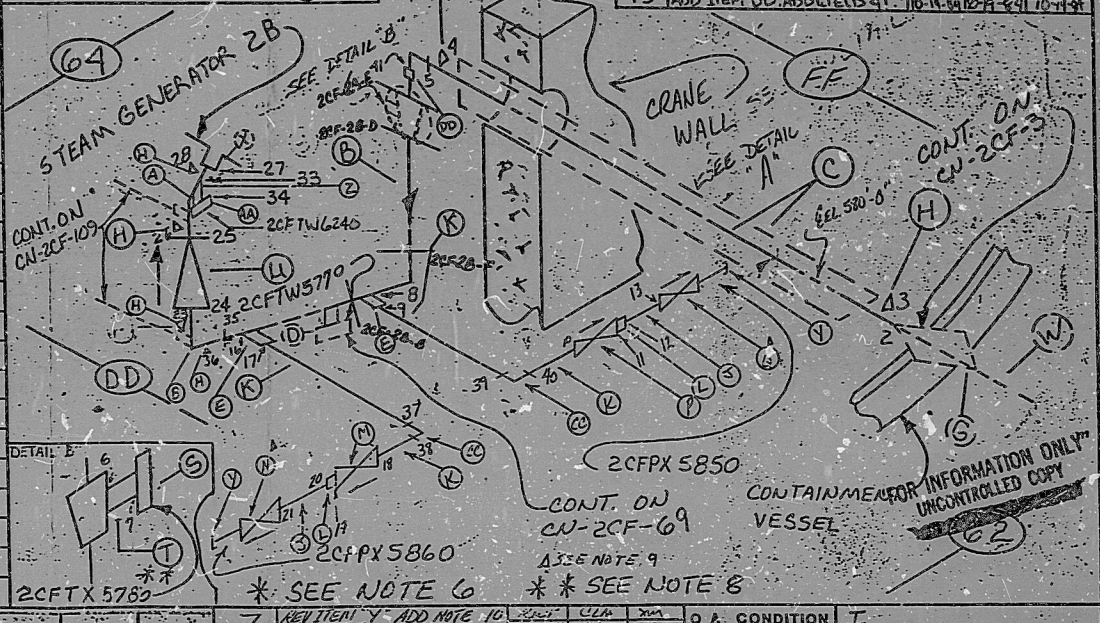

- NOTES:
- ALL WELD NUMBERS SHALL BE PRECEDED BY 2CF-65
 - LAST WELD NO. 41
 - REF. LAYOUT DWG. CN-2491-CF006 1VN# 41605.44.274
 - LOOP 2CF586, 2CF585, 2CF578, 2CF624
 - REF. FLOW DWG. CN-2541-1.1 (D,E-4)
 - CHECK FOR INSERVICE INSPECTION 1400 PSIA 160°F
 - P.S. 900.7 APPLIES TO GUARD PIPE ONLY
 - WELD NO. 15 NOT USED
 - HAIF COUPLING LOCATED ON EAST SIDE
 - VALVE WITH FACTORY WELDED TUBE ON OUTLET SIDE OF VALVE
 - ALL WELDED JOINTS SHALL BE PRECEDED BY 2CF-65

WELD#	SIZE	SCH.	WELD#	SIZE	SCH.	NO.	REVISION
36	1 1/2"	80					
37	1 1/2"	80					
7	REV ITEM Y ADD NOTE 10	6-1-84	6:1-84
8	ADD WELD 27+28 WELLS	6-1-84	6:1-84
11	REV ITEM A	6-1-84	6:1-84

PDR RIDS

8808260201

