



CIRCULATING WATER PUMP HOUSE (BYRON)
NOTE: SAFETY CATEGORY E, QUALITY GROUP D

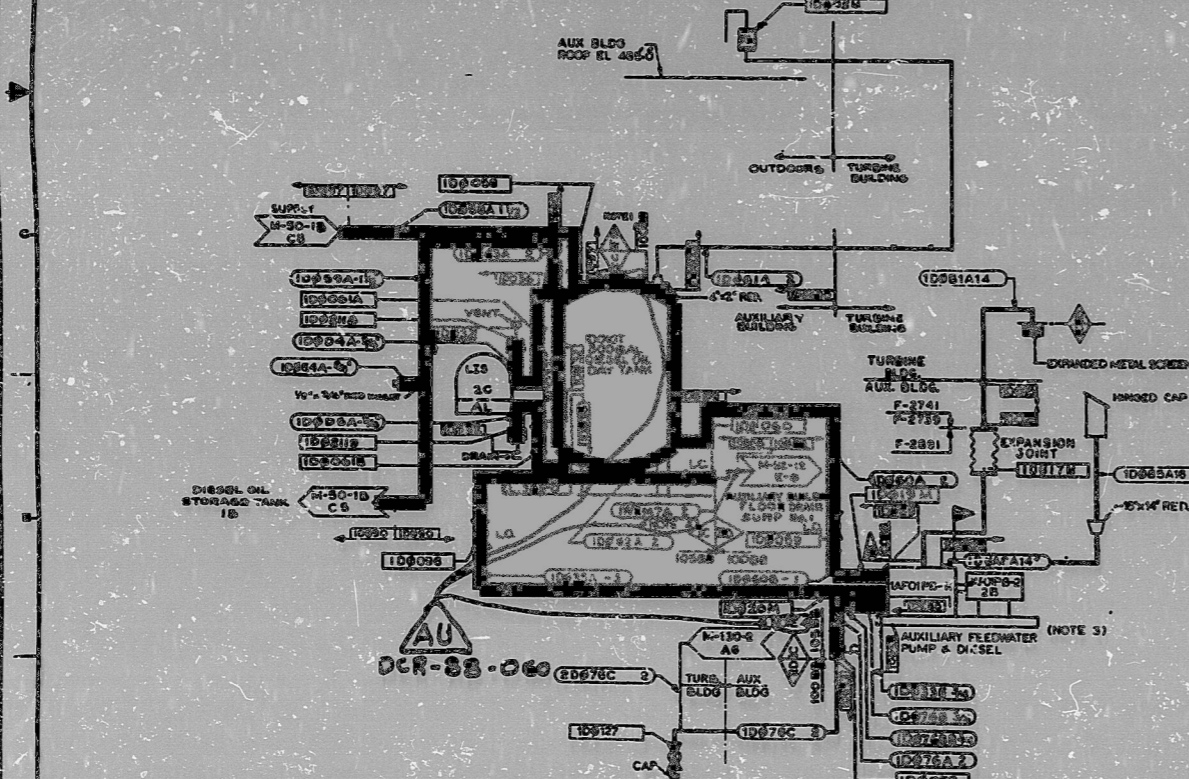

AU
DCR-88-060

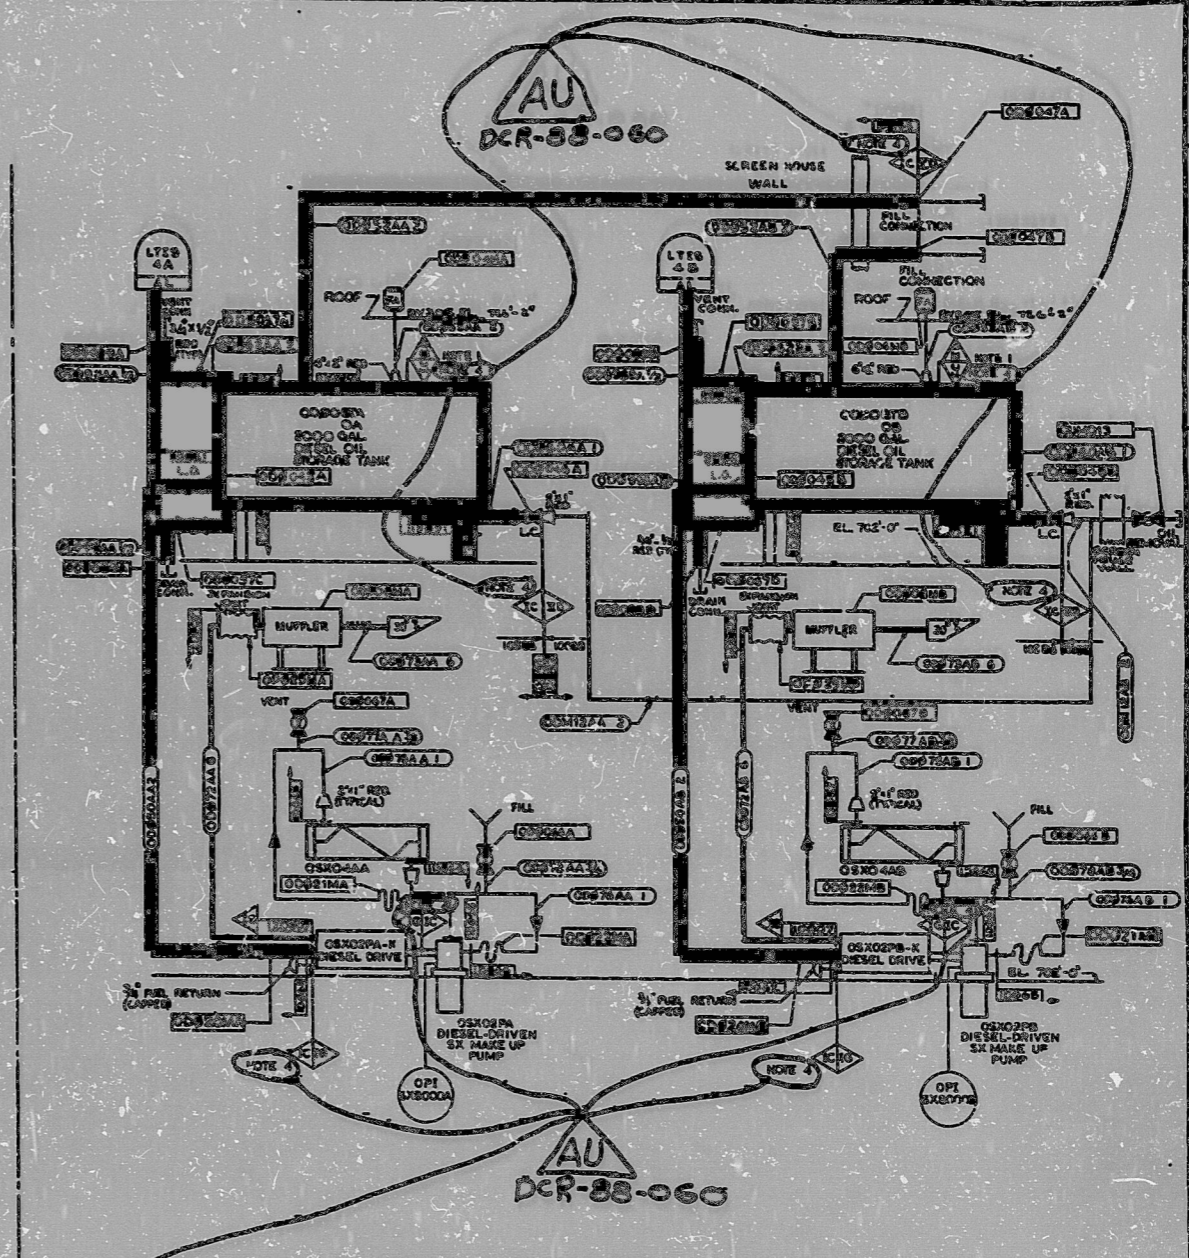

BYRON SCREEN HOUSE (BYRON)
NOTE: SAFETY CATEGORY E, QUALITY GROUP C UNLESS OTHERWISE NOTED

- NOTES:
1. CLASSIFICATION CHANGE TO BE MADE AT NOZZLE CONNECTION.
 2. ALL FILL CONNECTIONS TO TERMINATE OUTSIDE BUILDING AT CONVENIENT TRUCK LOAD POINT.
 3. PUMP (AFOPE) CLASSIFICATION IS 1C DIESEL DRIVE (AFOPE-A) CLASSIFICATION IS 1C.
 4. PIPING CLASSIFICATION ON THIS DRAWING REFERRED TO IS 1C UNLESS OTHERWISE NOTED.

ANSTEC APERTURE CARD

NUCLEAR SAFETY RELATED ITEMS ARE SHOWN ON THIS DRAWING (FOR SAFETY CLASSIFICATION SEE PUMP, EQUIPMENT, VALVE, OR INSTRUMENT LIST.)

REV	DATE	BY	CHKD	DESCRIPTION


DIAGRAM OF DIESEL FUEL OIL BYRON STATION UNITS 1 & 2
CHICAGO, ILLINOIS

MC

PDR RIDS

9603270236

