


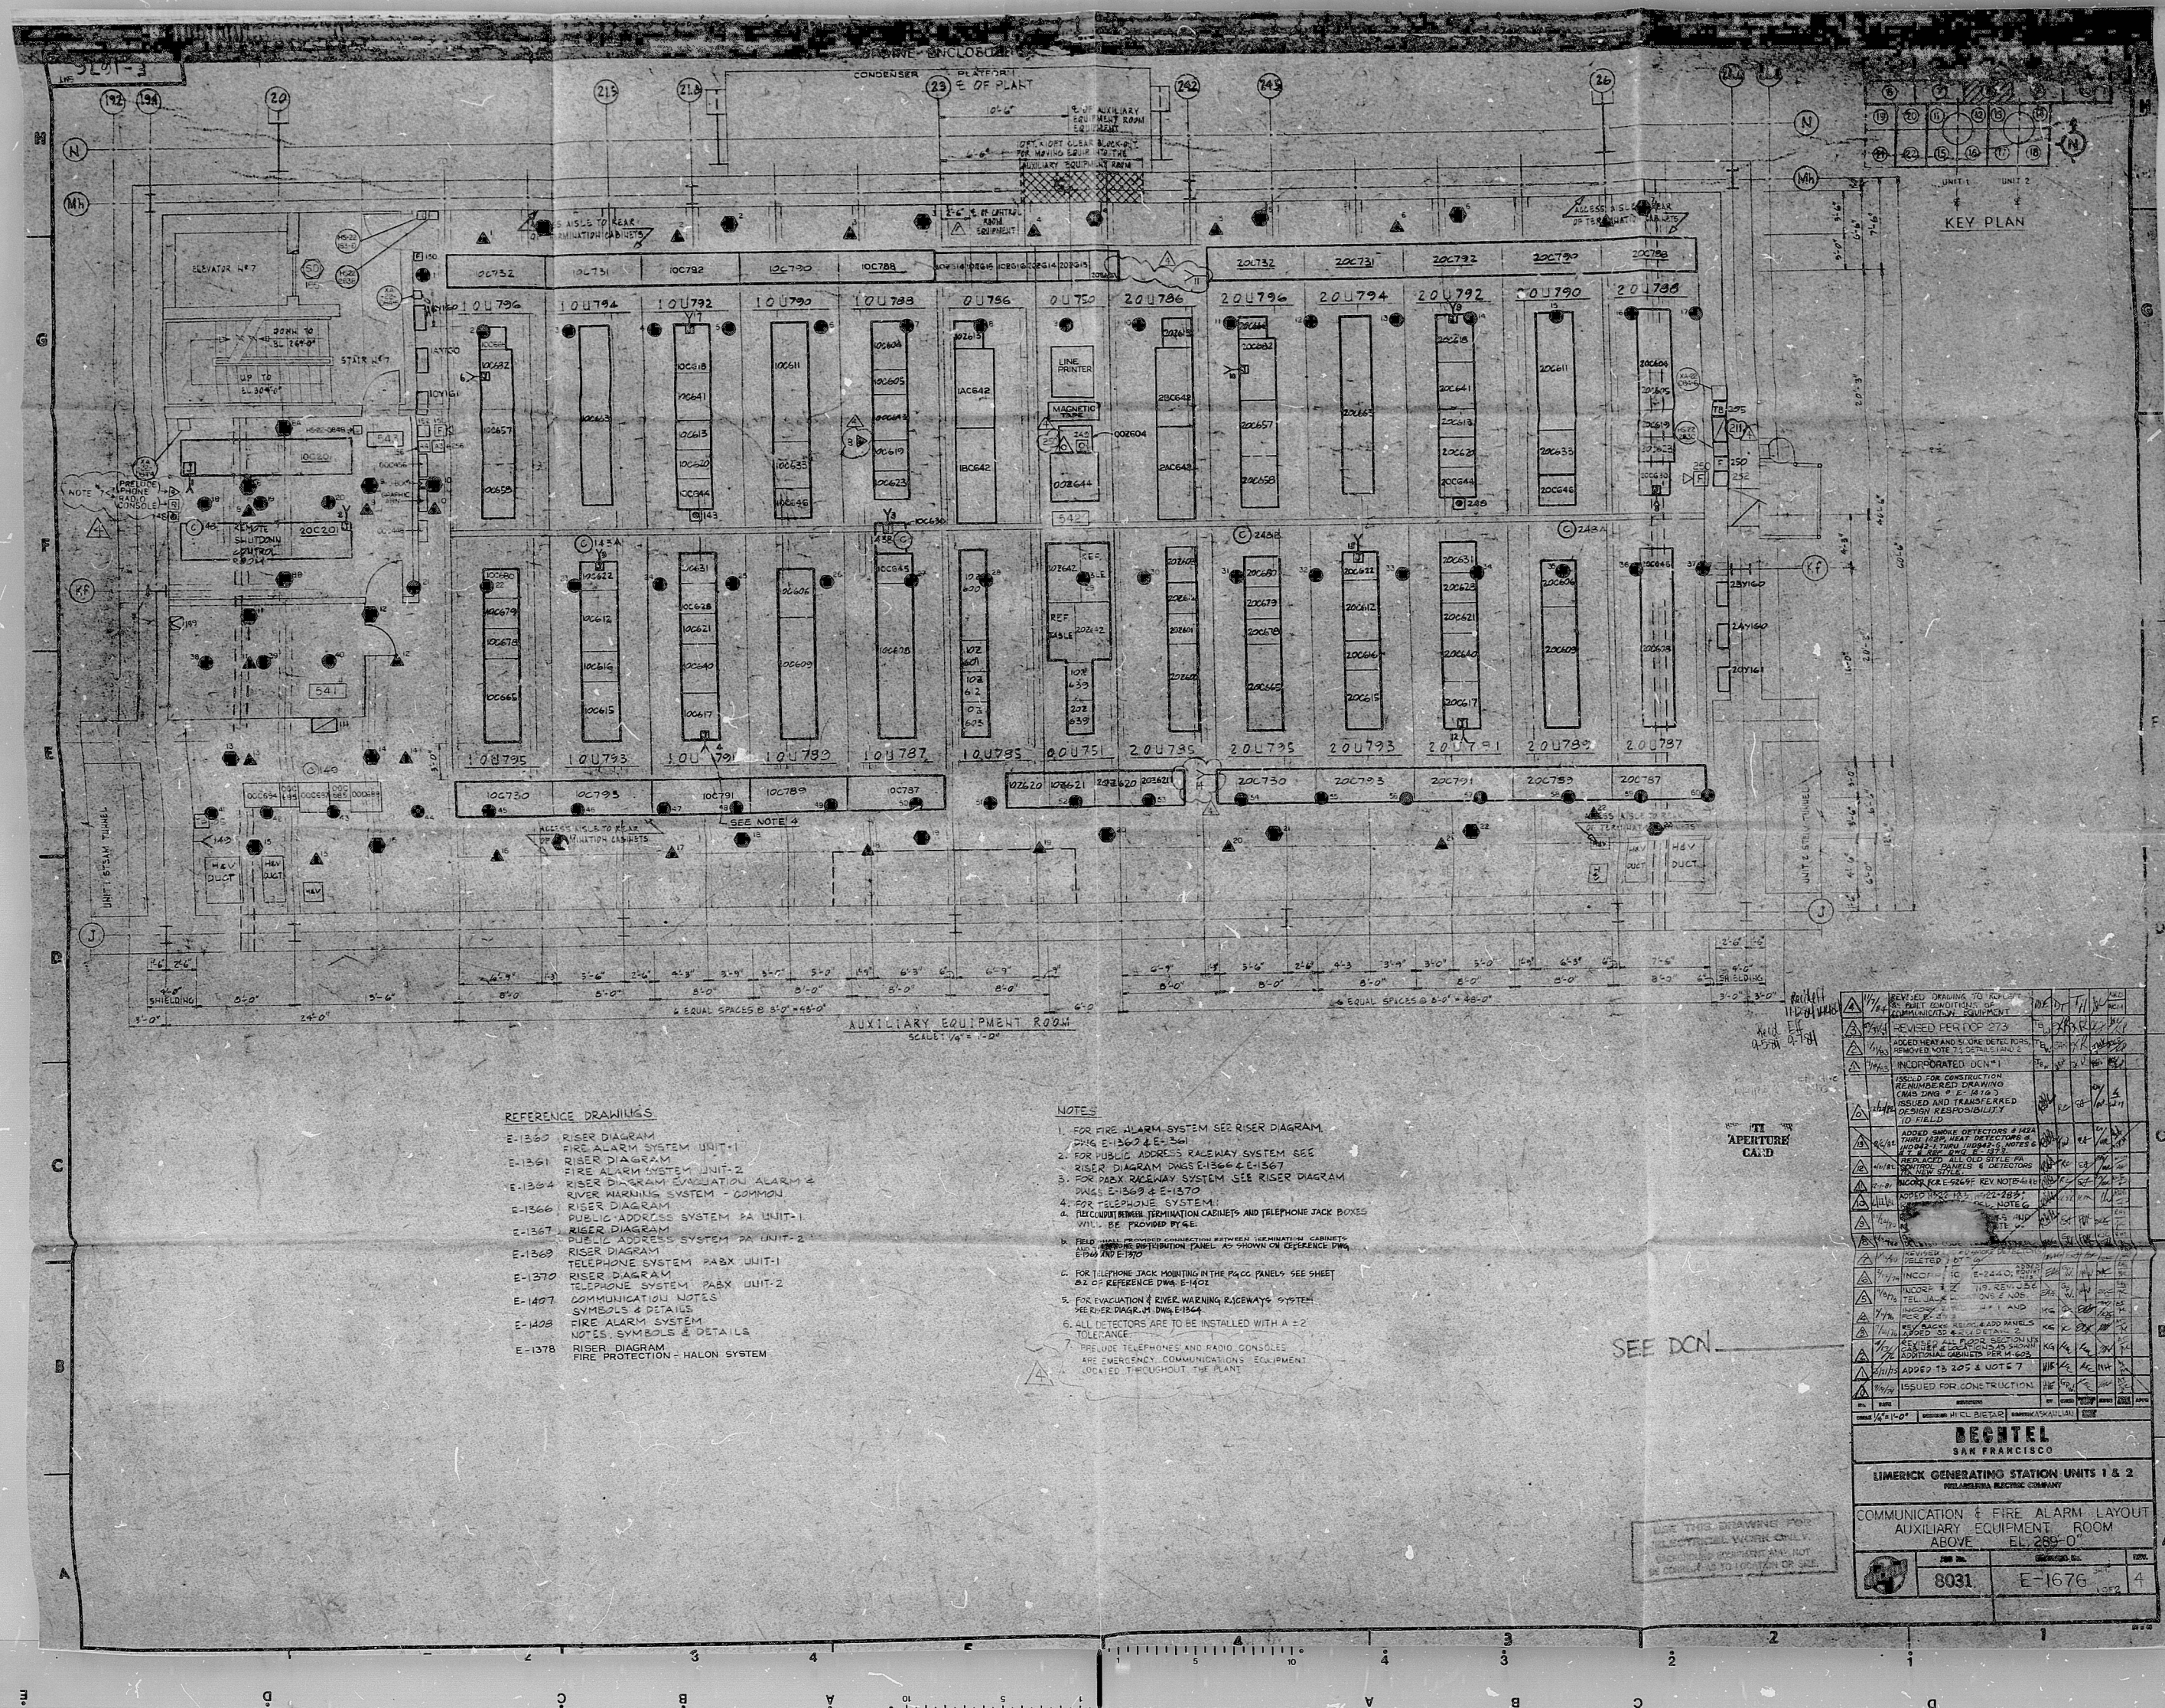



8702170305

PDR RIDS

