


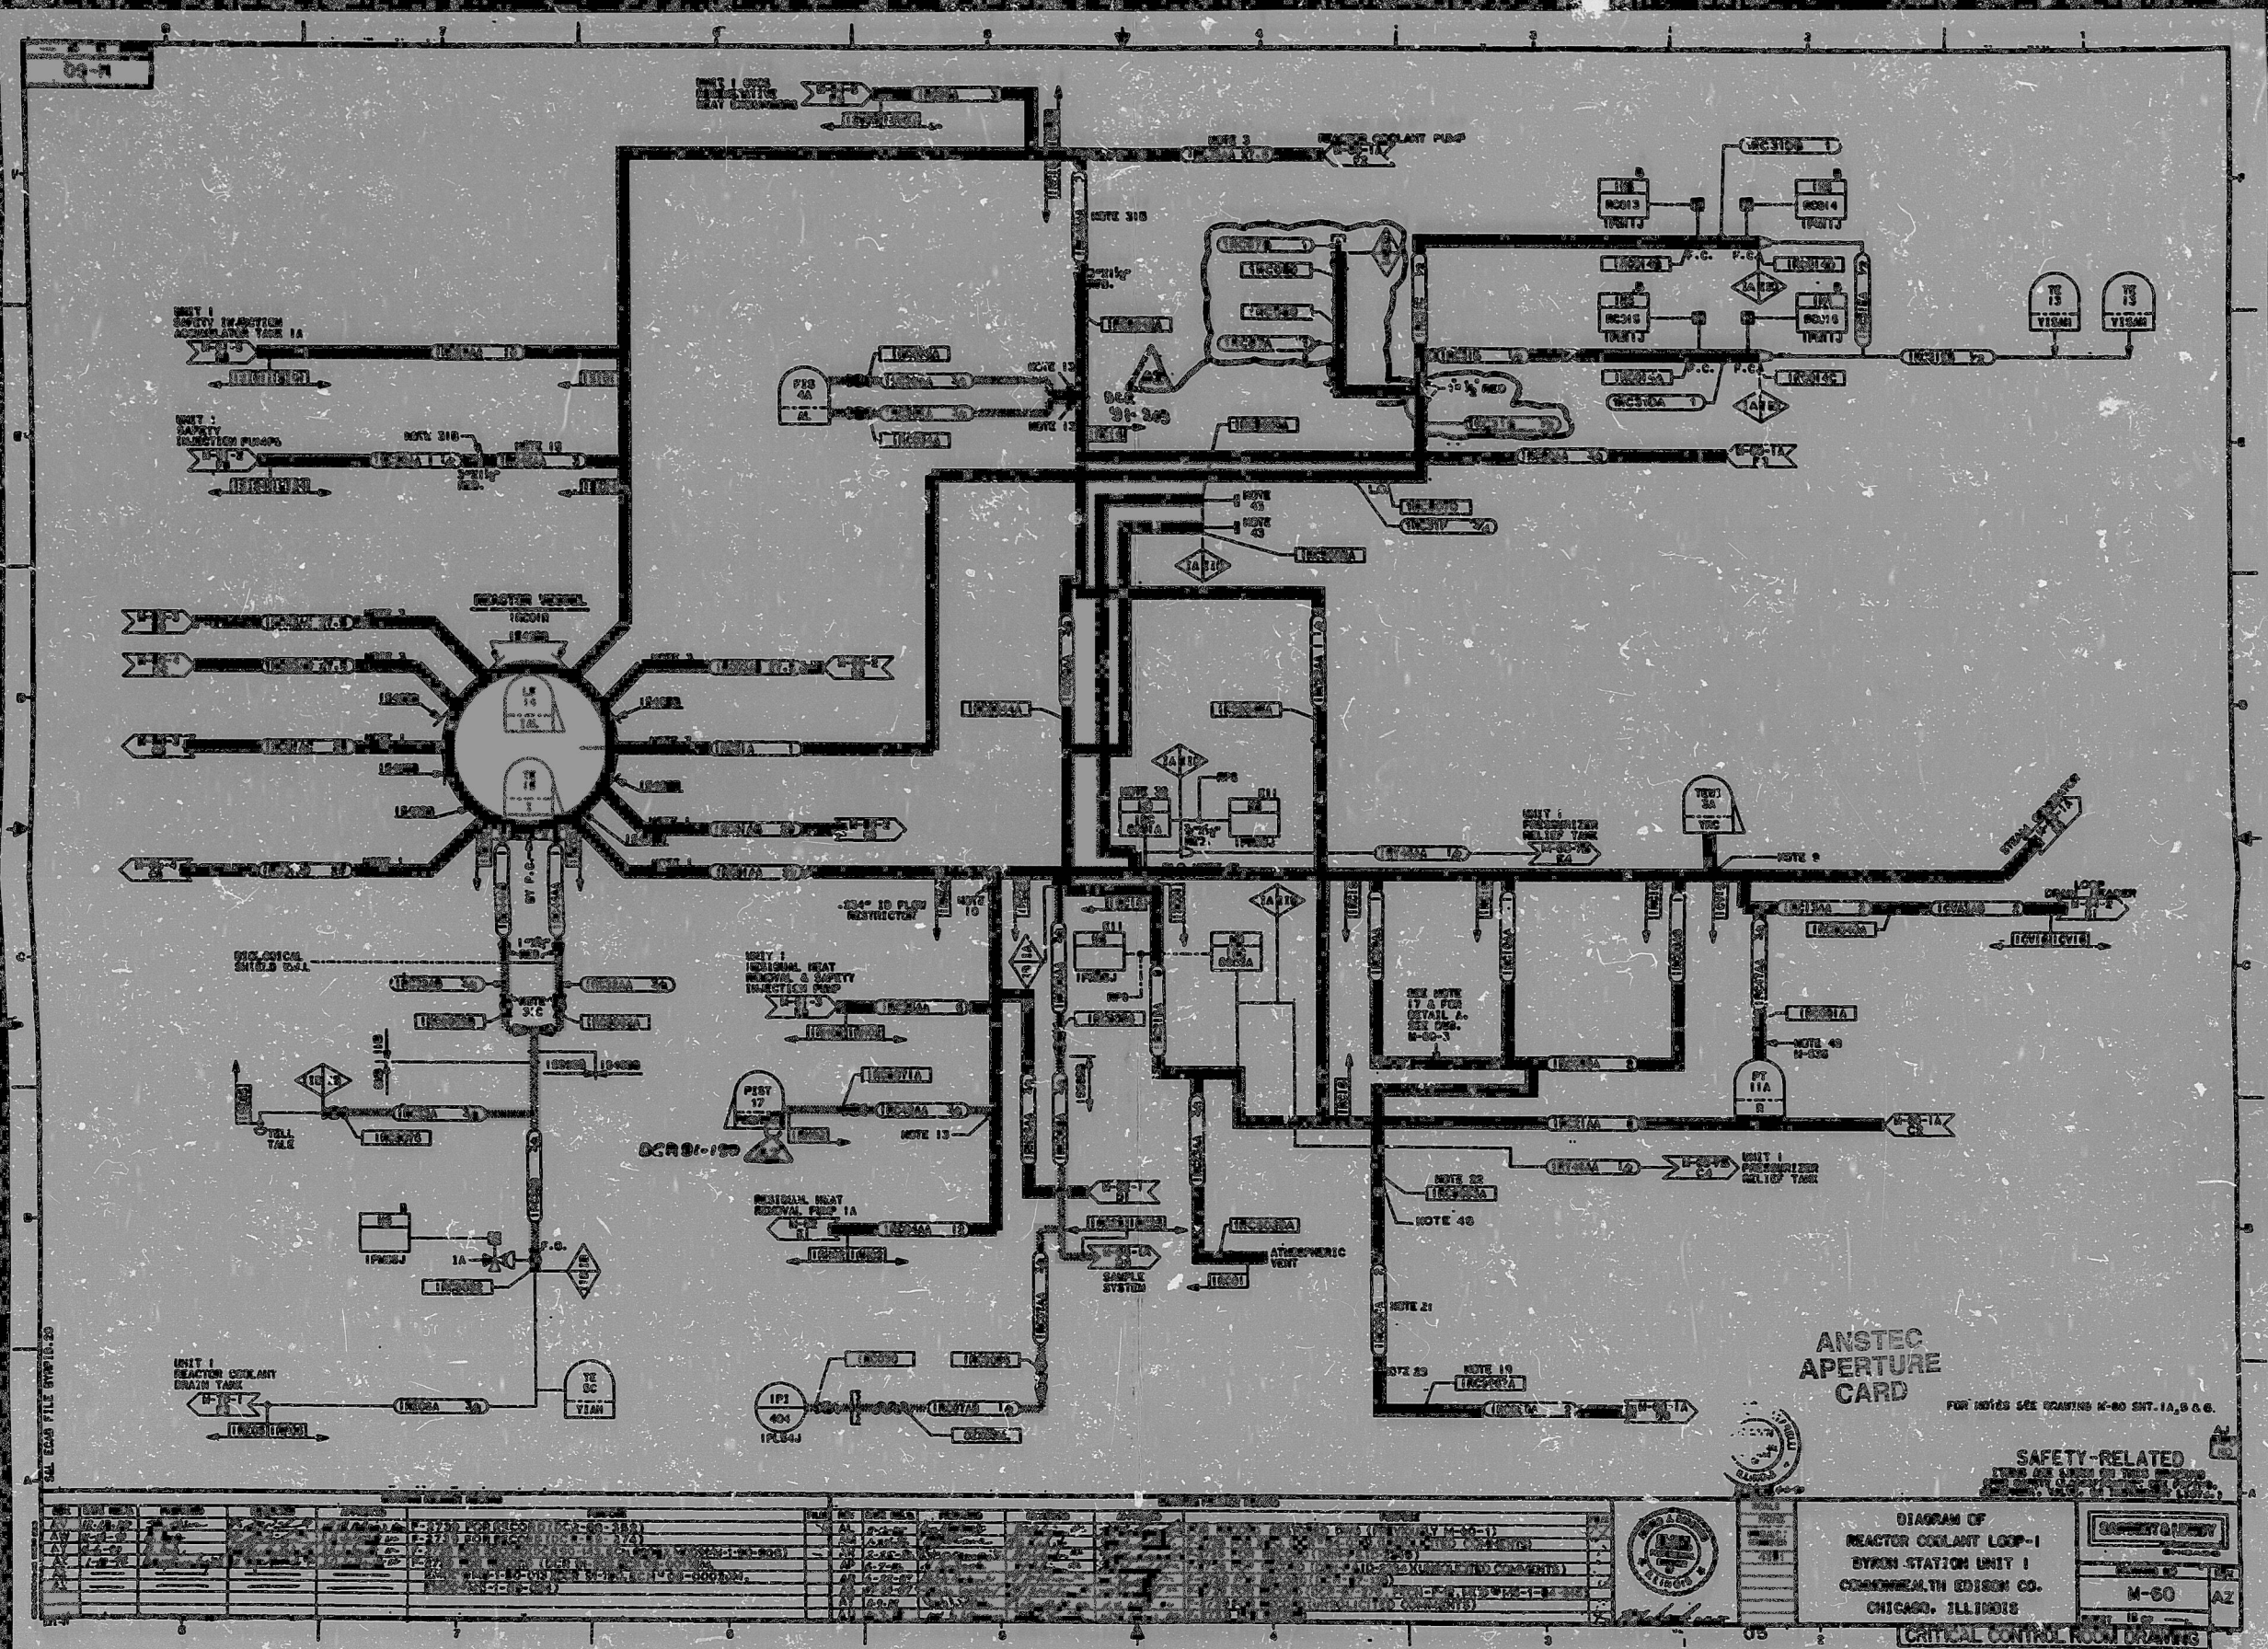

MC



PDR RIDS

9603270311

