


**SAFETY RELAYS**  
DO NOT OPERATE ON THIS DRAWING  
FOR THE PURPOSES OF  
OPERATION, MAINTENANCE OR REPAIR

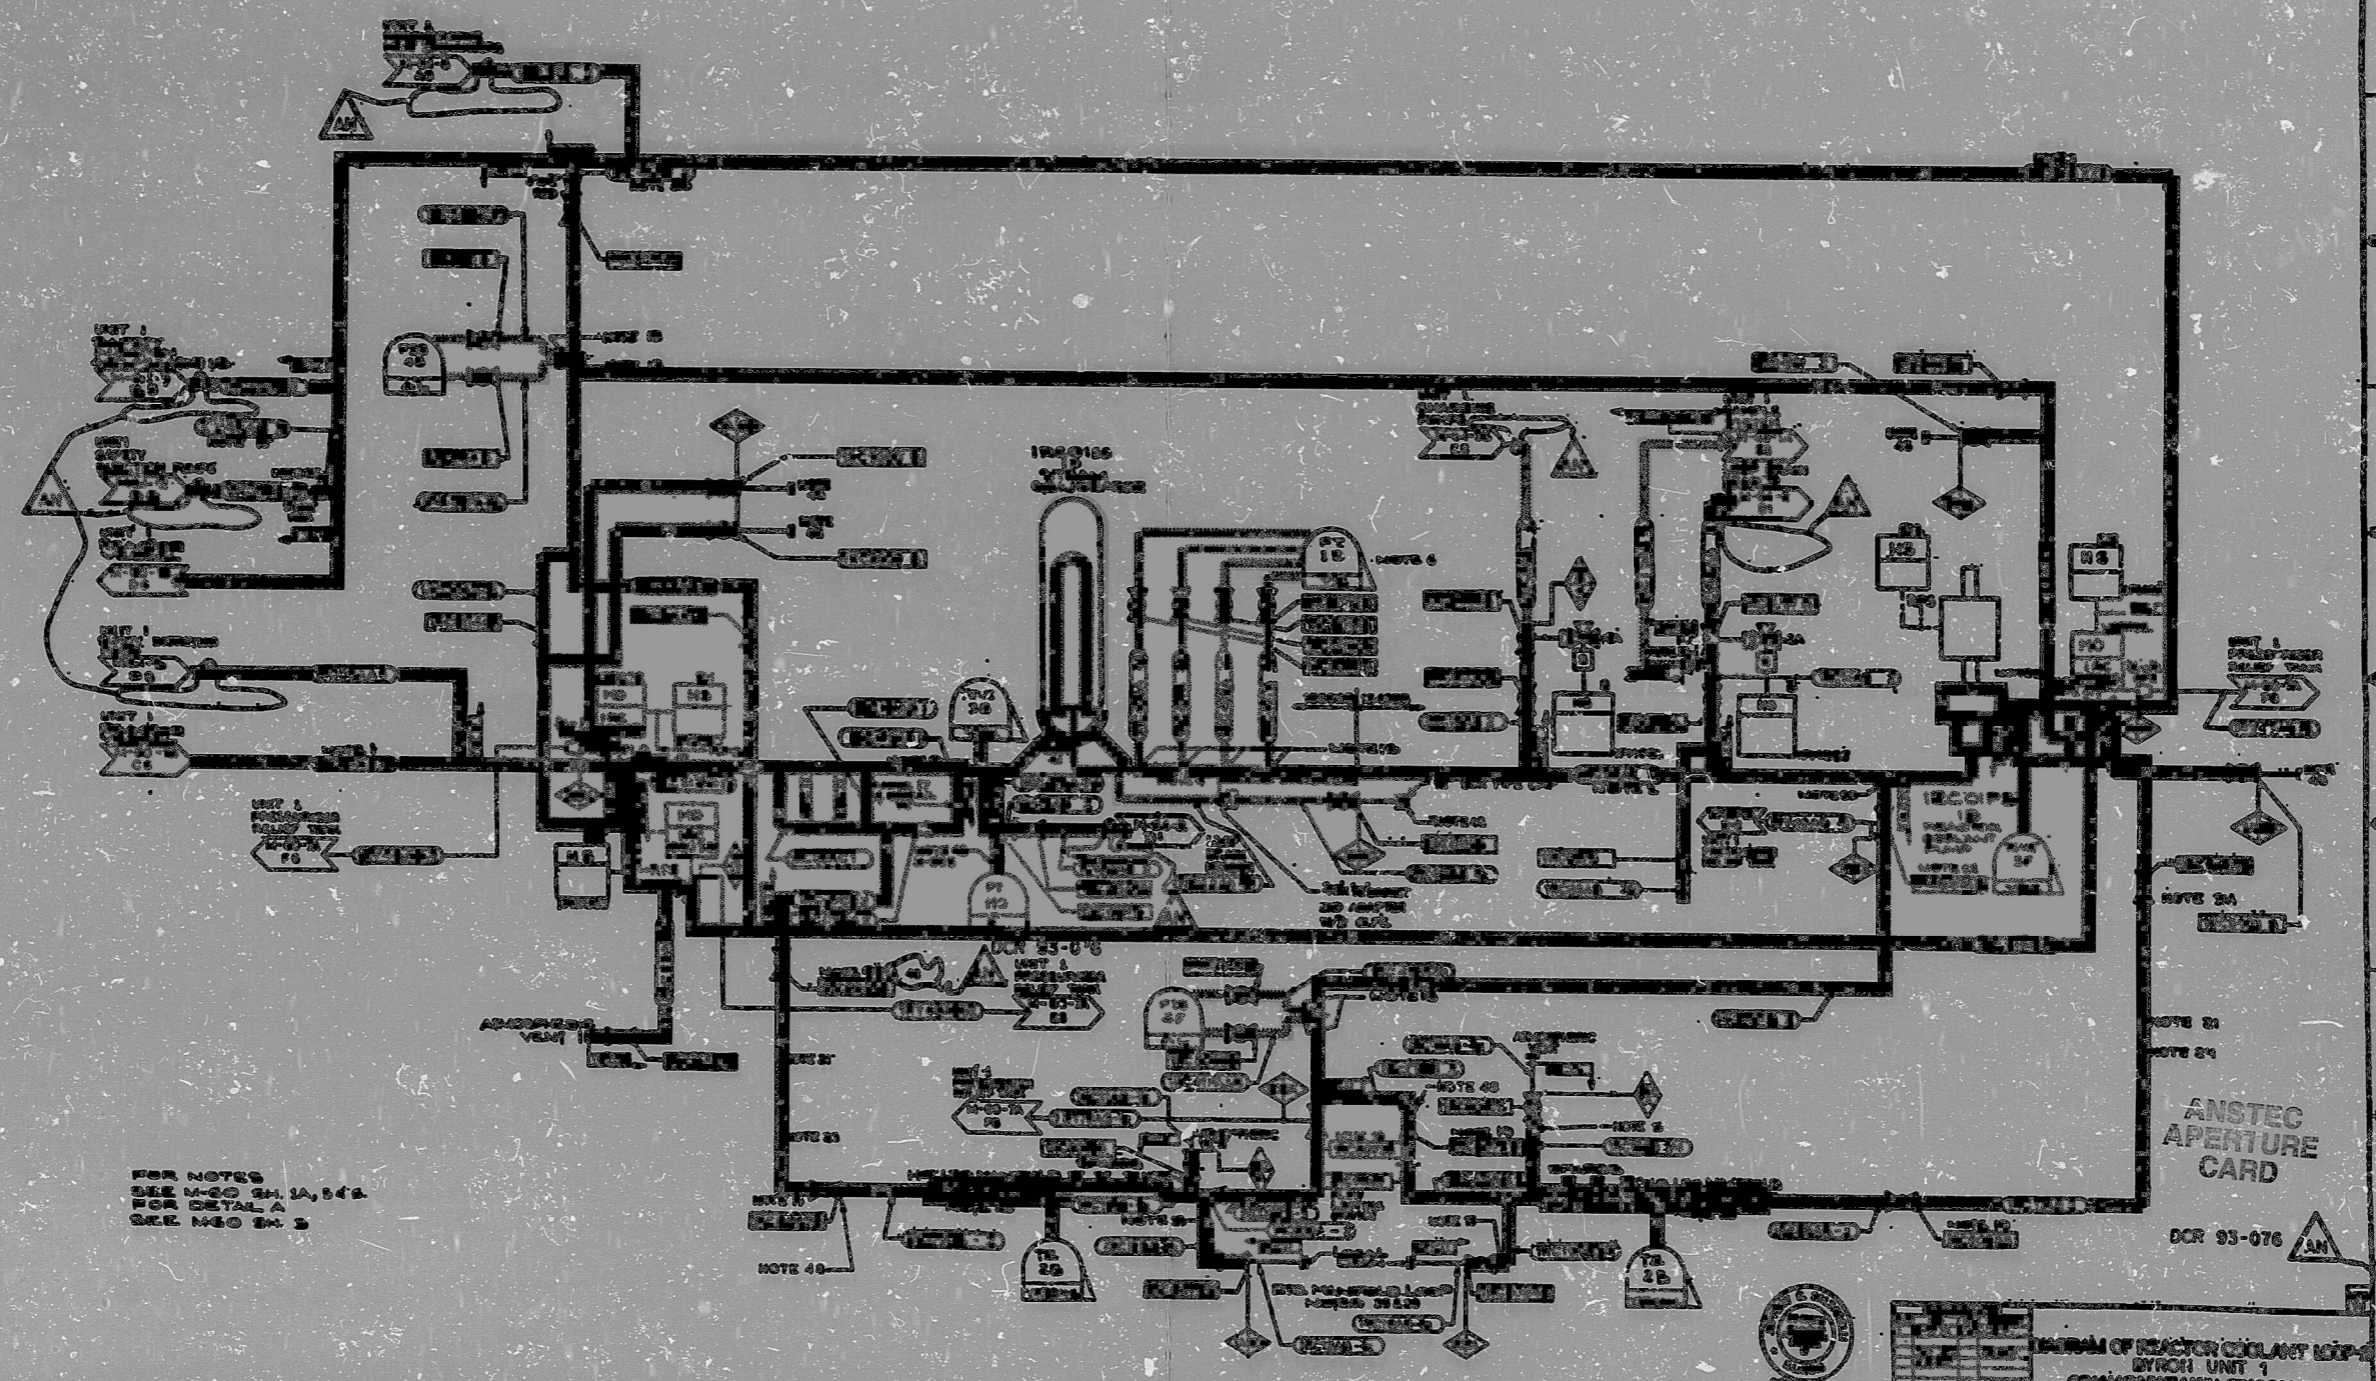

FOR NOTES  

**ANSTEC  
APERTURE  
CARD**

DCR 93-076

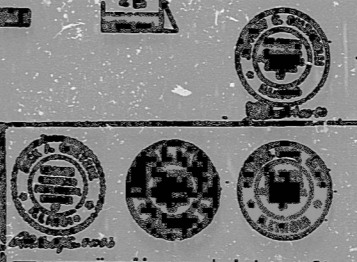


DIAGRAM OF REACTOR COOLANT LOOP  
BYRON UNIT 1  
CHICAGO, ILLINOIS

CRITICAL CONTROL ROOM DRAWING

BC



PDR RIDS

9603270314

