


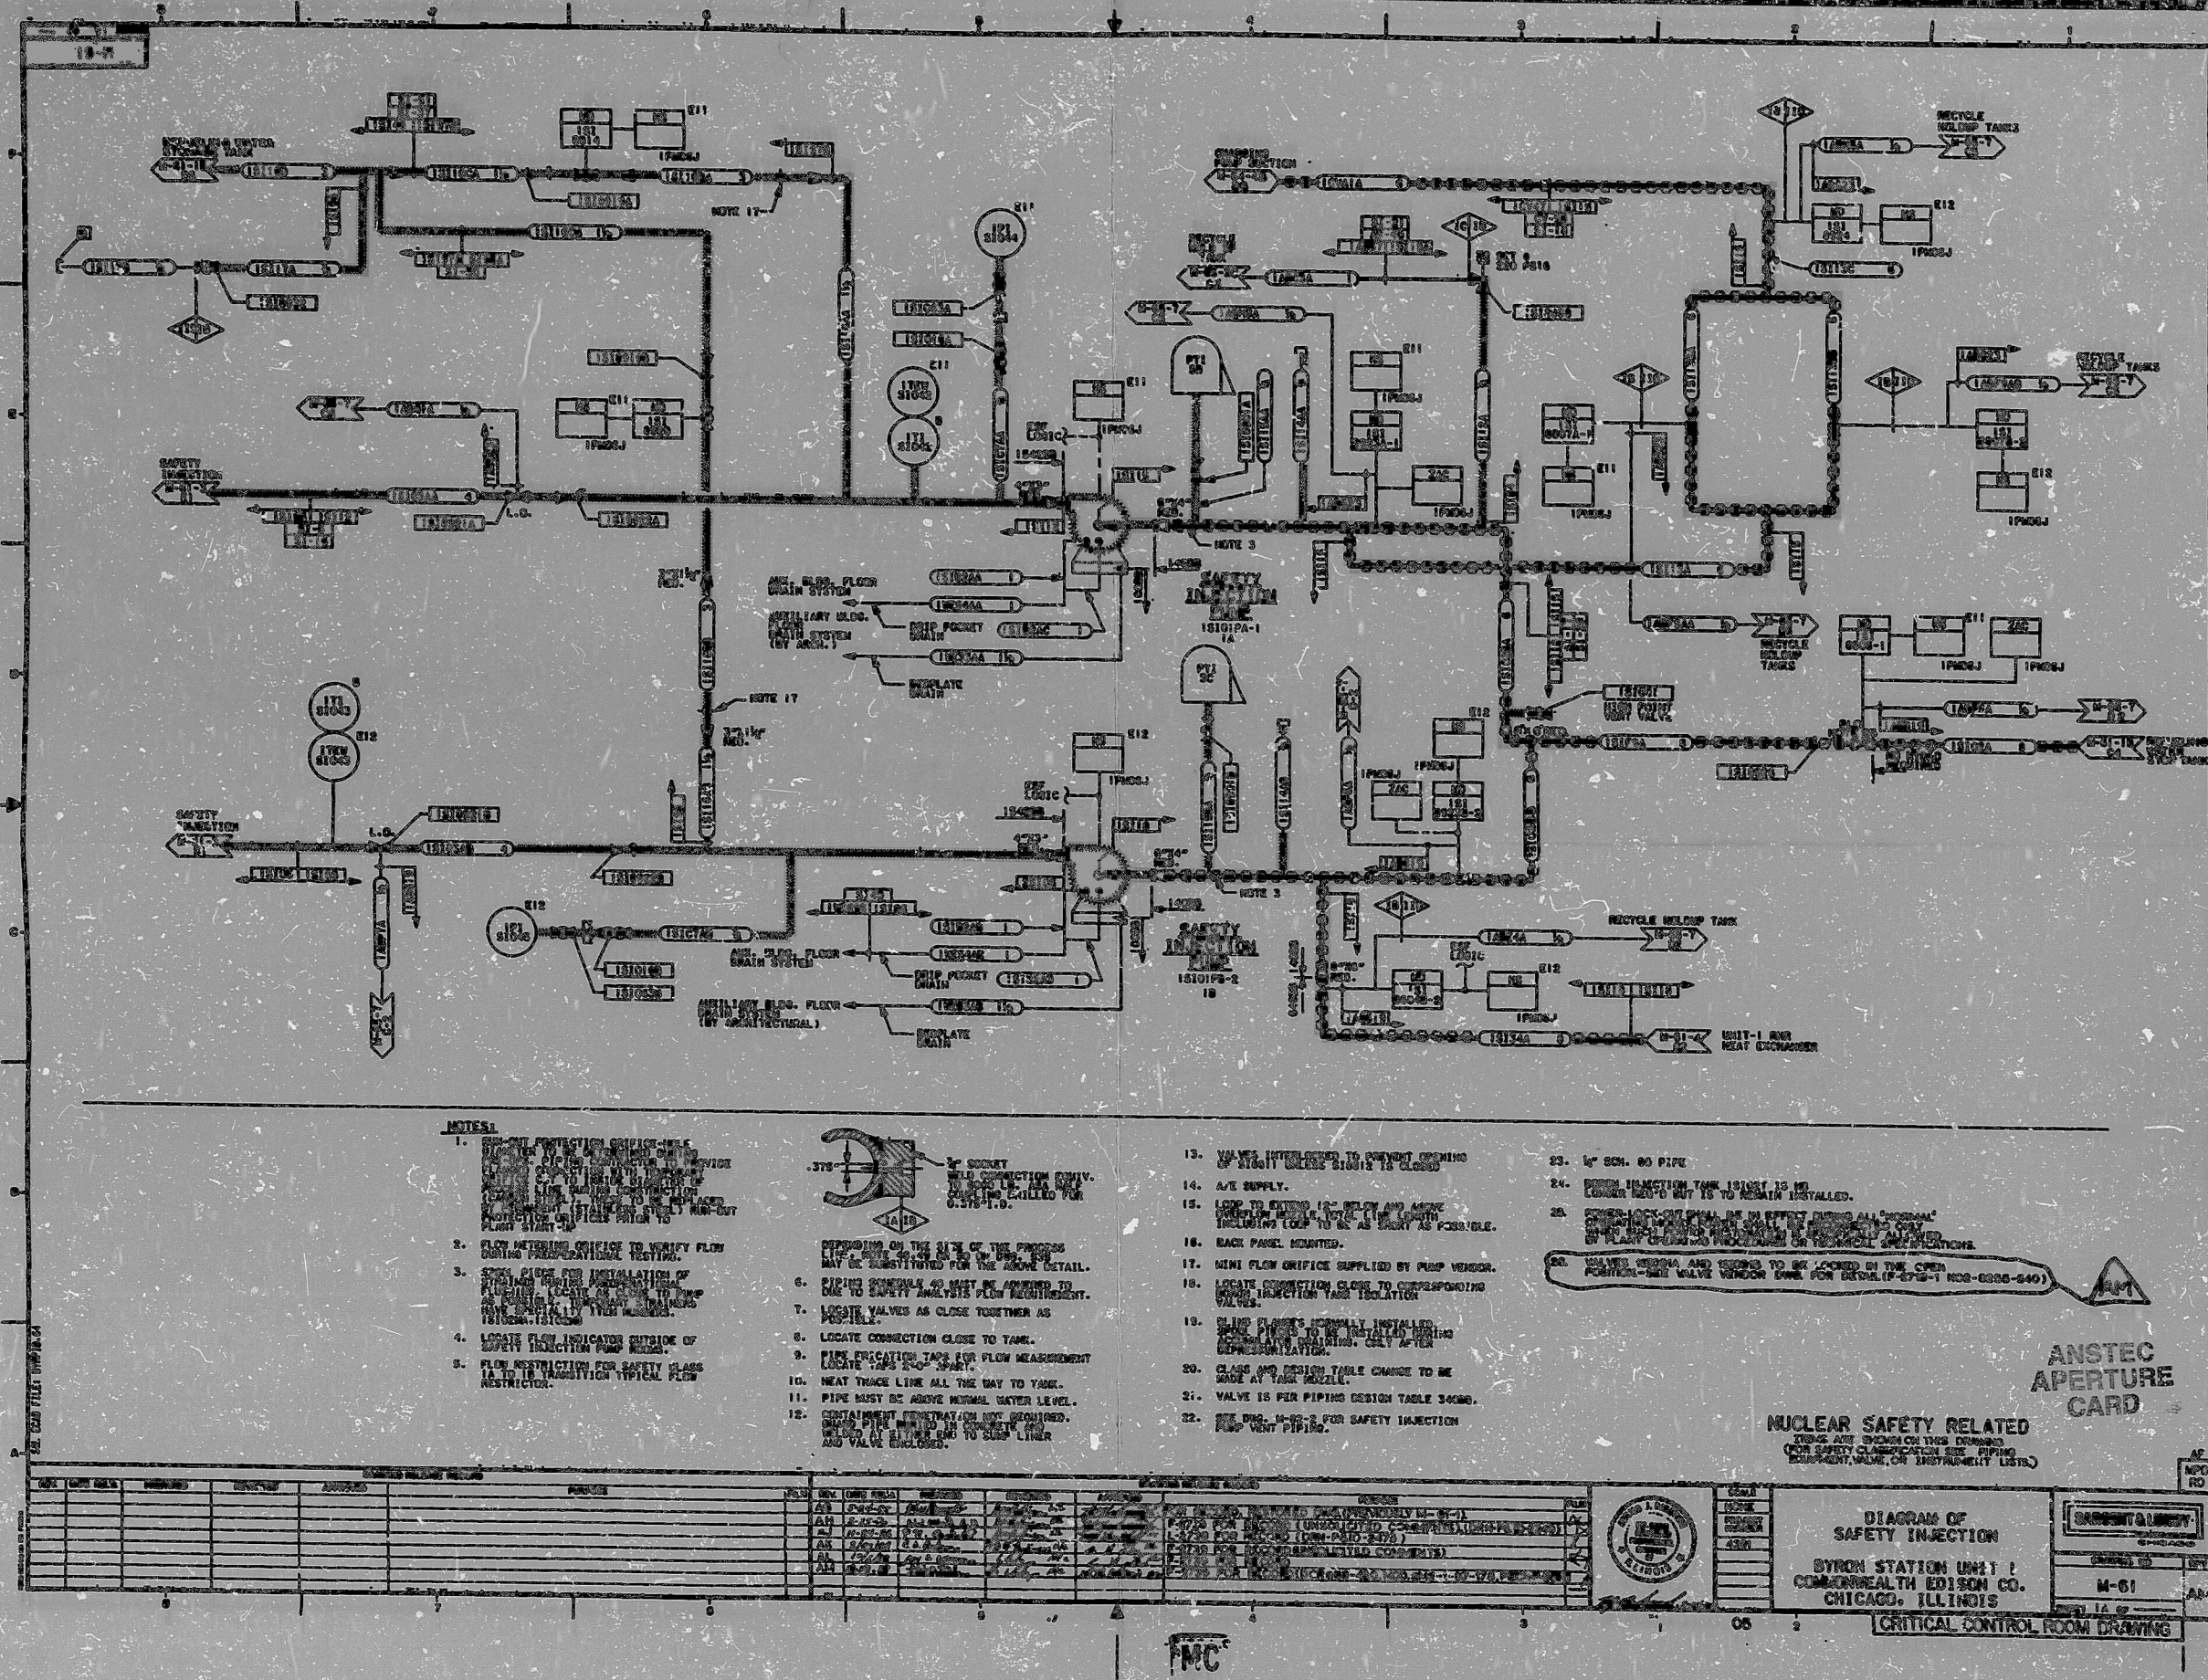

PDR RIDS

9603280039

