


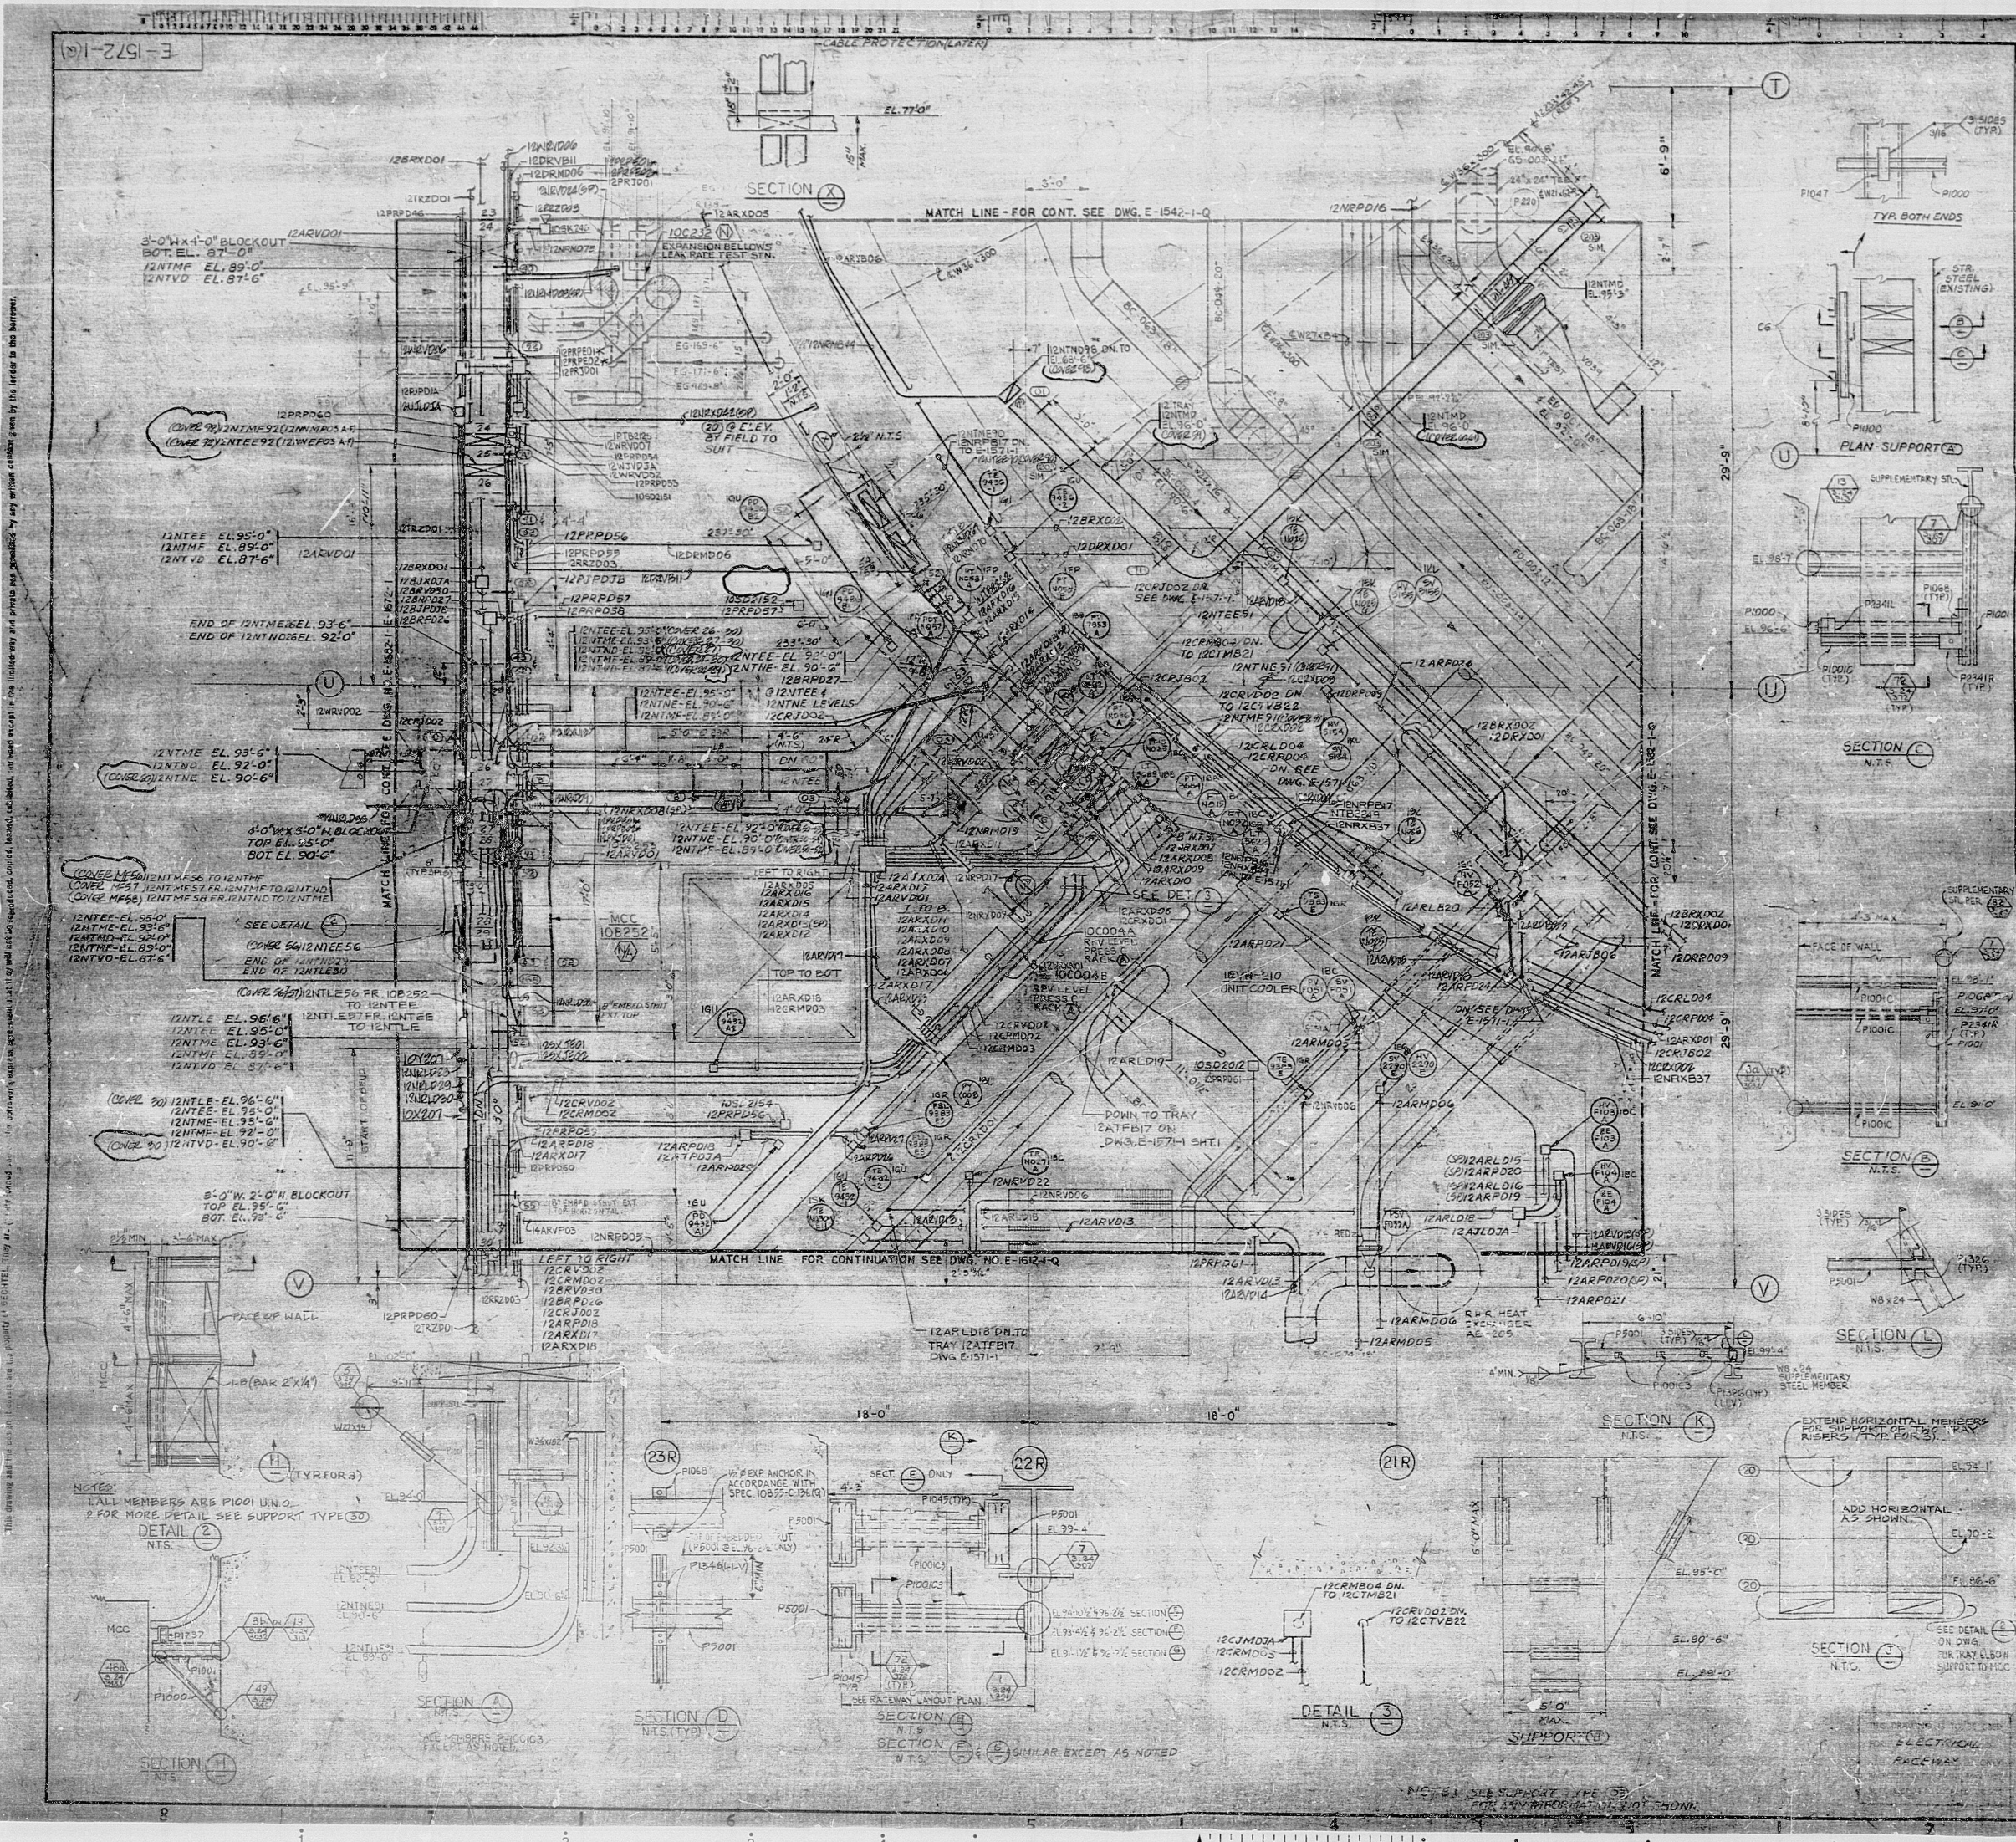



- NOTES:
1. ALL CABLE TRAYS ARE 24" UNLESS SHOWN OTHERWISE.
 2. CLASS 1E RACEWAY-TRAY 4 CONDUIT ETC. ARE IDENTIFIED FOR 10' LISTED INSTALLATION BY LETTERS A, B, C, D, W, X, Y OR Z, IN THIRD CHARACTER OF THE RACEWAY NUMBER.
 3. FOR INSTALLATION DETAIL OF NON-STANDARD ELBOWS FOR CABLE TRAYS, SEE DWG. E-1406, SHT. 2, 3, 4, 5, 6, 7.
 4. ALL FIRE DETECTORS ARE MOUNTED ON THE CEILING.

- REFERENCE DRAWINGS
- P-2102-1 PIPING
 - C-0509-1 CIVIL - STRUCTURAL
 - P-9212-1 HEATING & VENTILATION
 - P-8212-1 PLUMBING
 - E-1406-0 RACEWAY NOTES, SYMBOLS & DETAILS
 - C-0537-1 FLOOR ELEVATION 102-0
 - P-0042-1 EQUIPMENT LOCATION
 - C-0880-1 WALL DRAWING-NORTH
 - C-0803-1 FLOOR FRAMING-EL 102-0
 - J-2102-1 INSTRUMENT LOCATION

REVISIONS											

RECHTEL
SAN FRANCISCO

PUBLIC SERVICE ELECTRIC AND GAS COMPANY
HOPE CREEK GENERATING STATION

RACEWAY PLAN
REACTOR BUILDING-AREA 21
PLAN EL. 77'-0"

JOB NO.	DRAWING NO.	REV.
10955	E-1572-1	20

DL - Mother Date - 304241

PDR RIDS

8602270157

