


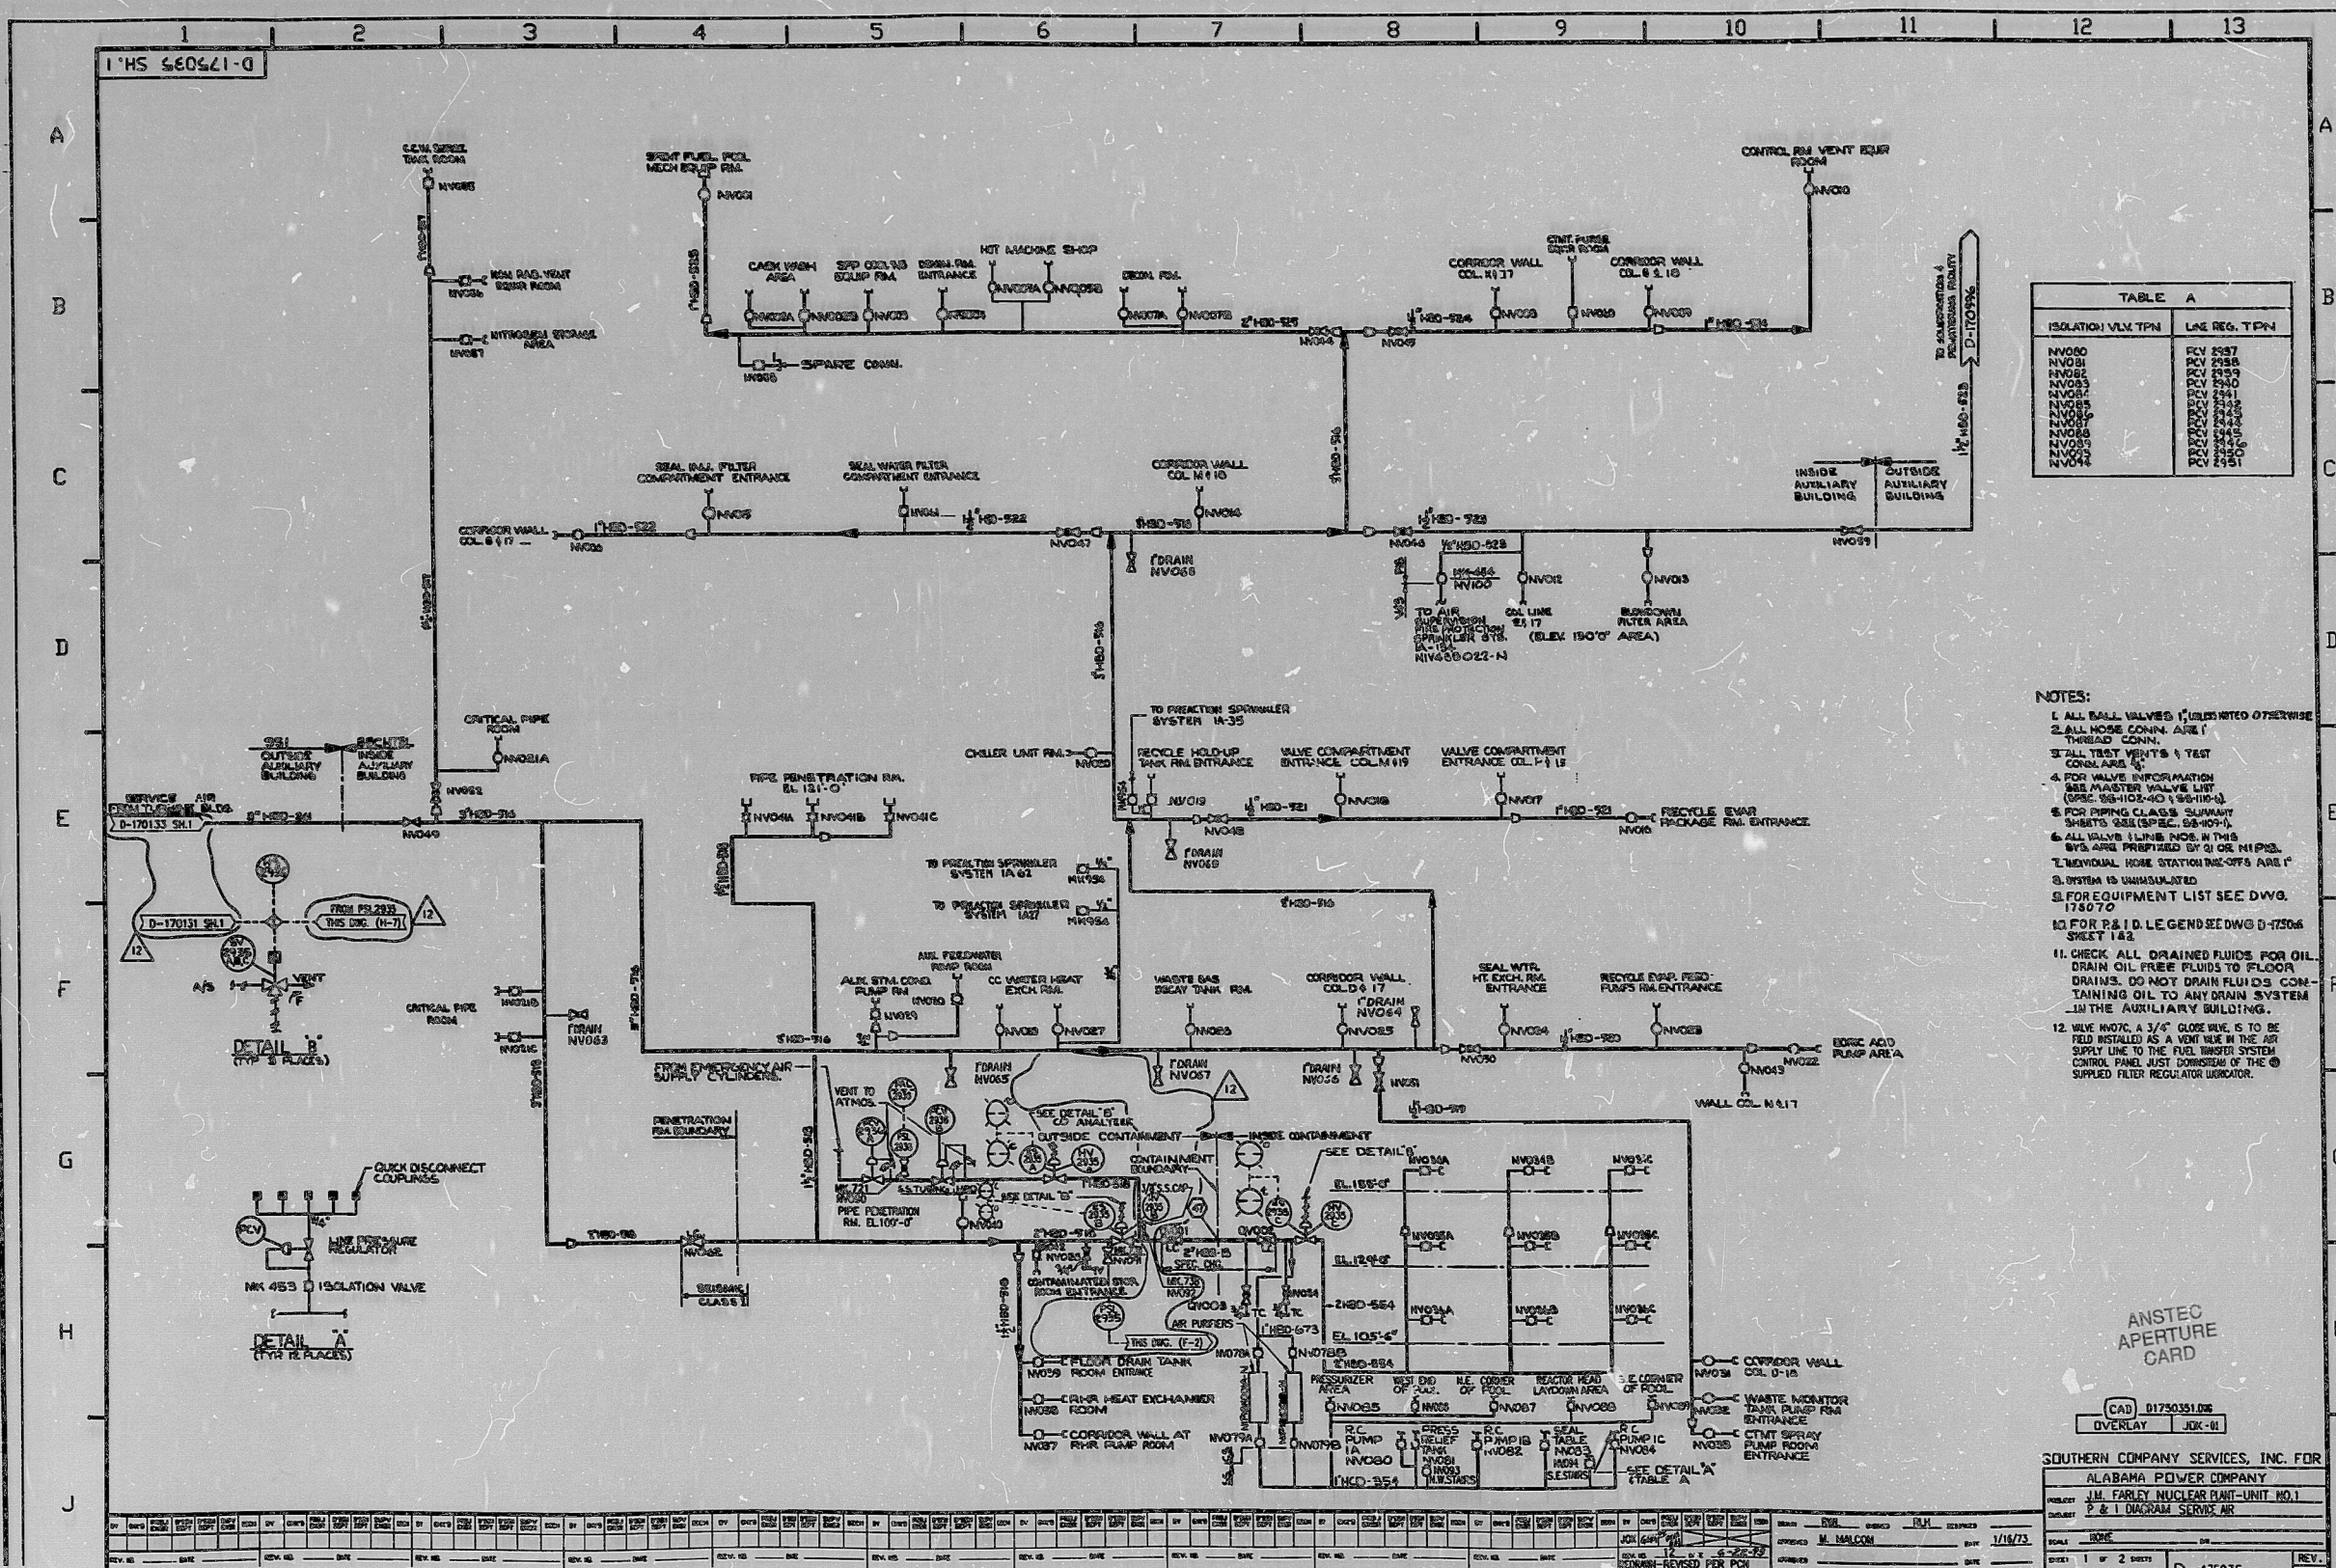

9710010172

PDR RIDS

9710010172

