


AO
VERIFIED
SYS NO

19562

BILL OF MATERIAL									
MAT'L I.D.	QUANTITY	MATERIAL CLASS	TYP	ASME OR ASTM GRADE	DESCRIPTION	CONST.	SIZE	SCH.	LOT NO.

FOR INFORMATION ONLY

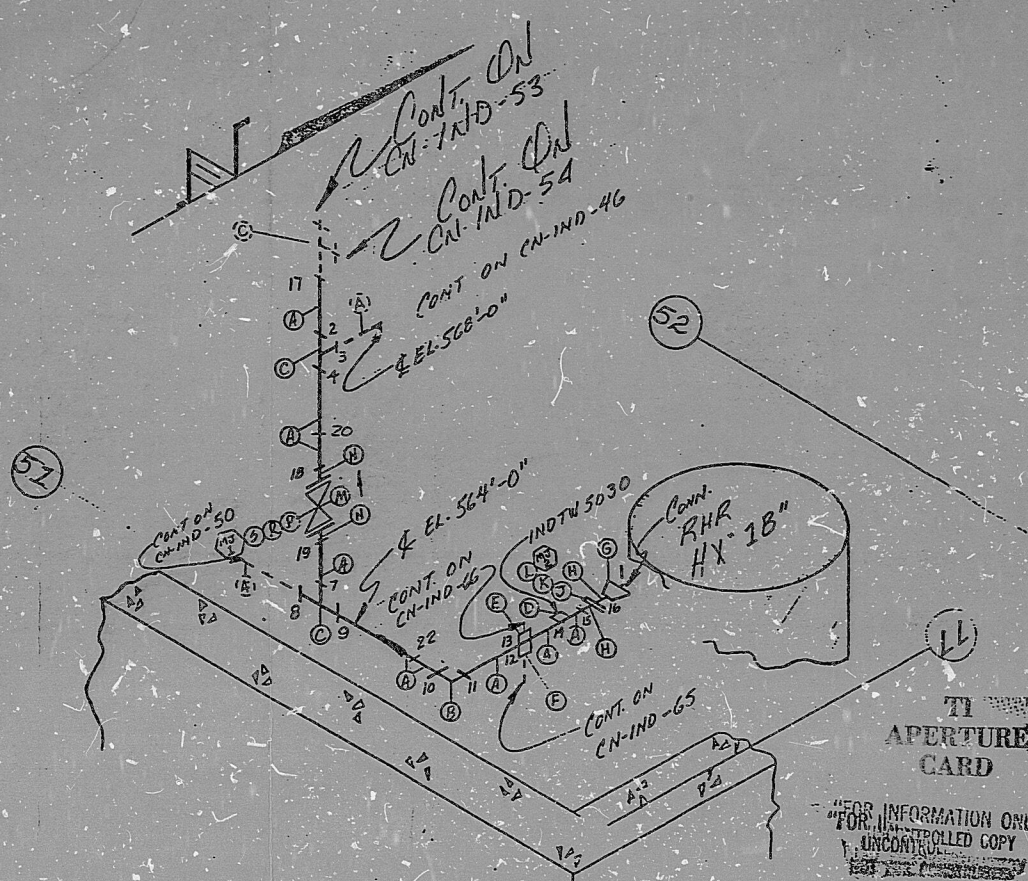

TI
APERTURE
CARD

FOR INFORMATION ONLY
UNCONTROLLED COPY

- NOTES:
- 1 ALL WELD NUMBERS SHALL BE PRECEDED BY IND 64-
 - 2 LAST WELD NO. 22
 - 3 REF. LAYOUT DWG. CN-1492-ND028/IN# 1352
 - 4 REF. FLOW DWG. 1561-1.1 (G-4)
 - 5 ALL MECH. JOINTS SHALL BE PRECEDED BY IND 64-

NO.	REVISION	DATE	NO.	REVISION	DATE

NUCLEAR SAFETY RELATED		NO.
DUKE POWER COMPANY		1
CATAMBA NUCLEAR STATION		1
TITLE		RESIDUAL HEAT REMOVAL SYSTEM
SYS. NO.		02
LINE NO.		02
PIPE SPEC.		601.2
LOCATION		AP. 2.06 (A-50)
DWG. NO.		CN-IND-64
REV. NO.		13

PDR RIDS

8809070114

