

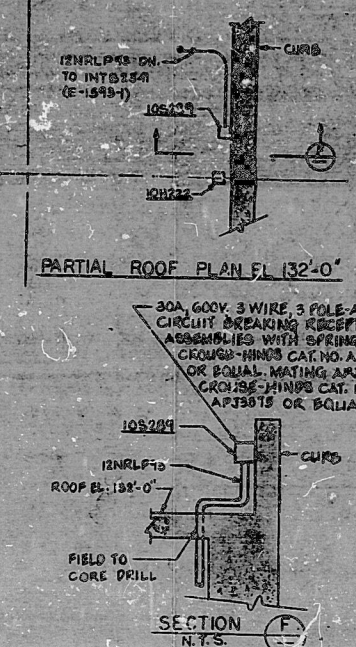
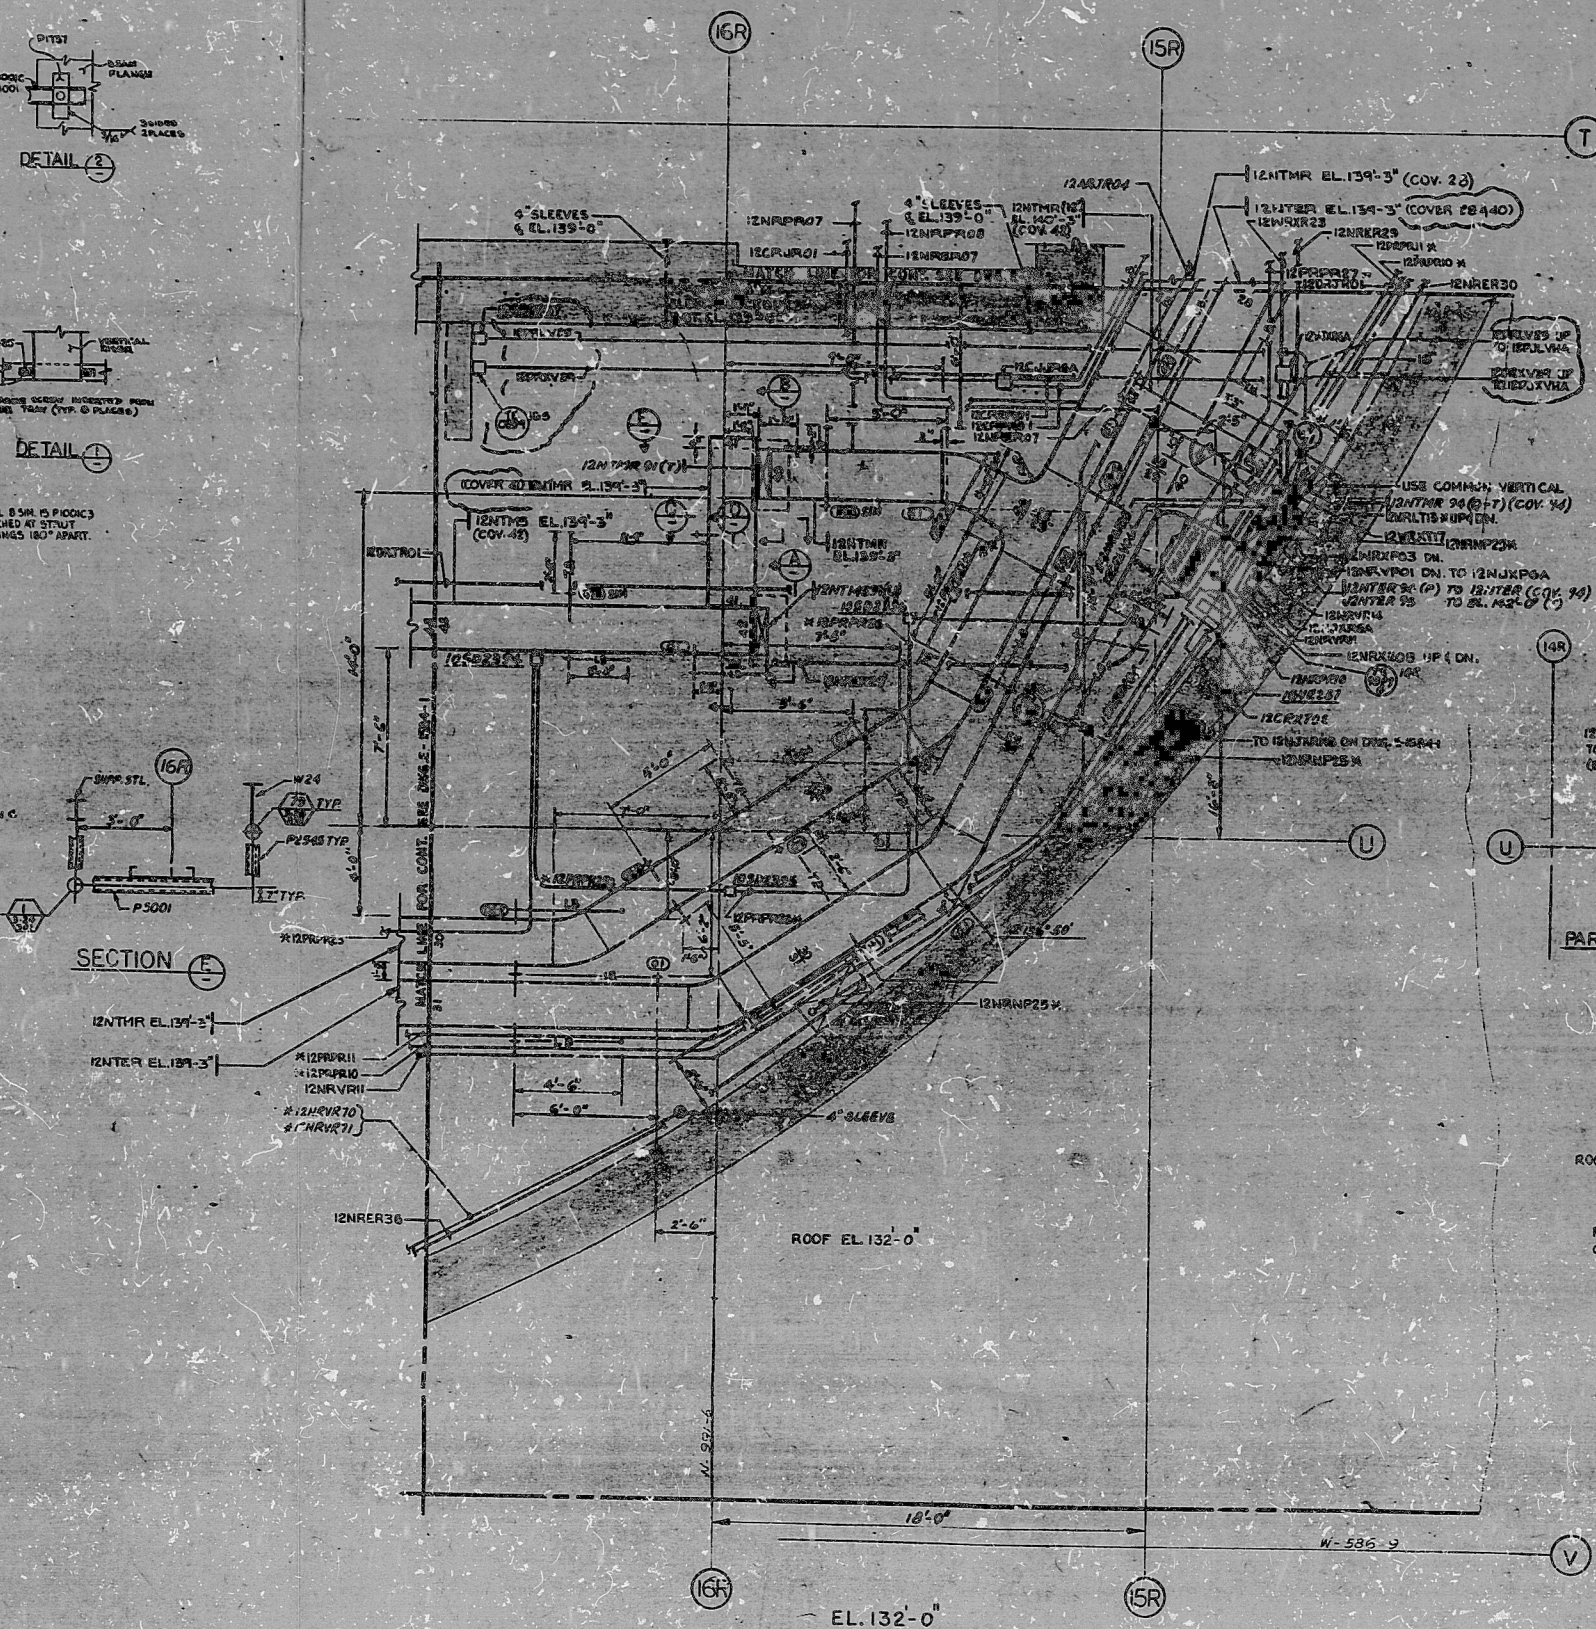
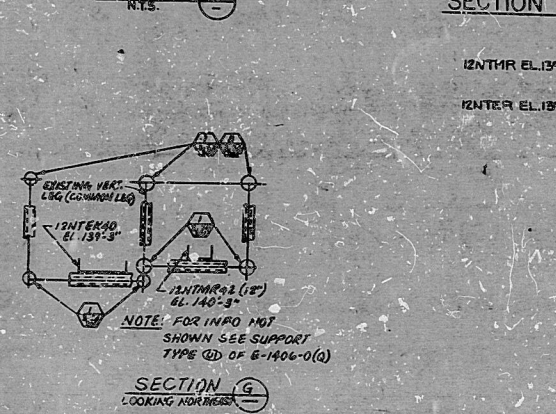
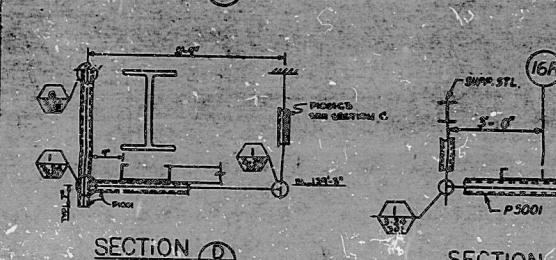
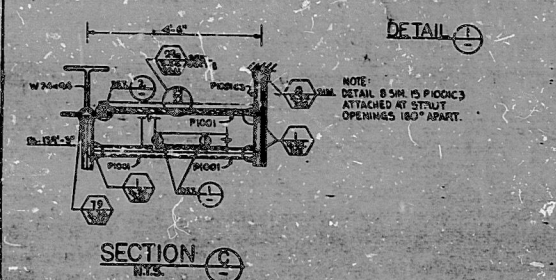


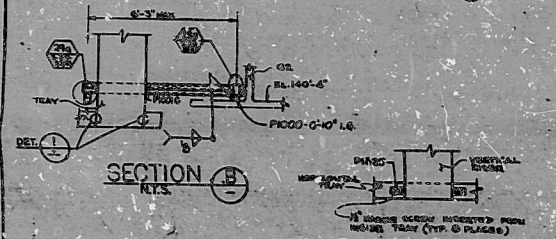

- <

PDR RIDS

8602270270

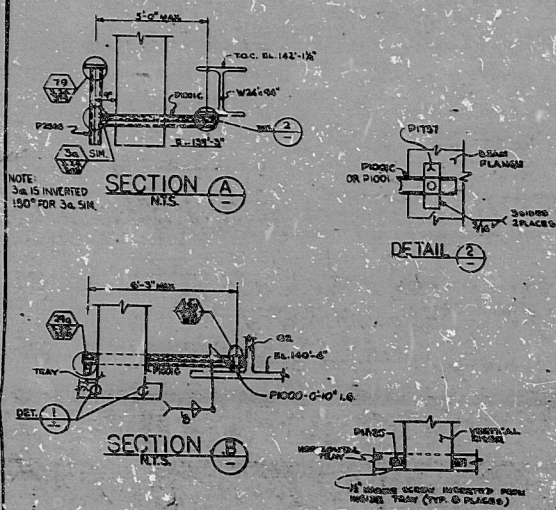