


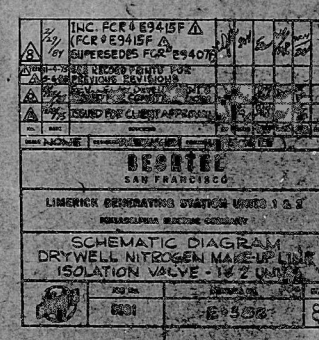



PDR RIDS

8702180394

