


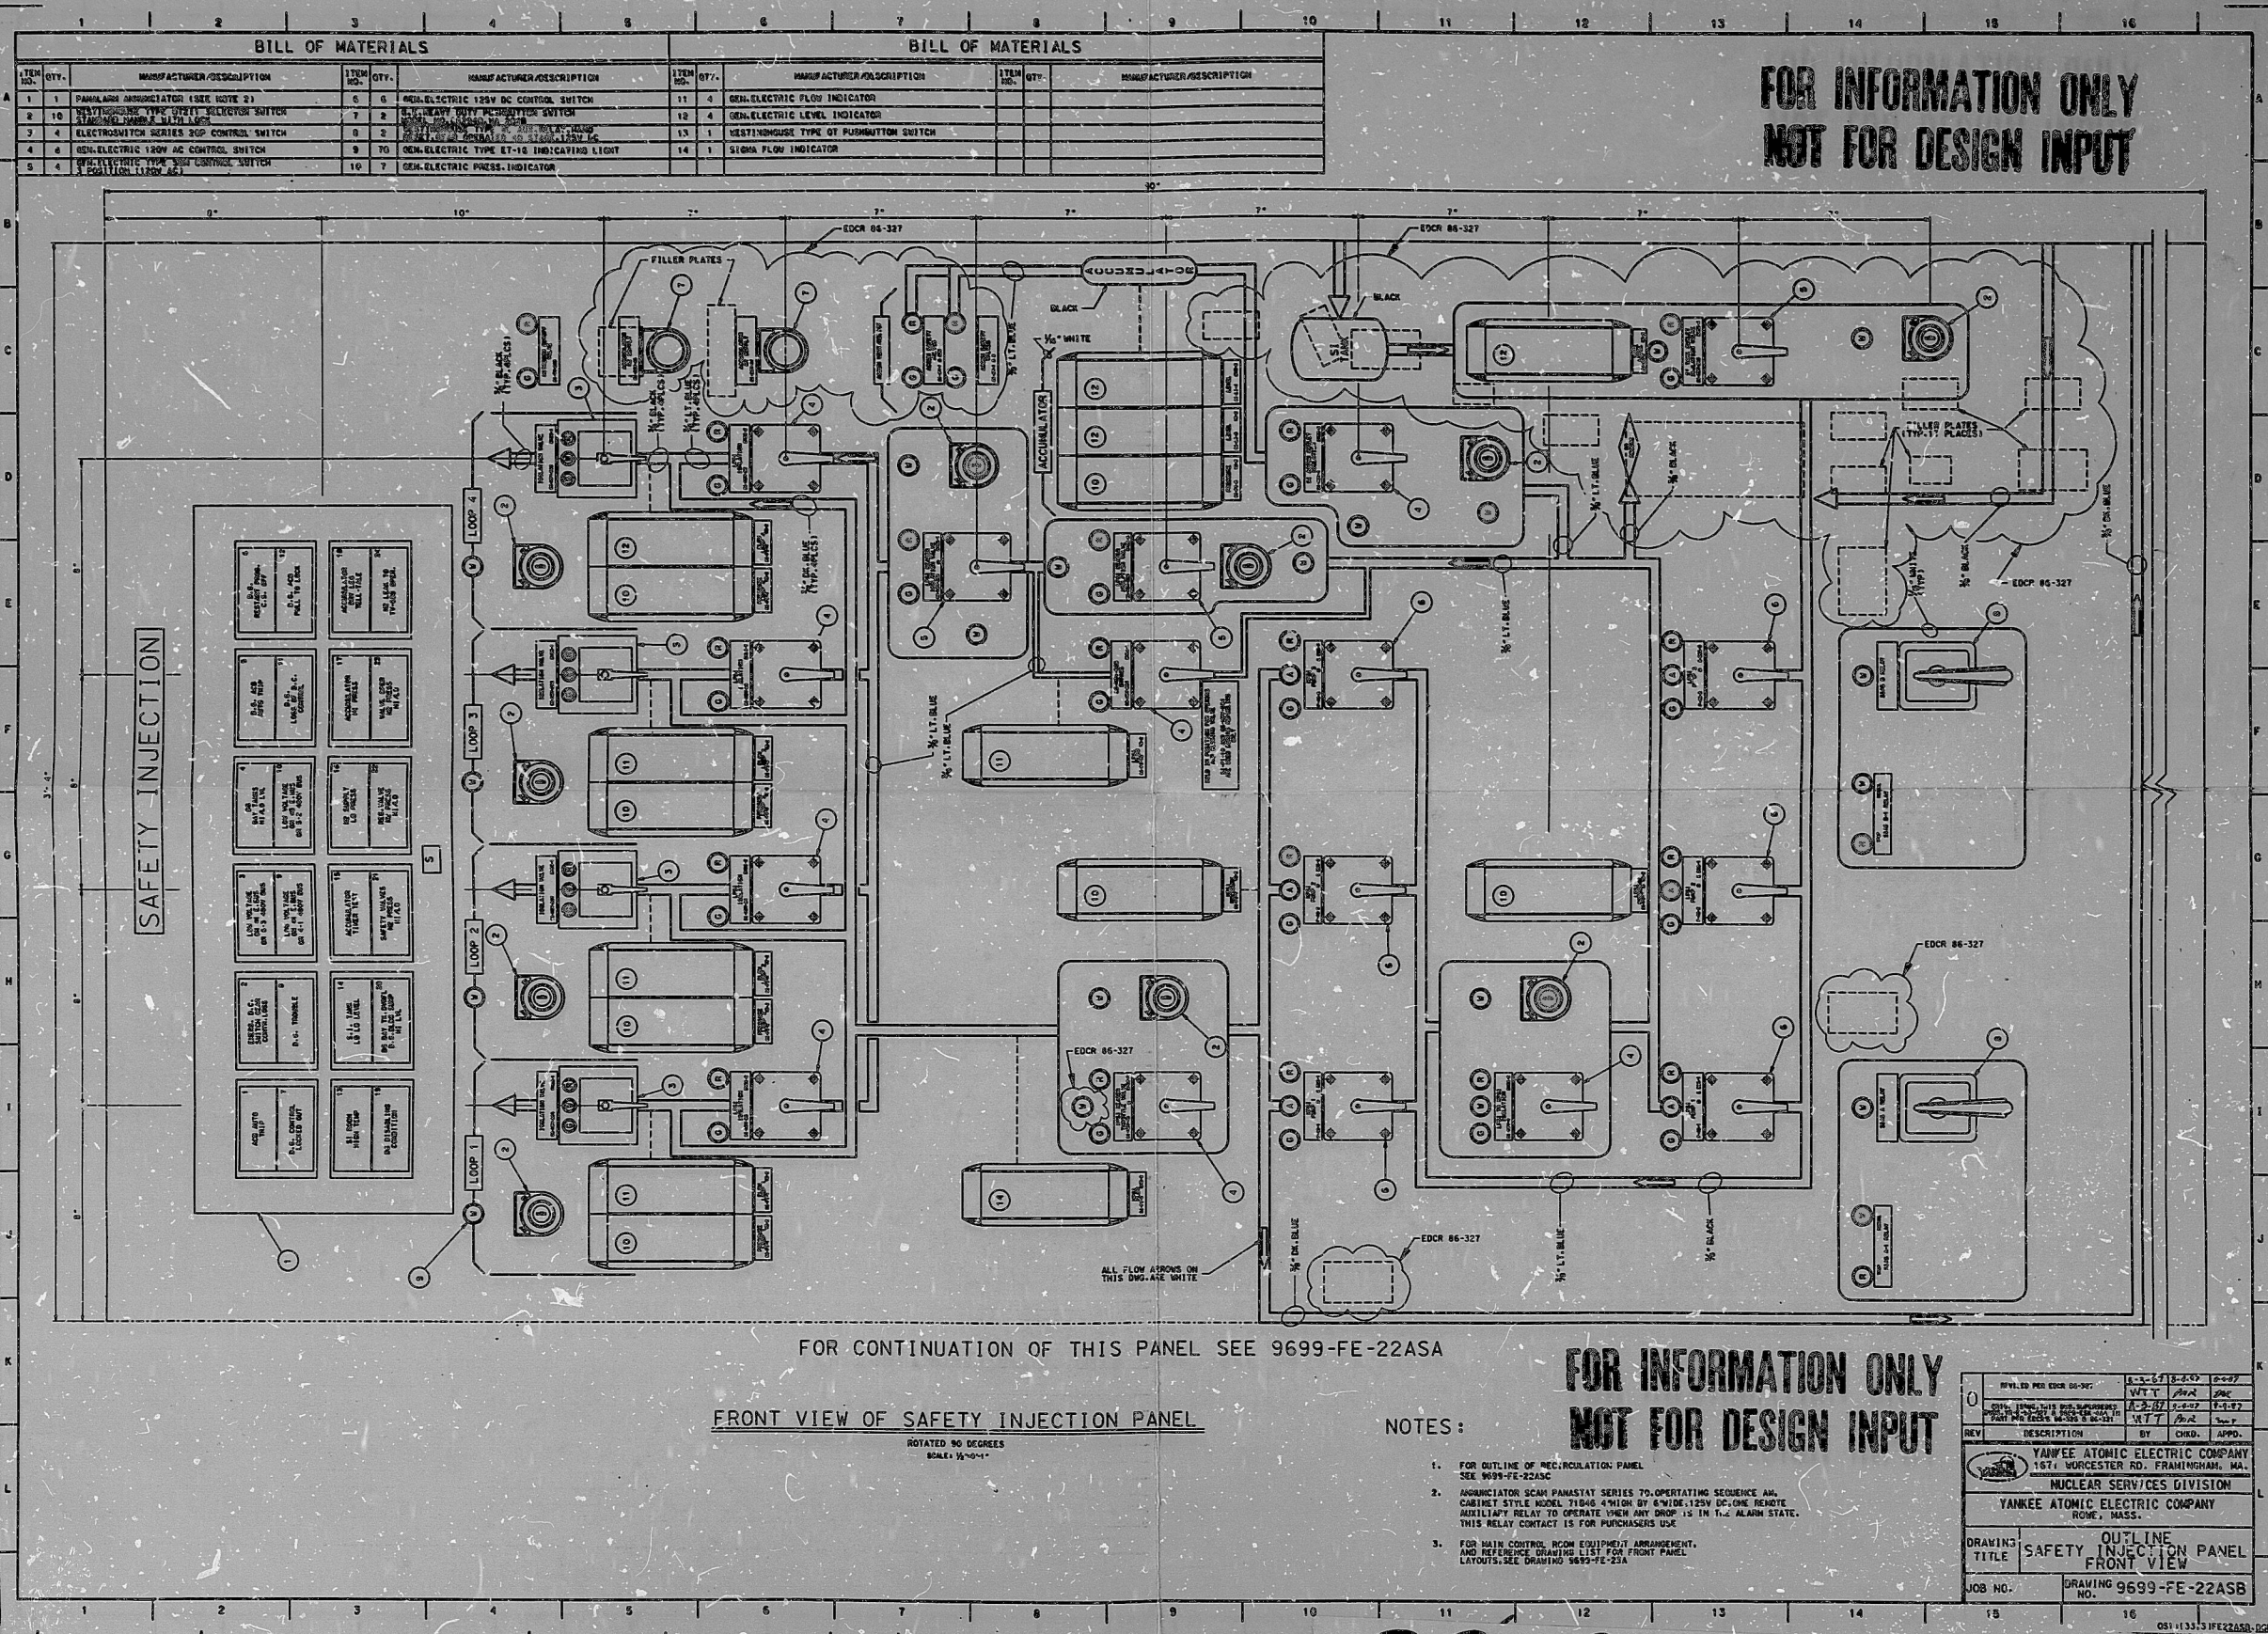

8809070214

ATTACHMENT D
404

PDR RIDS

8809070214

