


HVX ELEC BOUNDARY

12179-EE-1AD

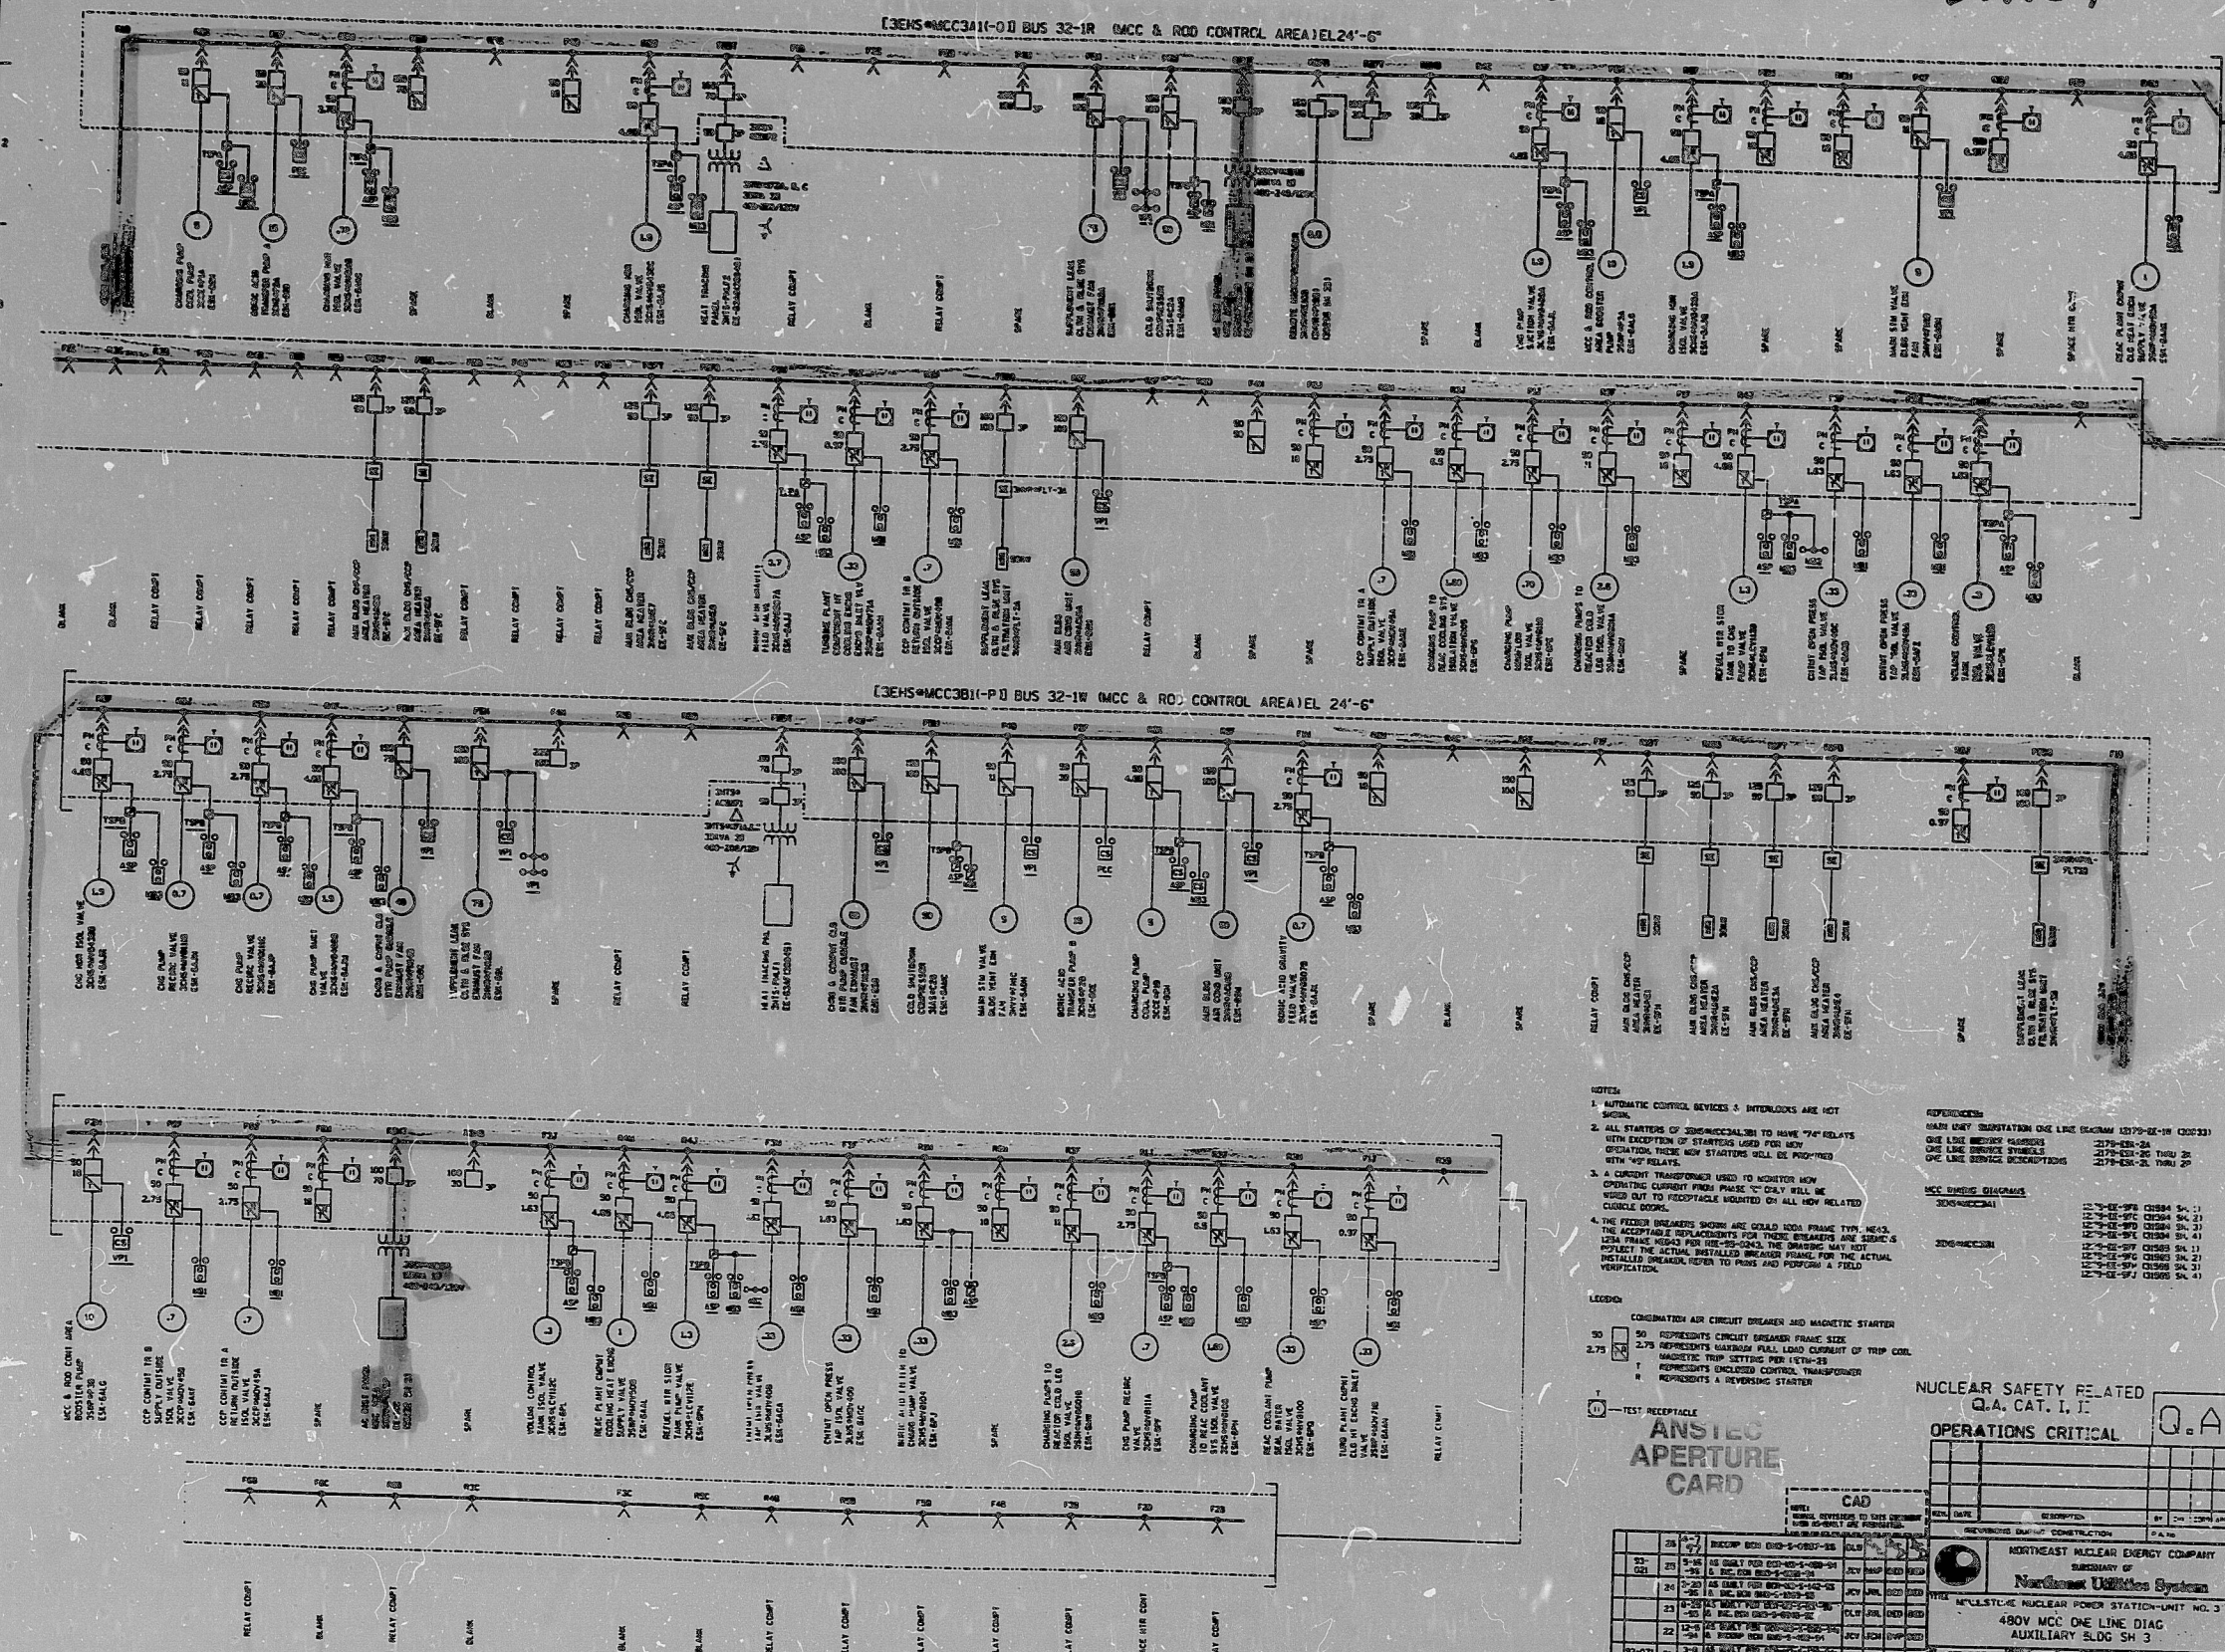

- NOTES:**
1. AUTOMATIC CONTROL SERVICES & INTERLOCKS ARE NOT SHOWN.
- LEGEND:**
- CONNECTION AND CIRCUIT BREAKER AND MAGNETIC STARTER
- 50 REPRESENTS CIRCUIT BREAKER FRAME SIZE
- 275 REPRESENTS MAGNETIC FULL LOAD CURRENT OF TRIP COIL
- MAGNETIC TRIP SETTING FOR 175-25
- REPRESENTS DISCONNECT TRANSFORMER
- REPRESENTS A REVERSING STARTER
- TEST RECEIPTABLE**
- ANSTEAC APERTURE CARD**

NUCLEAR SAFETY RELATED
Q.A. CAT. I, II
OPERATIONS CRITICAL

CAD		REVISIONS	
NO.	DATE	DESCRIPTION	BY

S&W DWG. NO.12179-EE-1AD

9711030094

PDR RIDS

9711030094b

