


NO
VERIFIED
SYS. 5M

21776

BILL OF MATERIAL									
MAT'L I.D.	QUANTITY	MATERIAL	SPECIFICATION	DESCRIPTION	CONST.	SIZE	NCN	LOT NO.	
A	1	B	CS	ICF062/CK/BH		16"	30	IN 024-234	
B	1	CS		GRINNELL SUPPLIED PIPING & FITTINGS				2N CT-2F-21	
C	1	CS						2N CT-2F-22	
D	0	CS						2N CT-2F-23	
E	1	CS						2N CT-2F-24	
F	0			PENETRATION				2N-1M-422	
G	2	B	CS SA105	HALF COIL SN	FORGED	1"	6000#	3N IFN410B010	
H	4	CS	SA105	ALIGNMENT BARS		6"x4"		3N REL 705	
J	7	B	CS SA105	ACCESS HOLE PLUG	FORGED	1 1/2"		2N CT-7037	
K	2	B	CS SA105	H/CPG	SW FOR	3/4"	6000#	3N IFN410B010	
L	1	B	CS SA106	PIPE	SMLS	1 1/2"	40	1A4A81F08114	
M	1	B	CS SA105	PLUG	SW FOR	3/4"		3N IFN410B010	
N	1	B	CS SA105	H/CPG	SW FOR	1"	3000#	3N IFN410B010	
P	1	B	CS SA105	H/CPG	SW FOR	1"	6000#	3N IFN410B010	
R	1	B	CS SA106	PIPE	SMLS	1"	20	1A4A81F08114	
S	1	B	CS SA105	PIPE CAP	SW FORG.	1"	3000#	3N IFN410B010	
T	1	SS		TRANSDUCER ADAPTER		3/8" x 1/2"		3N PIG 61	
U	1	SS		TRANSDUCER	(THEY)	5/16"		3N F31/3395	
V	0	G	CS A105	CAP	(SW) FOR	1"	3000#	3N IFN410B010	

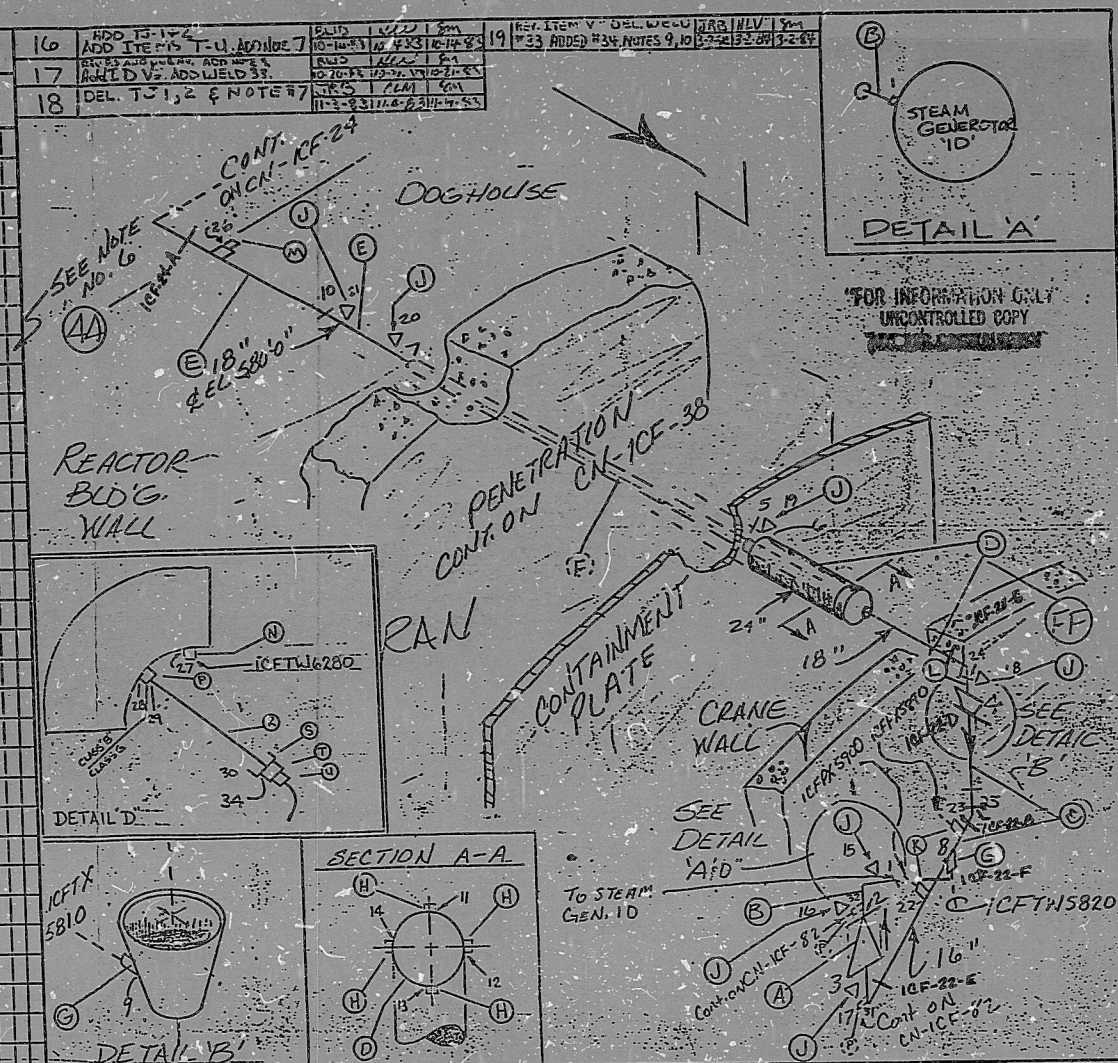

NOTES:
 ① ALL WELD NUMBERS SHALL BE PRECEDED BY ICF 22-
 ② LAST WELD NO. 32
 ③ REF LAYOUT DWG. W41590 C.A. 1291-CE 001 /VN 2764
 ④ REF FLOW DWG. VN2629 VN 2290 VN 2291
 ⑤ P.S. 900.7 APPLIES TO GUARD PIPE ONLY
 ⑥ S.D. REL. 705 MAY BE SUBSTITUTED BY S.D. REL. 706
 ⑦ ALL THREADED JOINTS SHALL BE PRECEDED BY ICF 22-
 ⑧ WELD 33 IS CLASS 'C'
 ⑨ WELD 34 IS A CLASS 'C' SEAL WELD
 ⑩ WELD 35 IS A CLASS 'B' PER EURCMS JURE 38

REV. ITEM						ADD ITEM					
NO.	REVISION	DATE	BY	CHKD	DATE	NO.	REVISION	DATE	BY	CHKD	DATE

PDR RDS

8809070 273

