


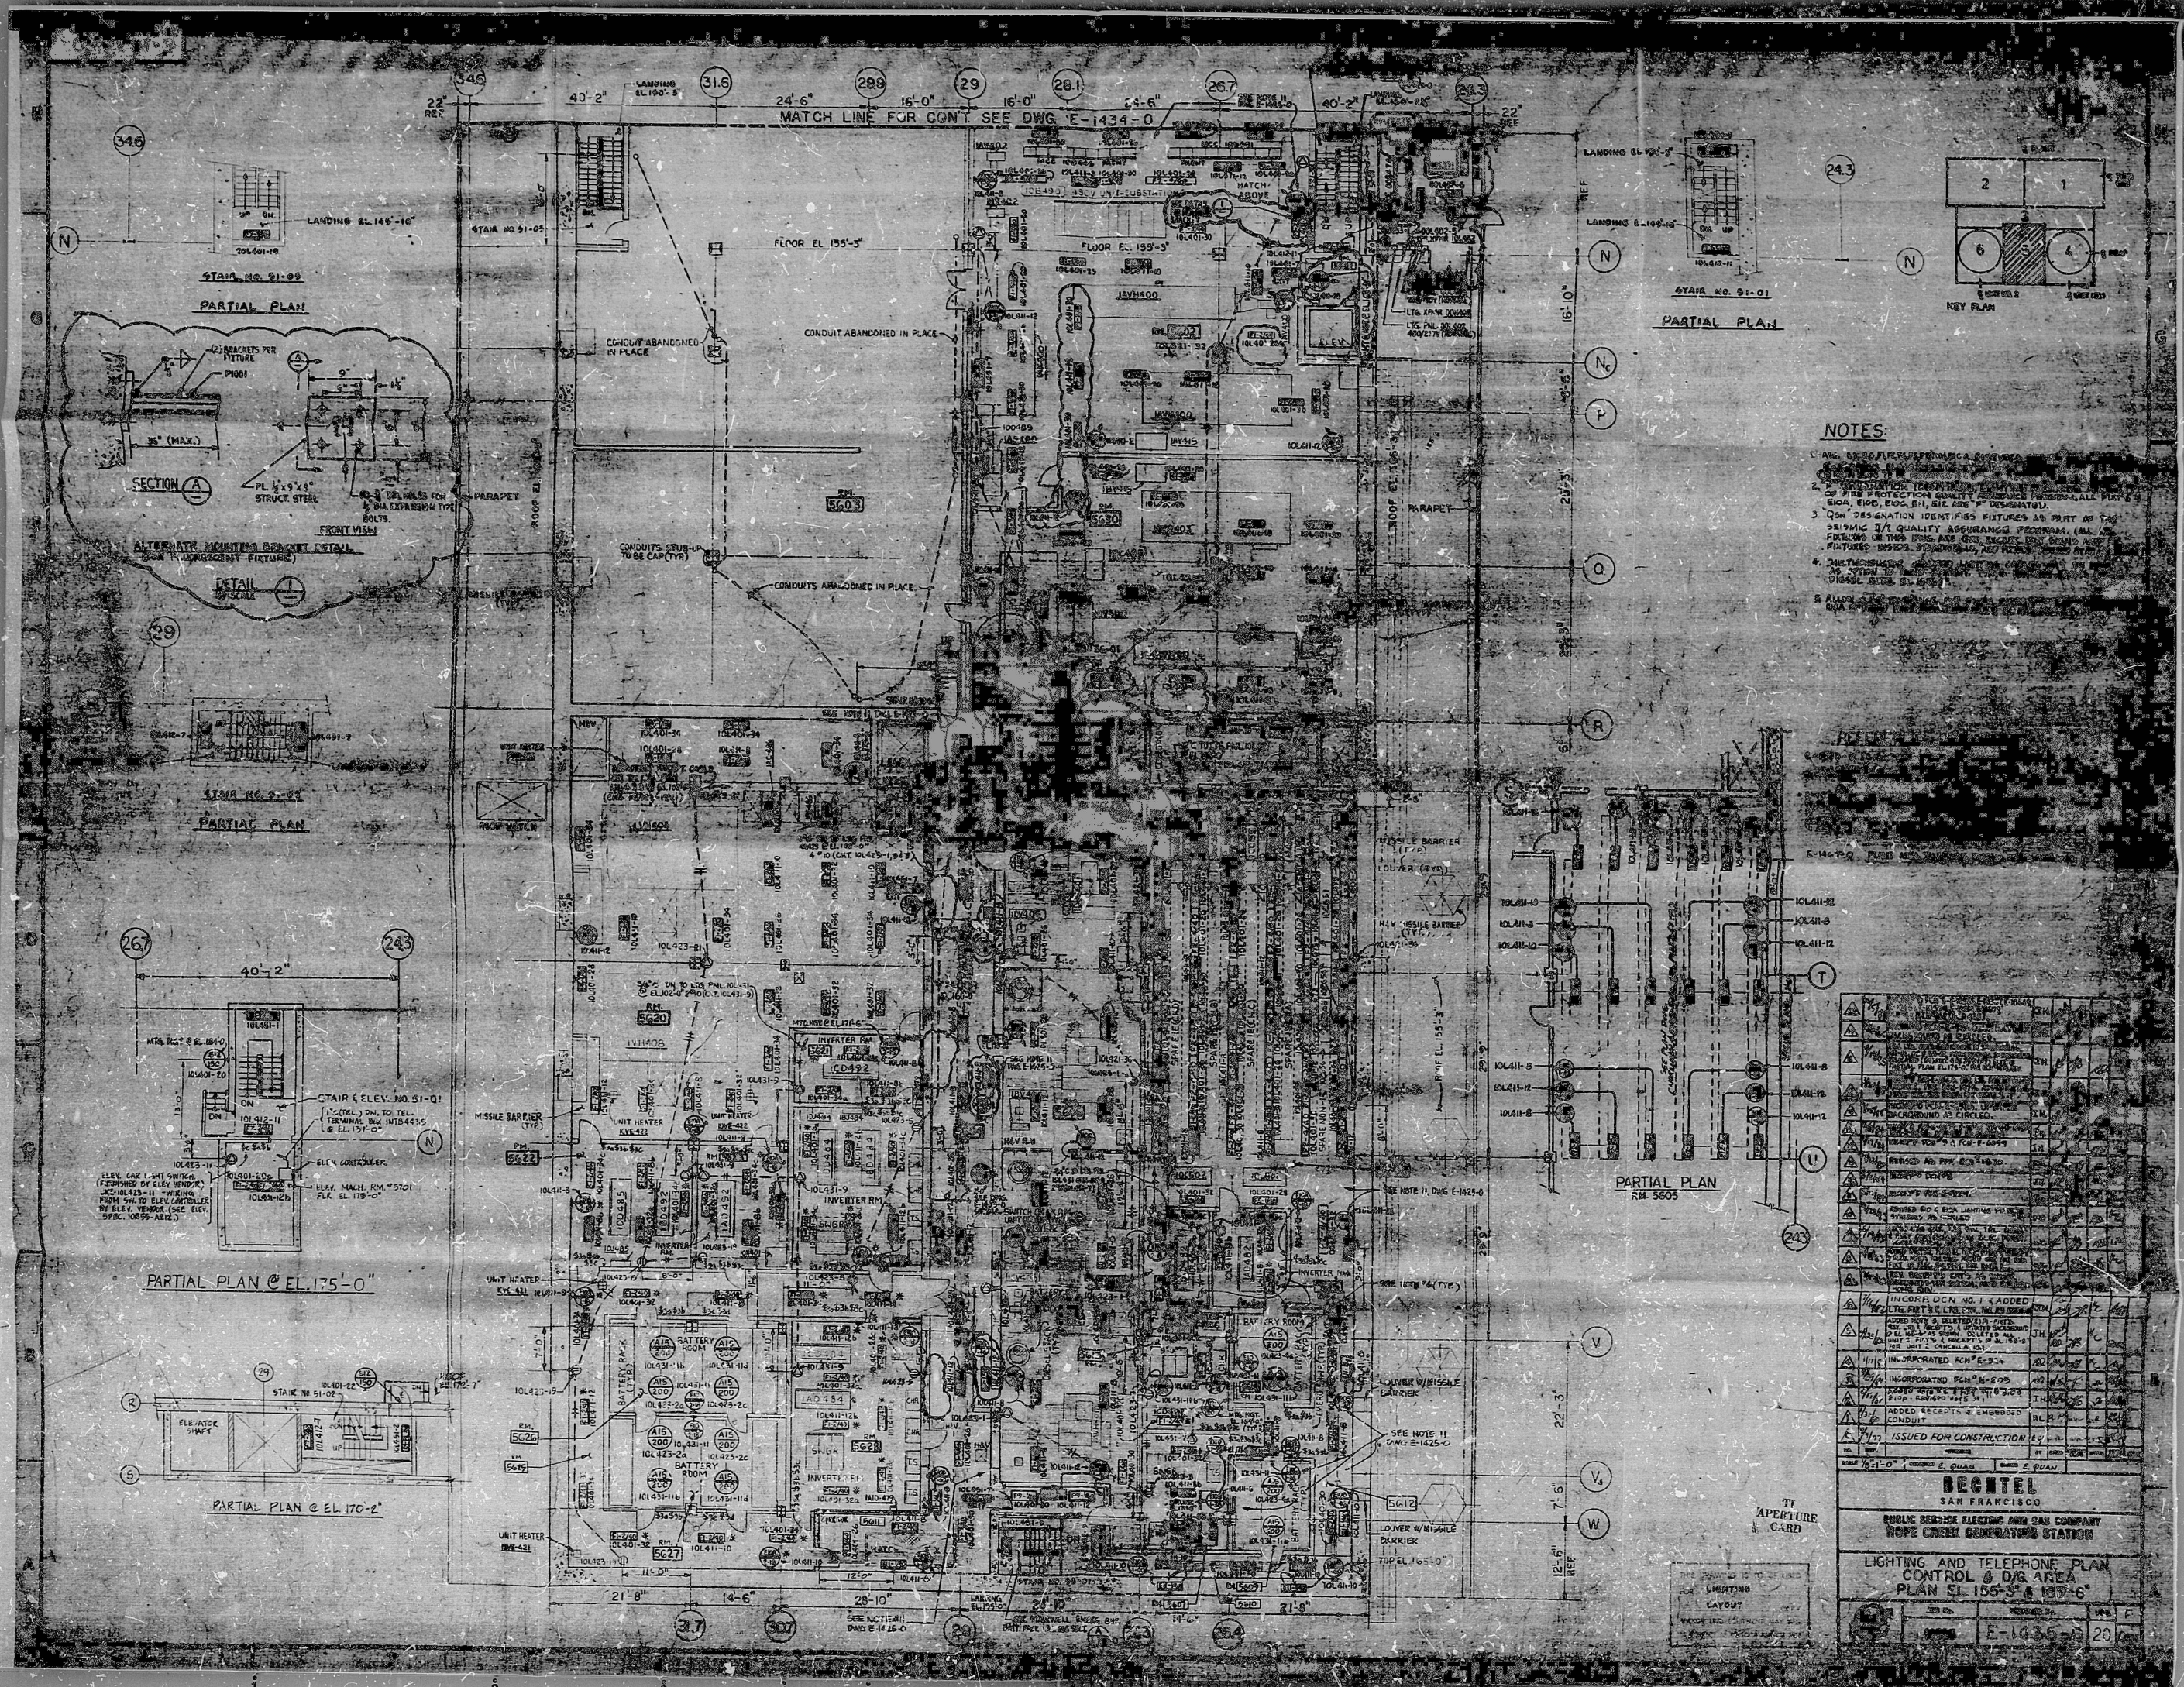

PDR RIDS

8602270688

