


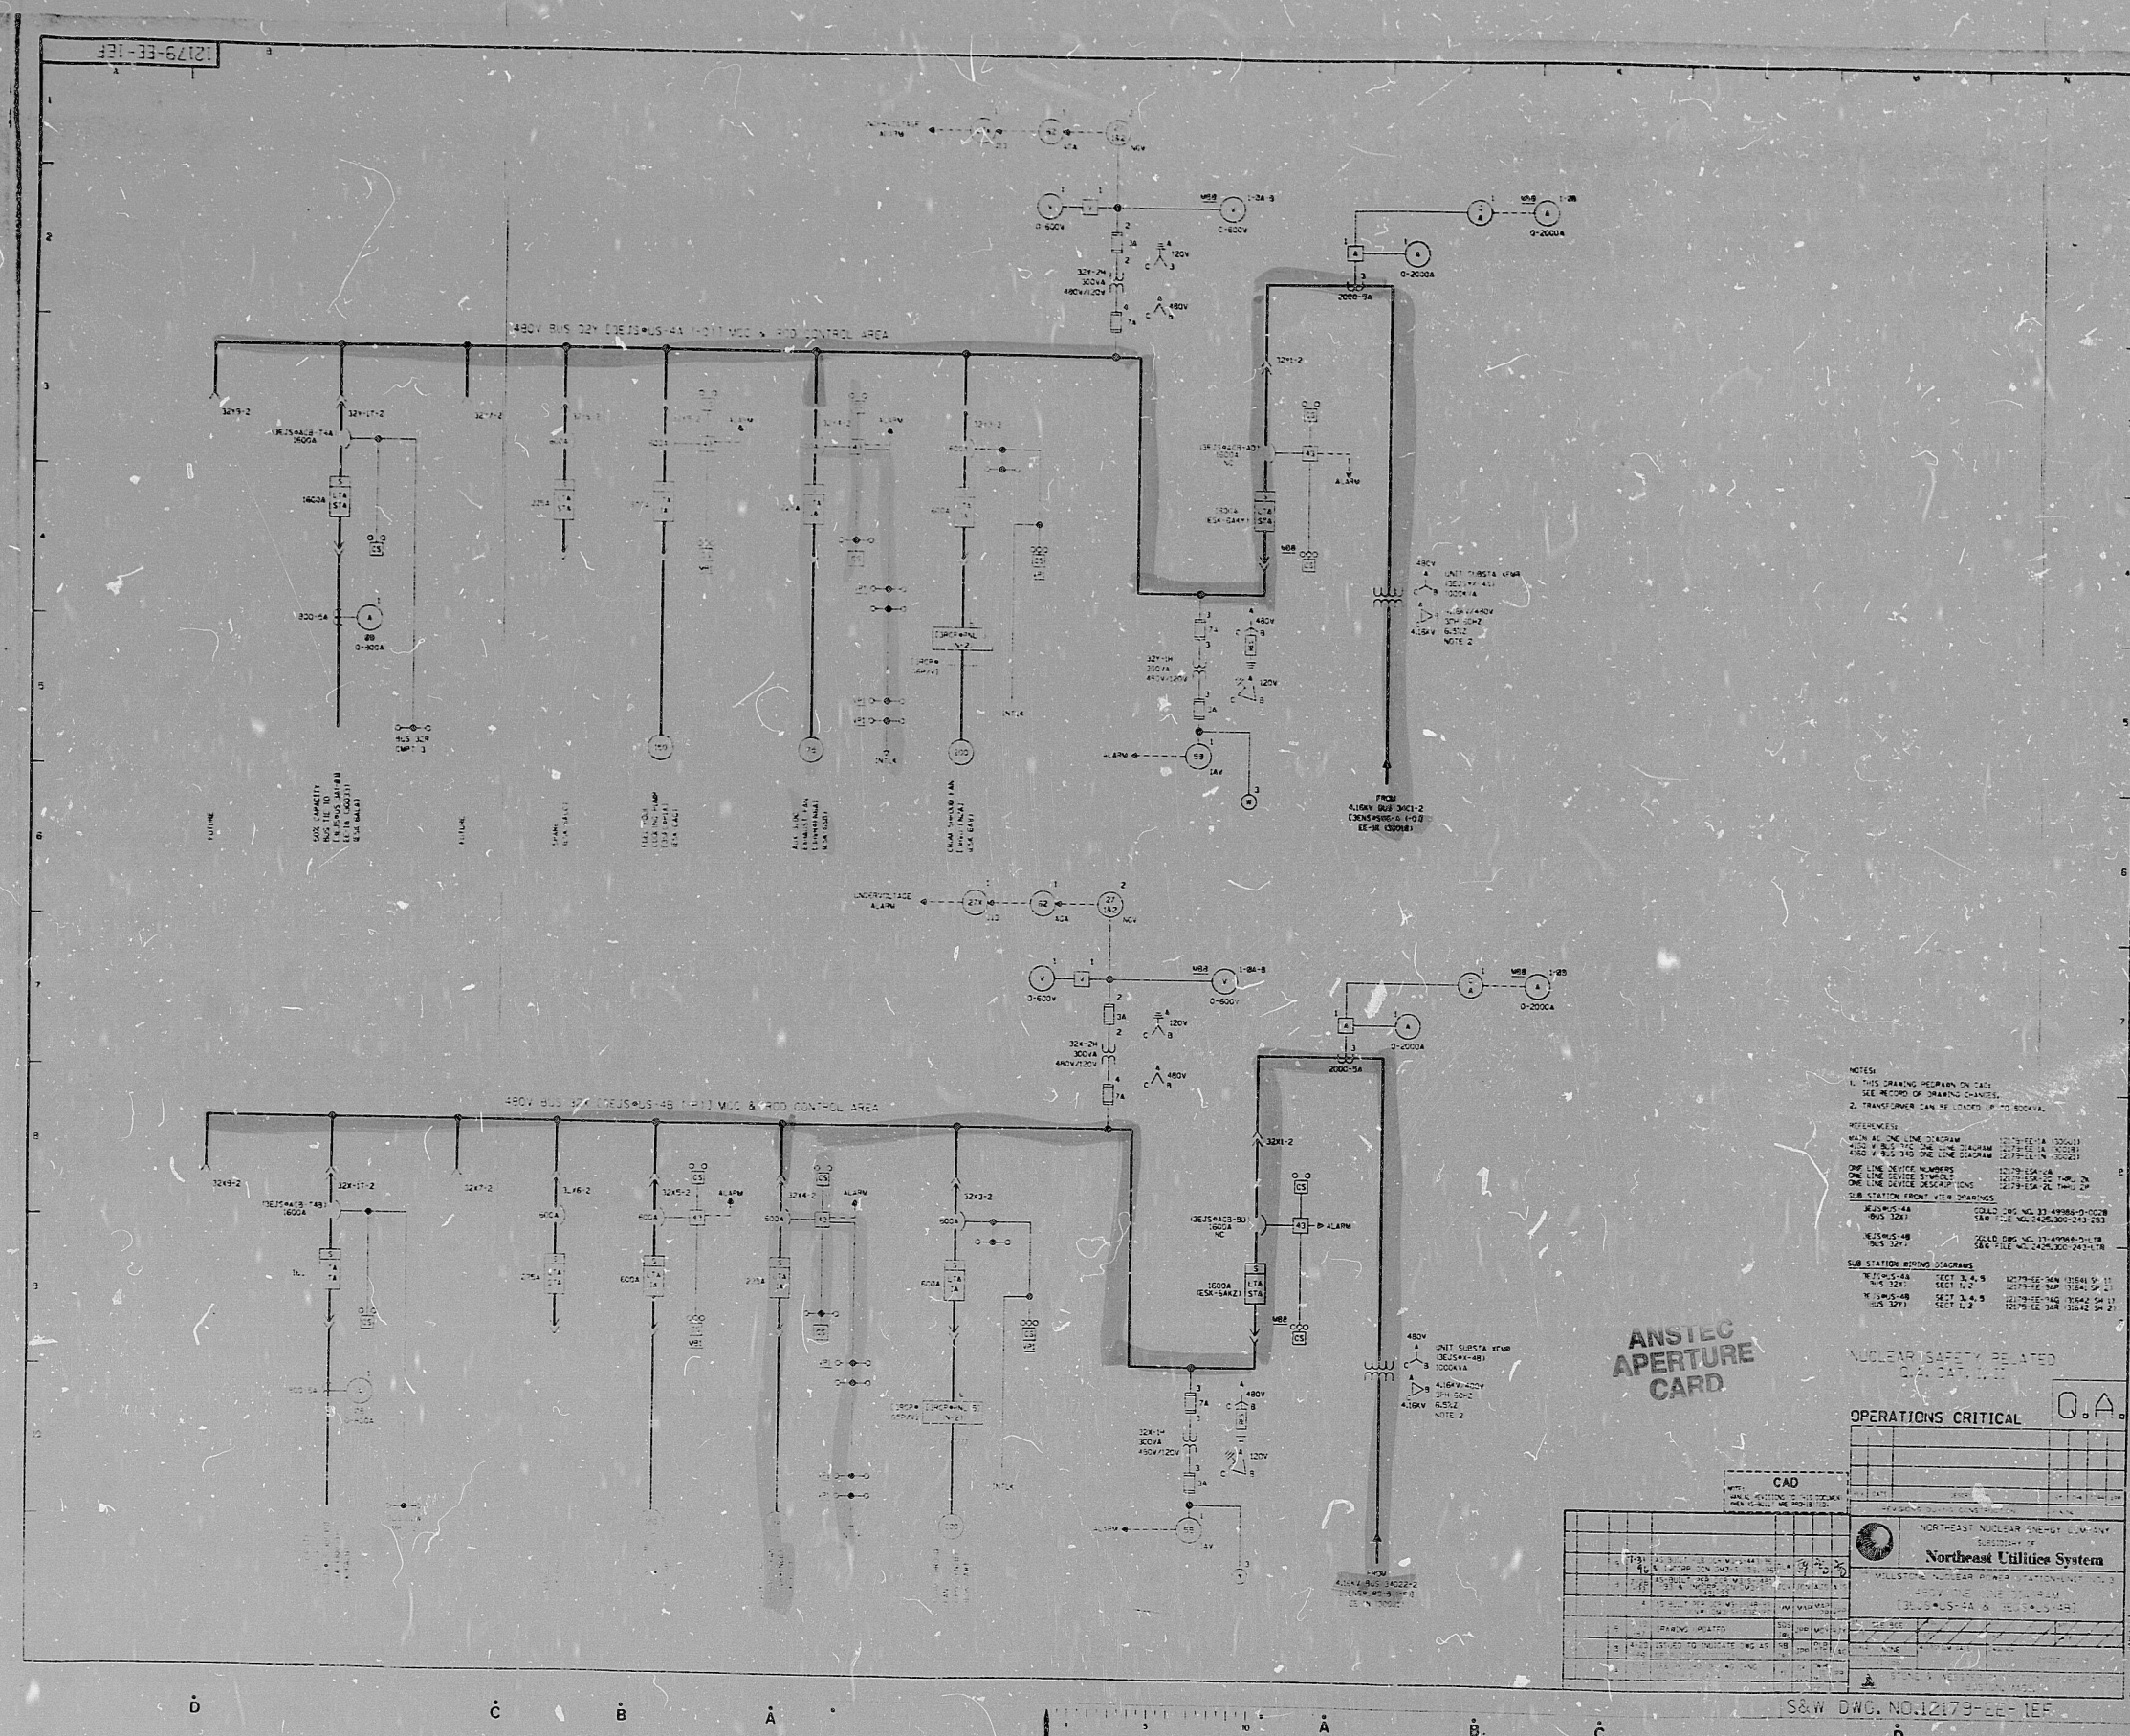

S&W DWG. NO. 12179-EE-1F

9711030101

PDR RIDS

9711030101

