


DGX / MECH BOUNDARIES

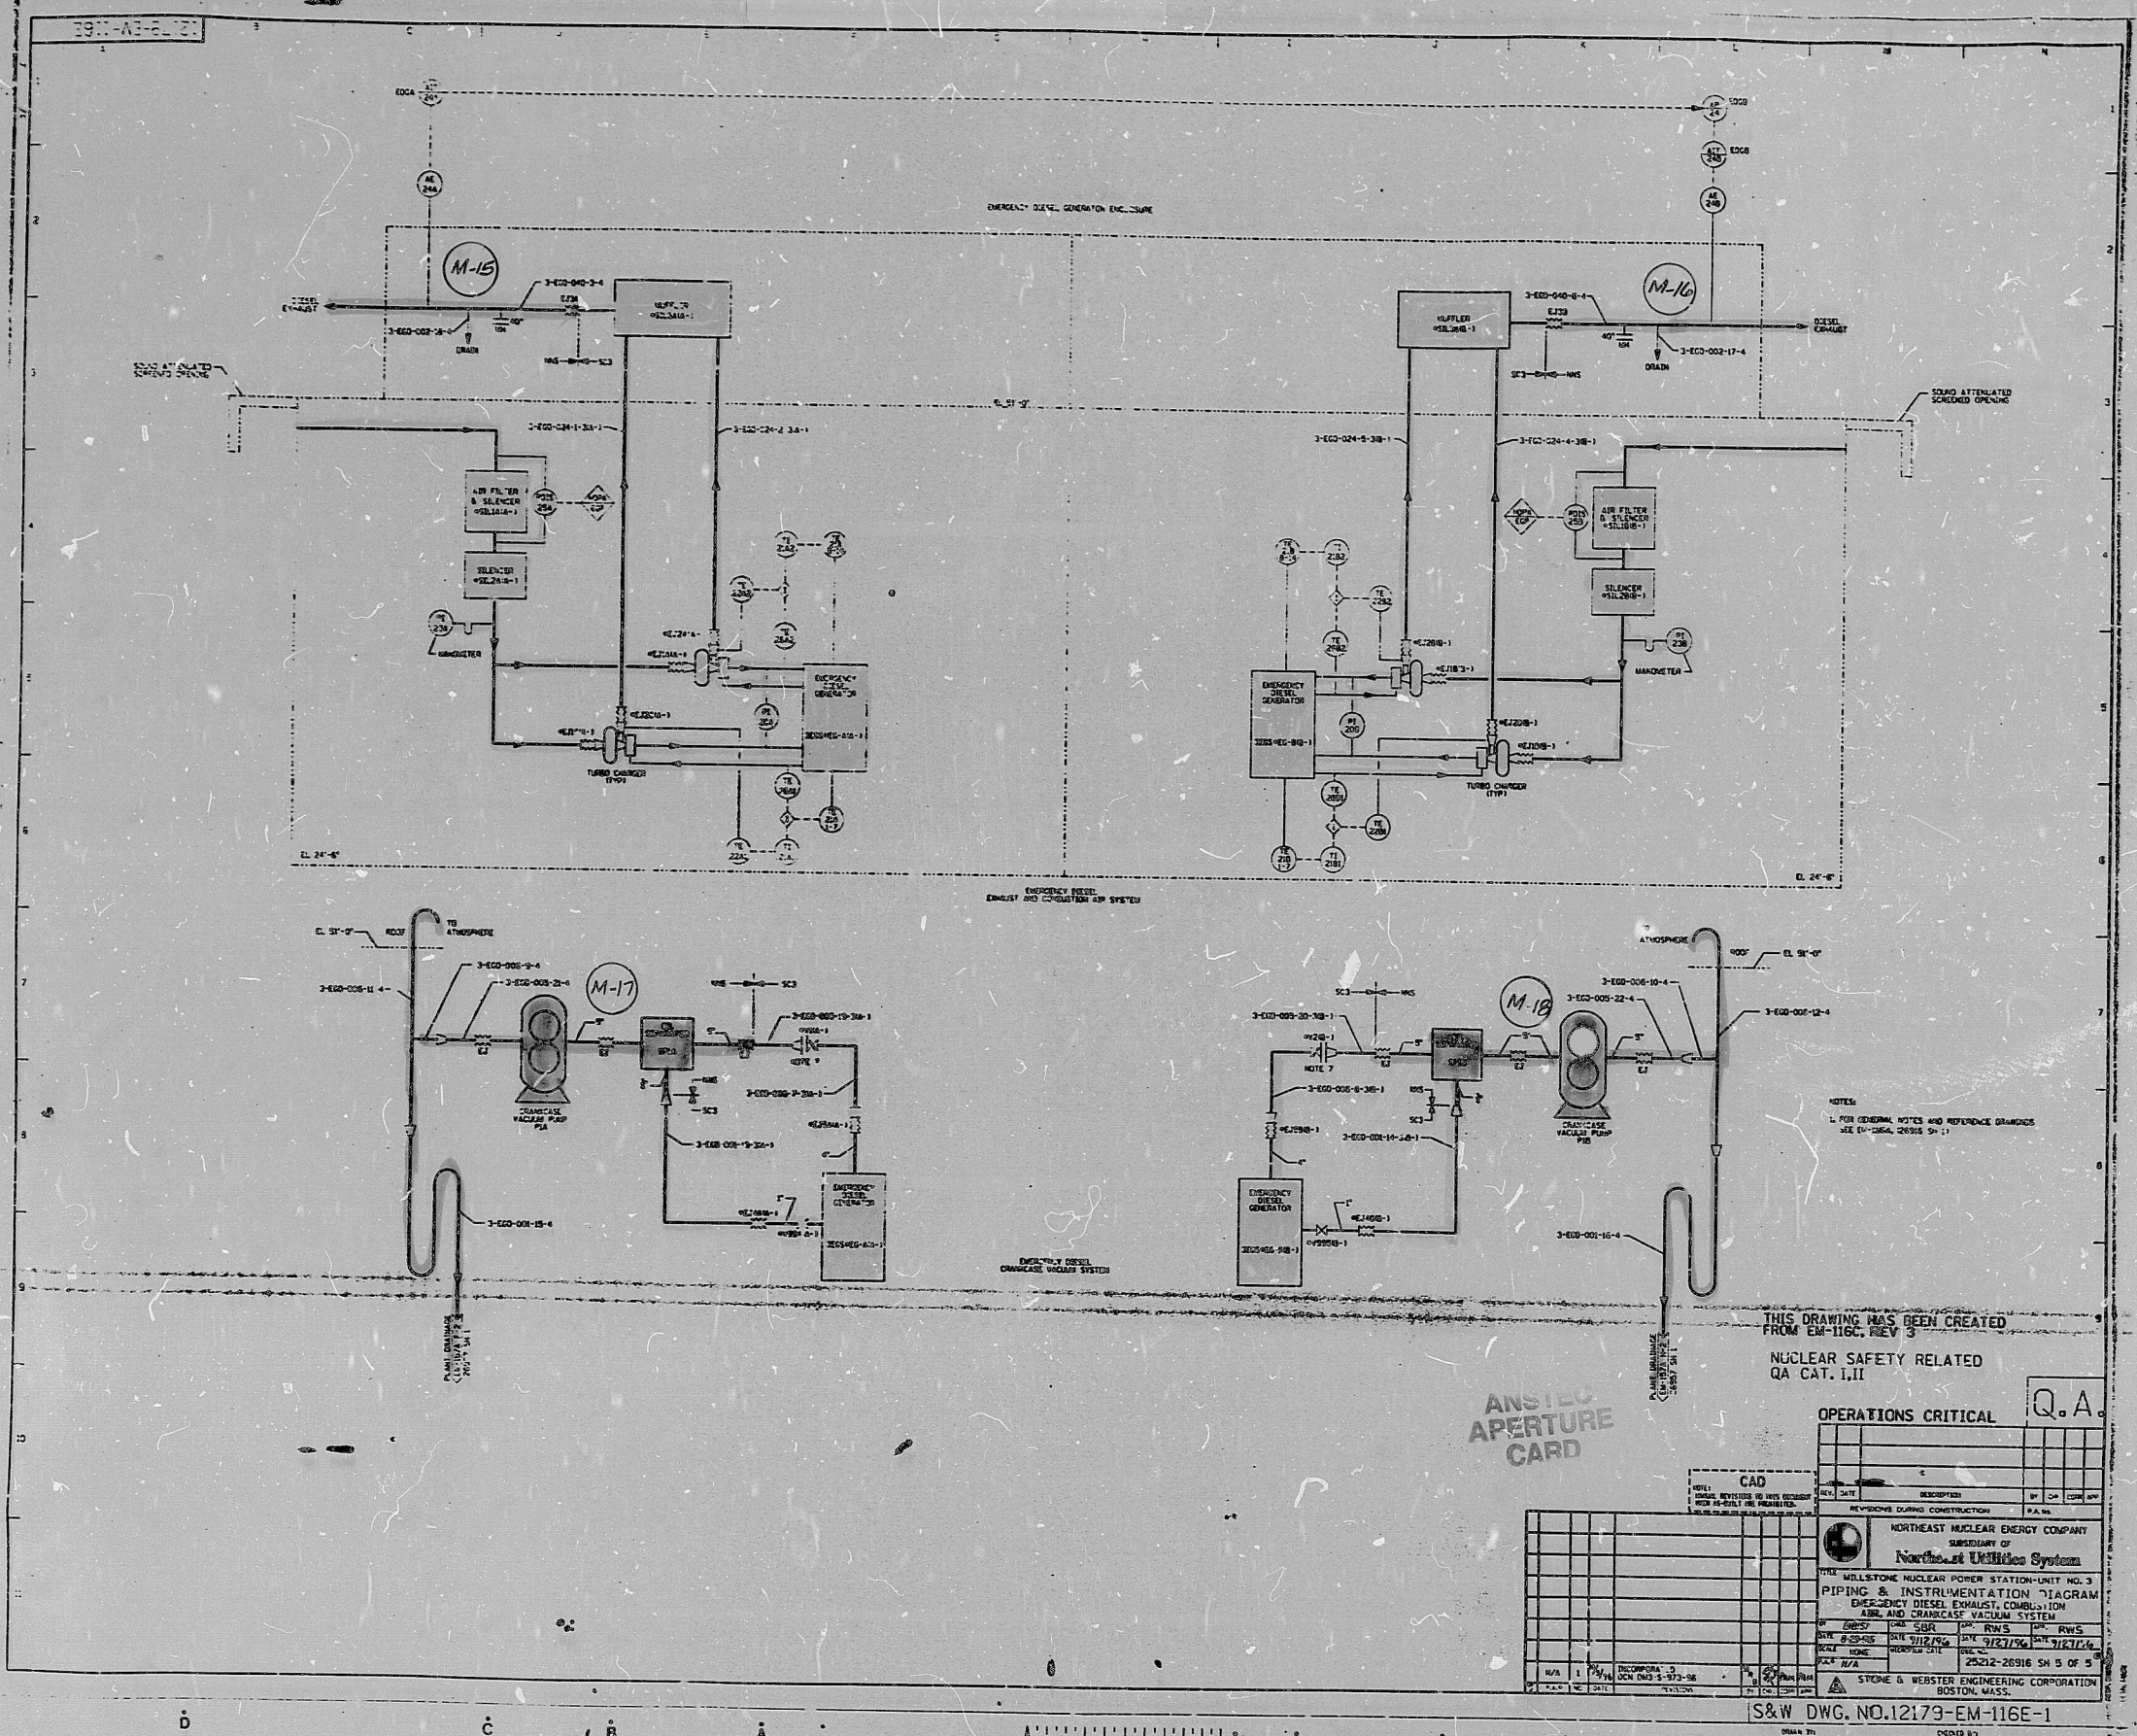

9711030147

PDR RIDS

9711030147

