


DGX ELECT BOUNDARY

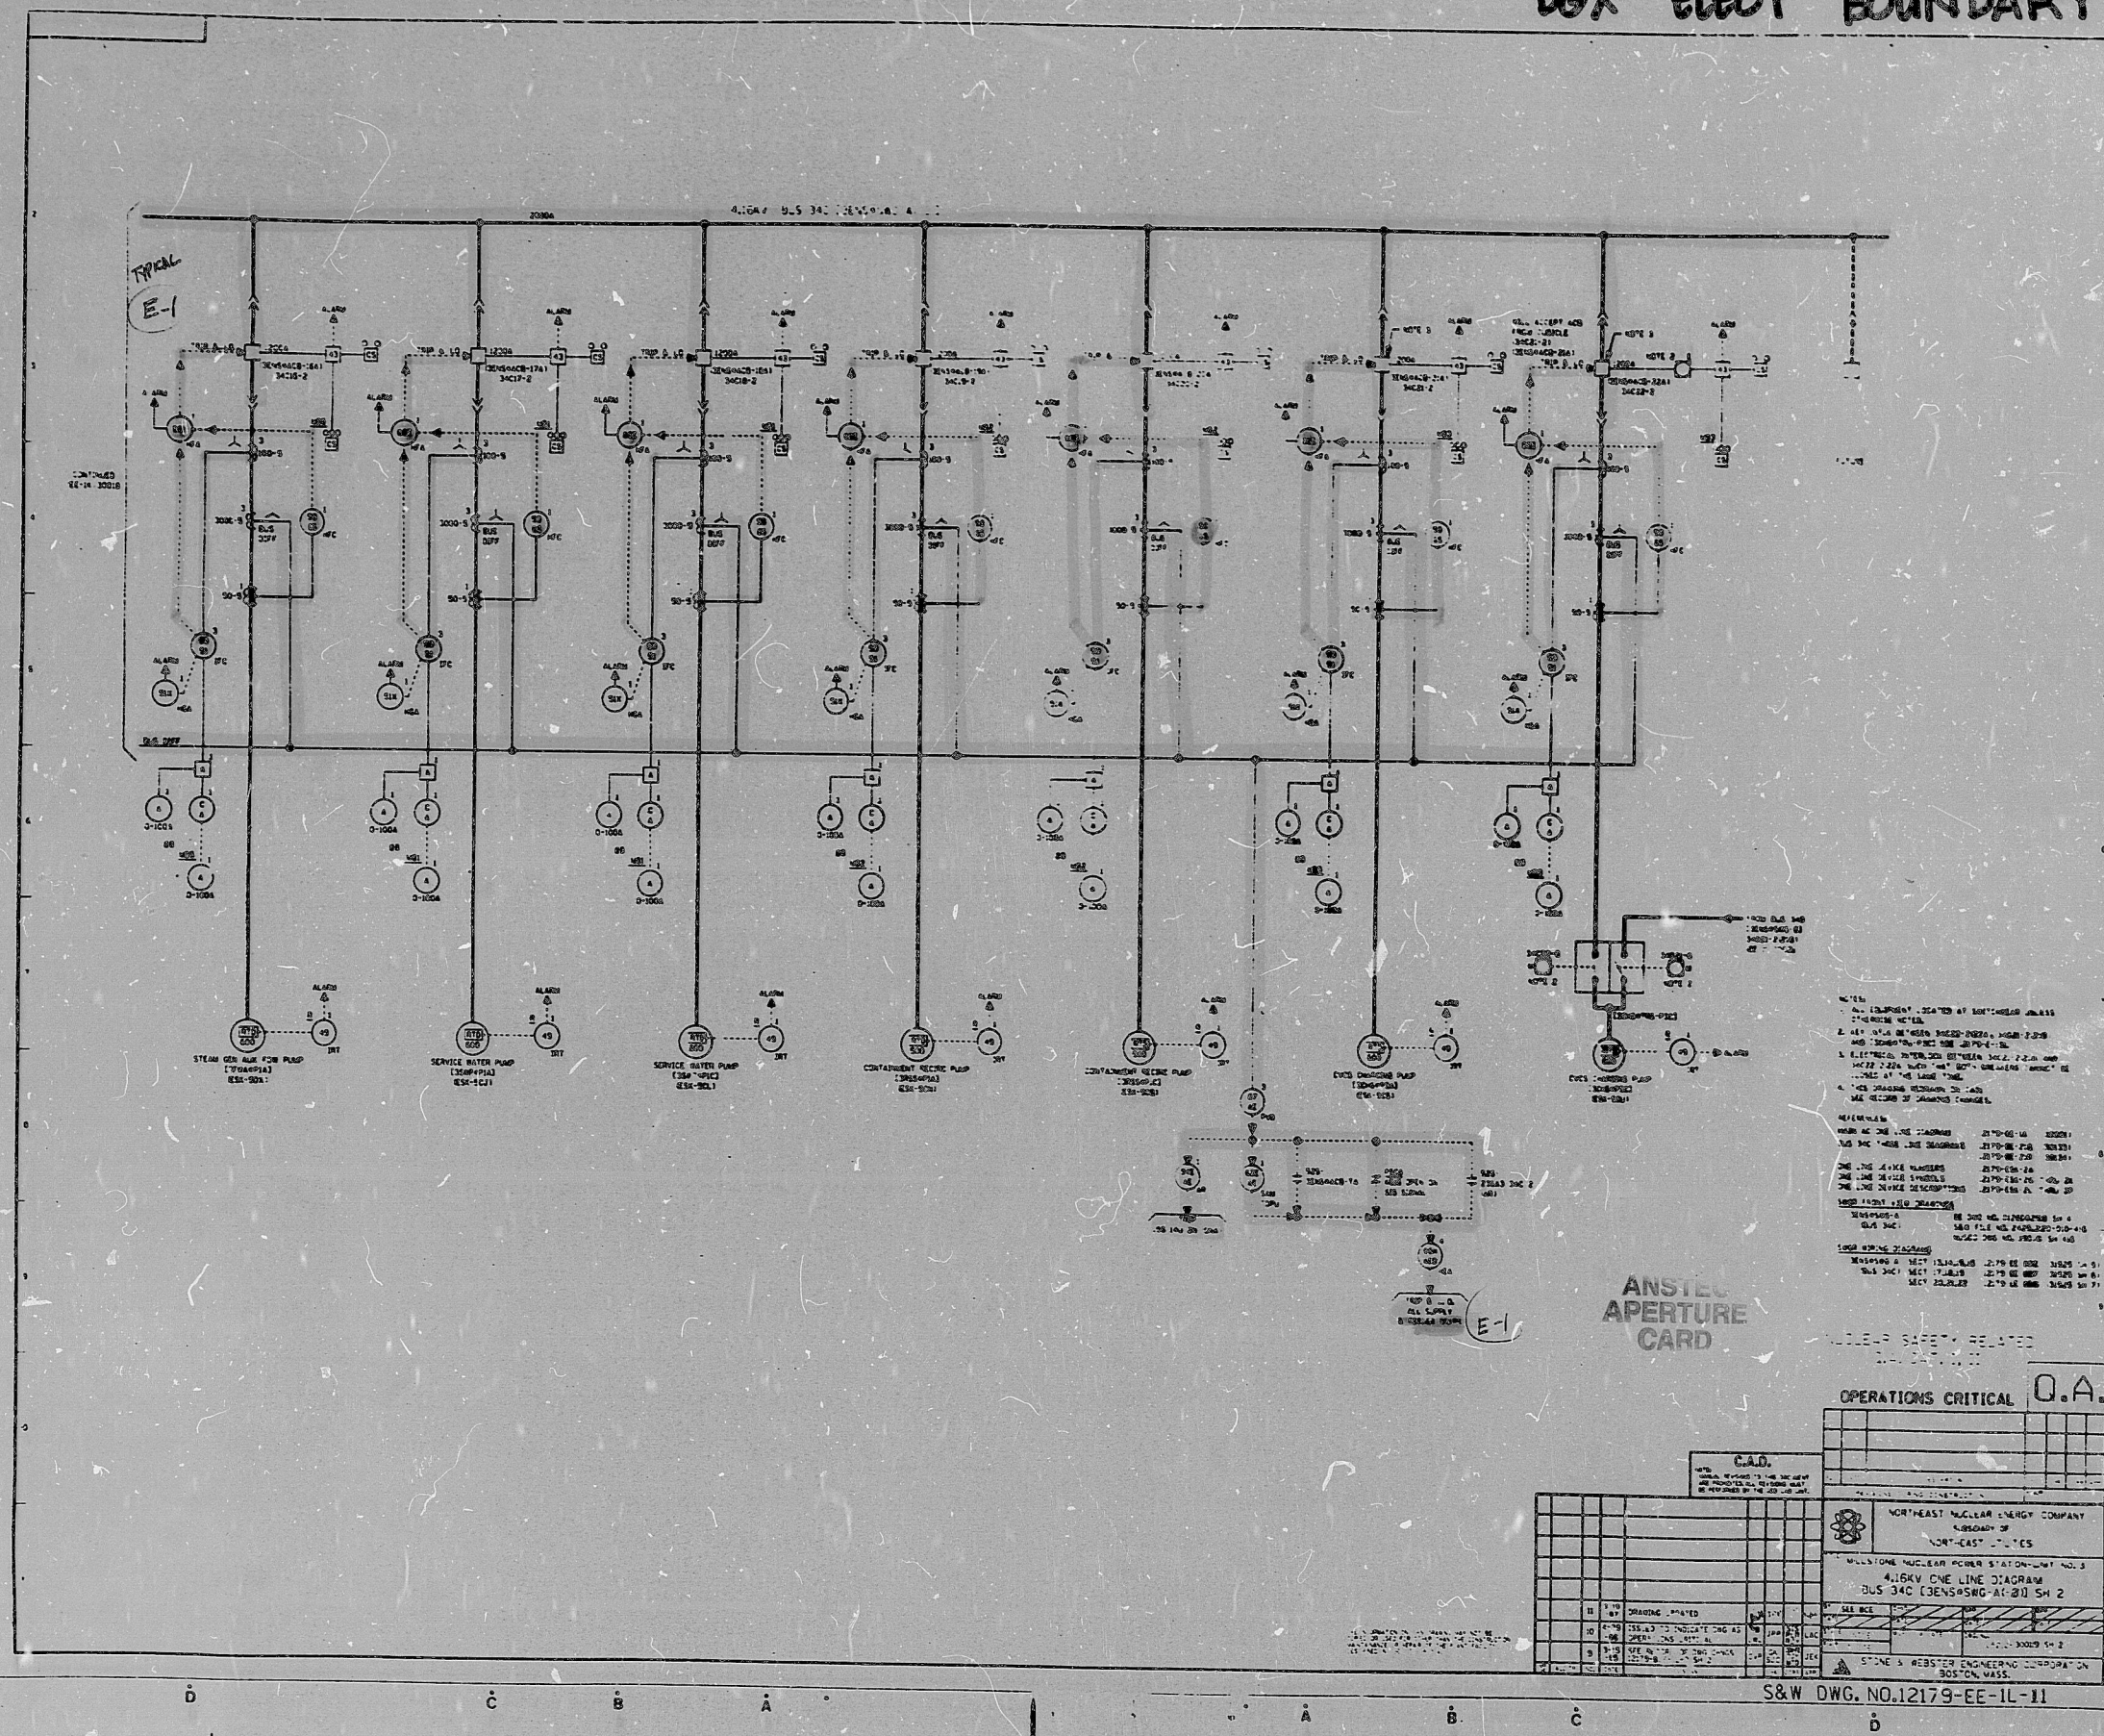

9711030150

PDR RIDS

971103 0150 1166

