


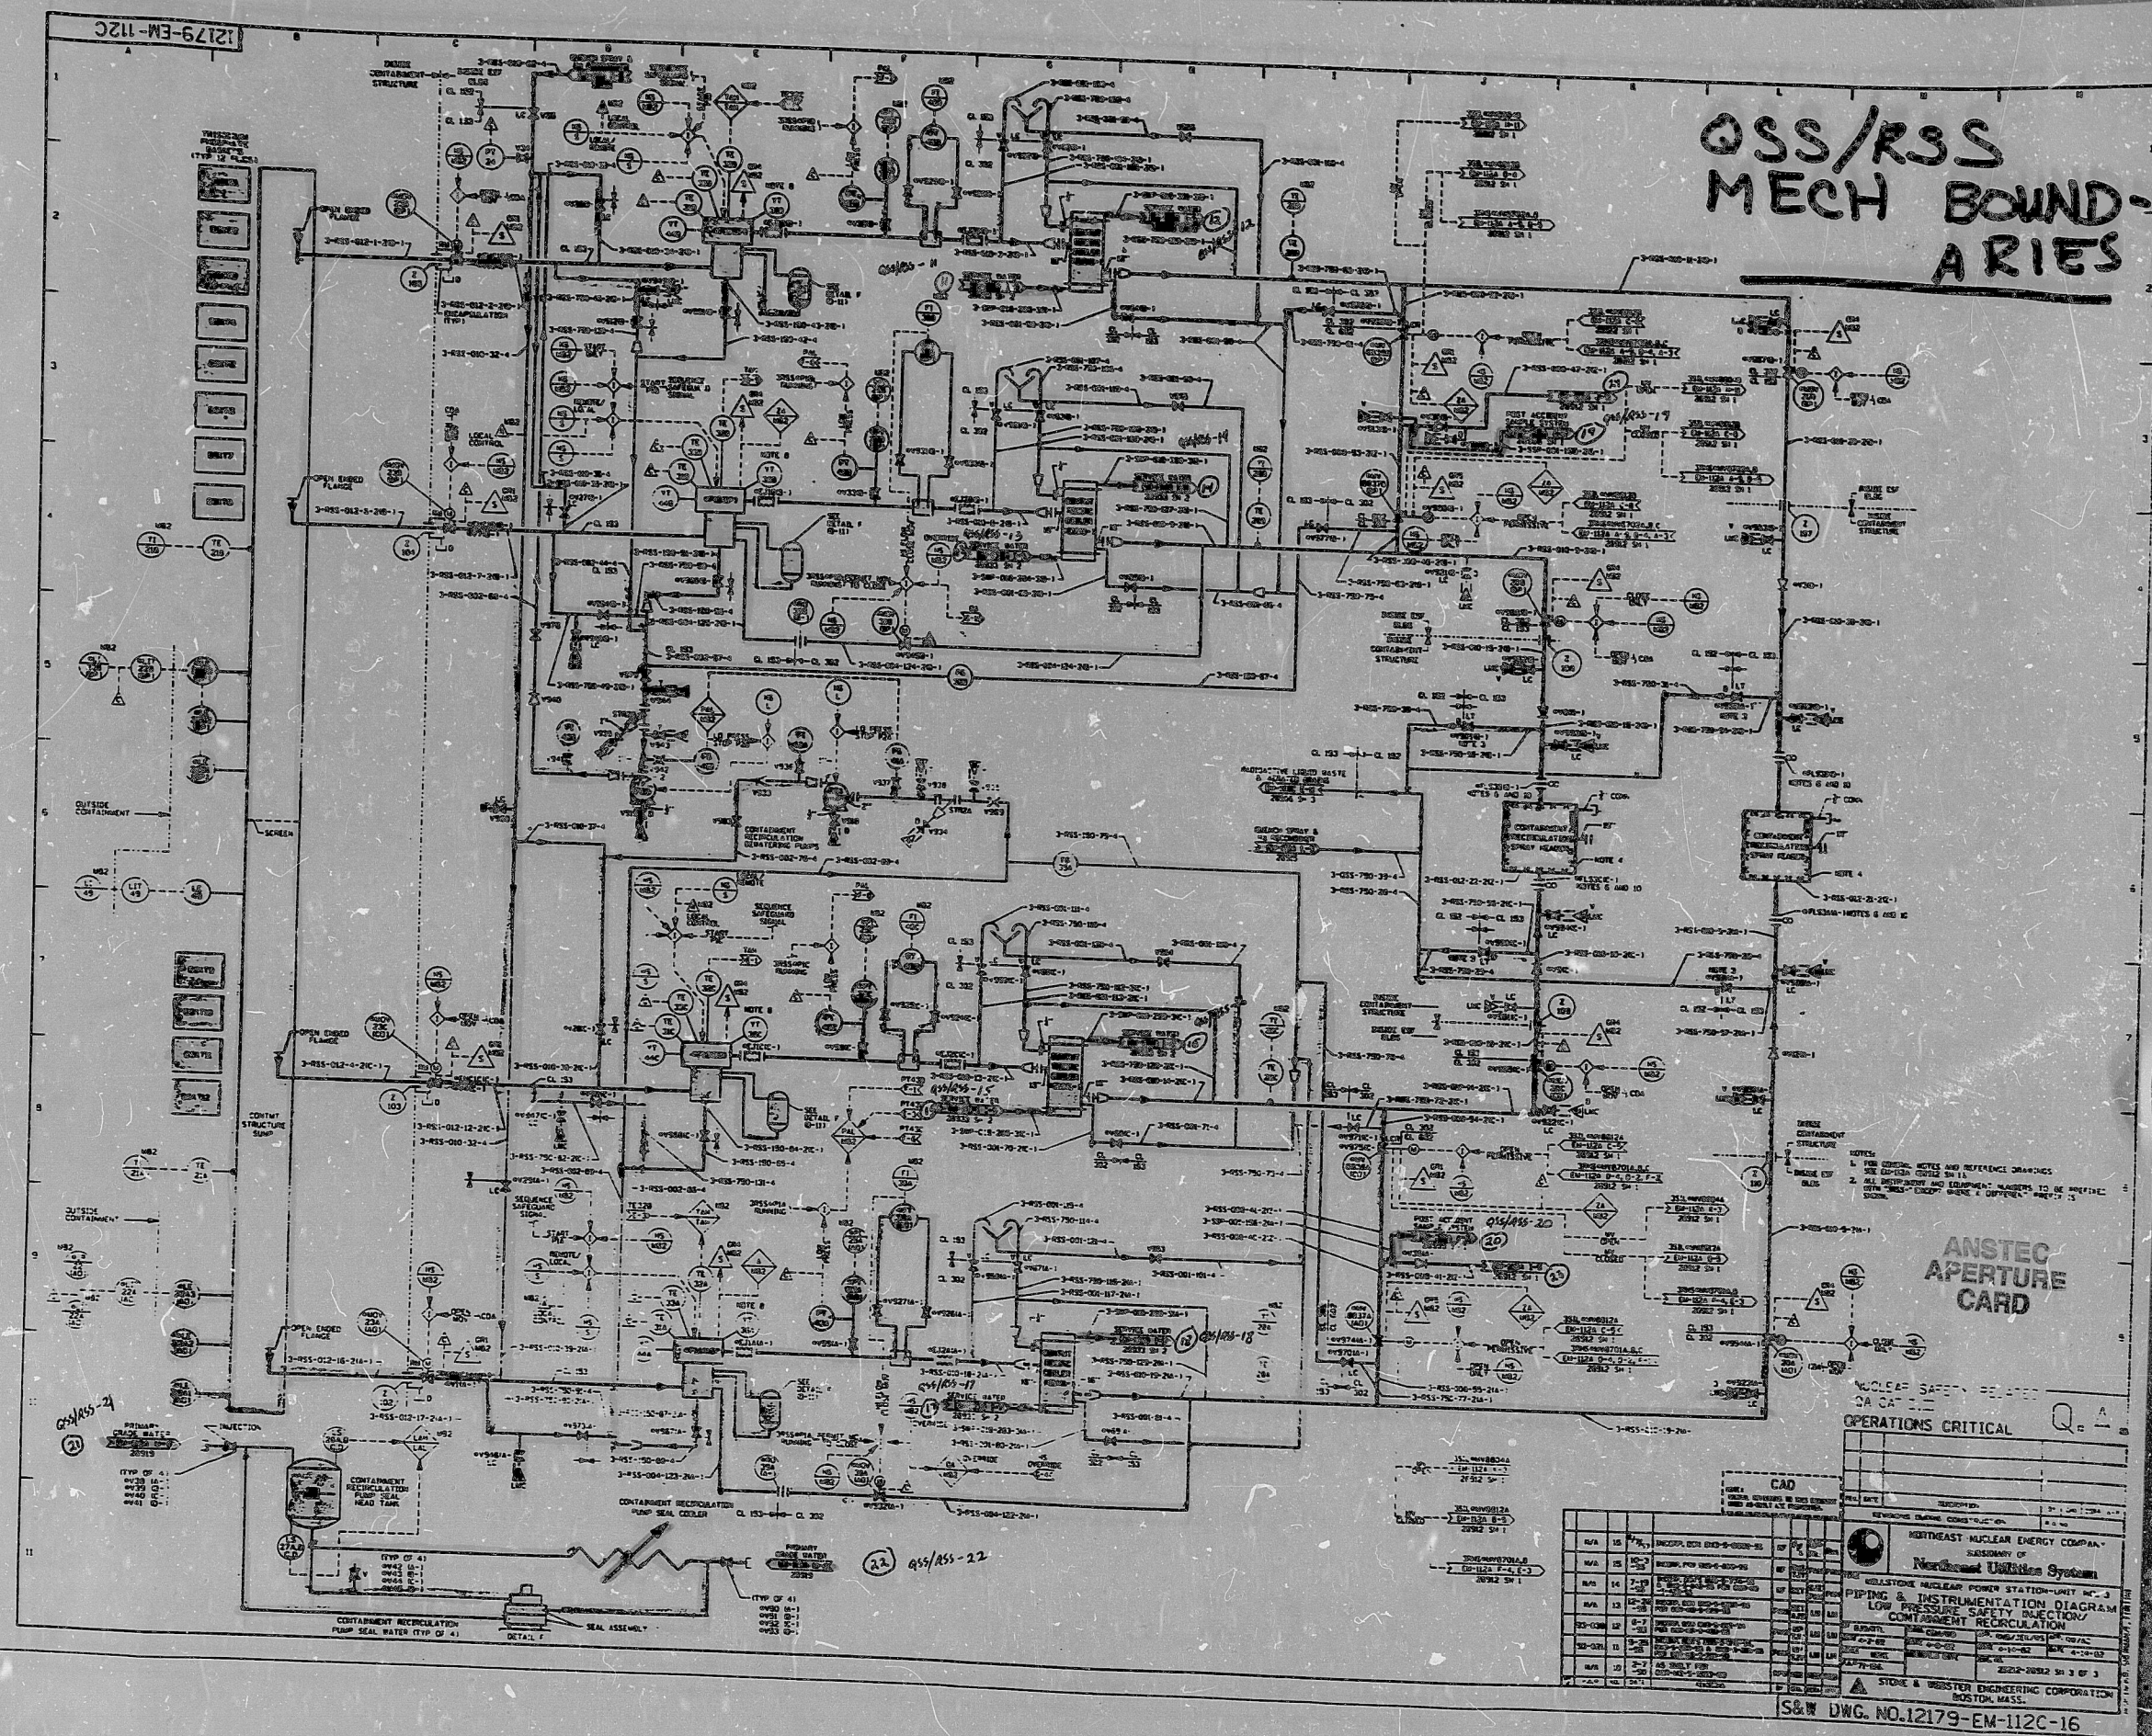

9711050155

* 9710290111

PDR RIDS

9711050155

