


SWP
MECH BOUNDARY 1/5

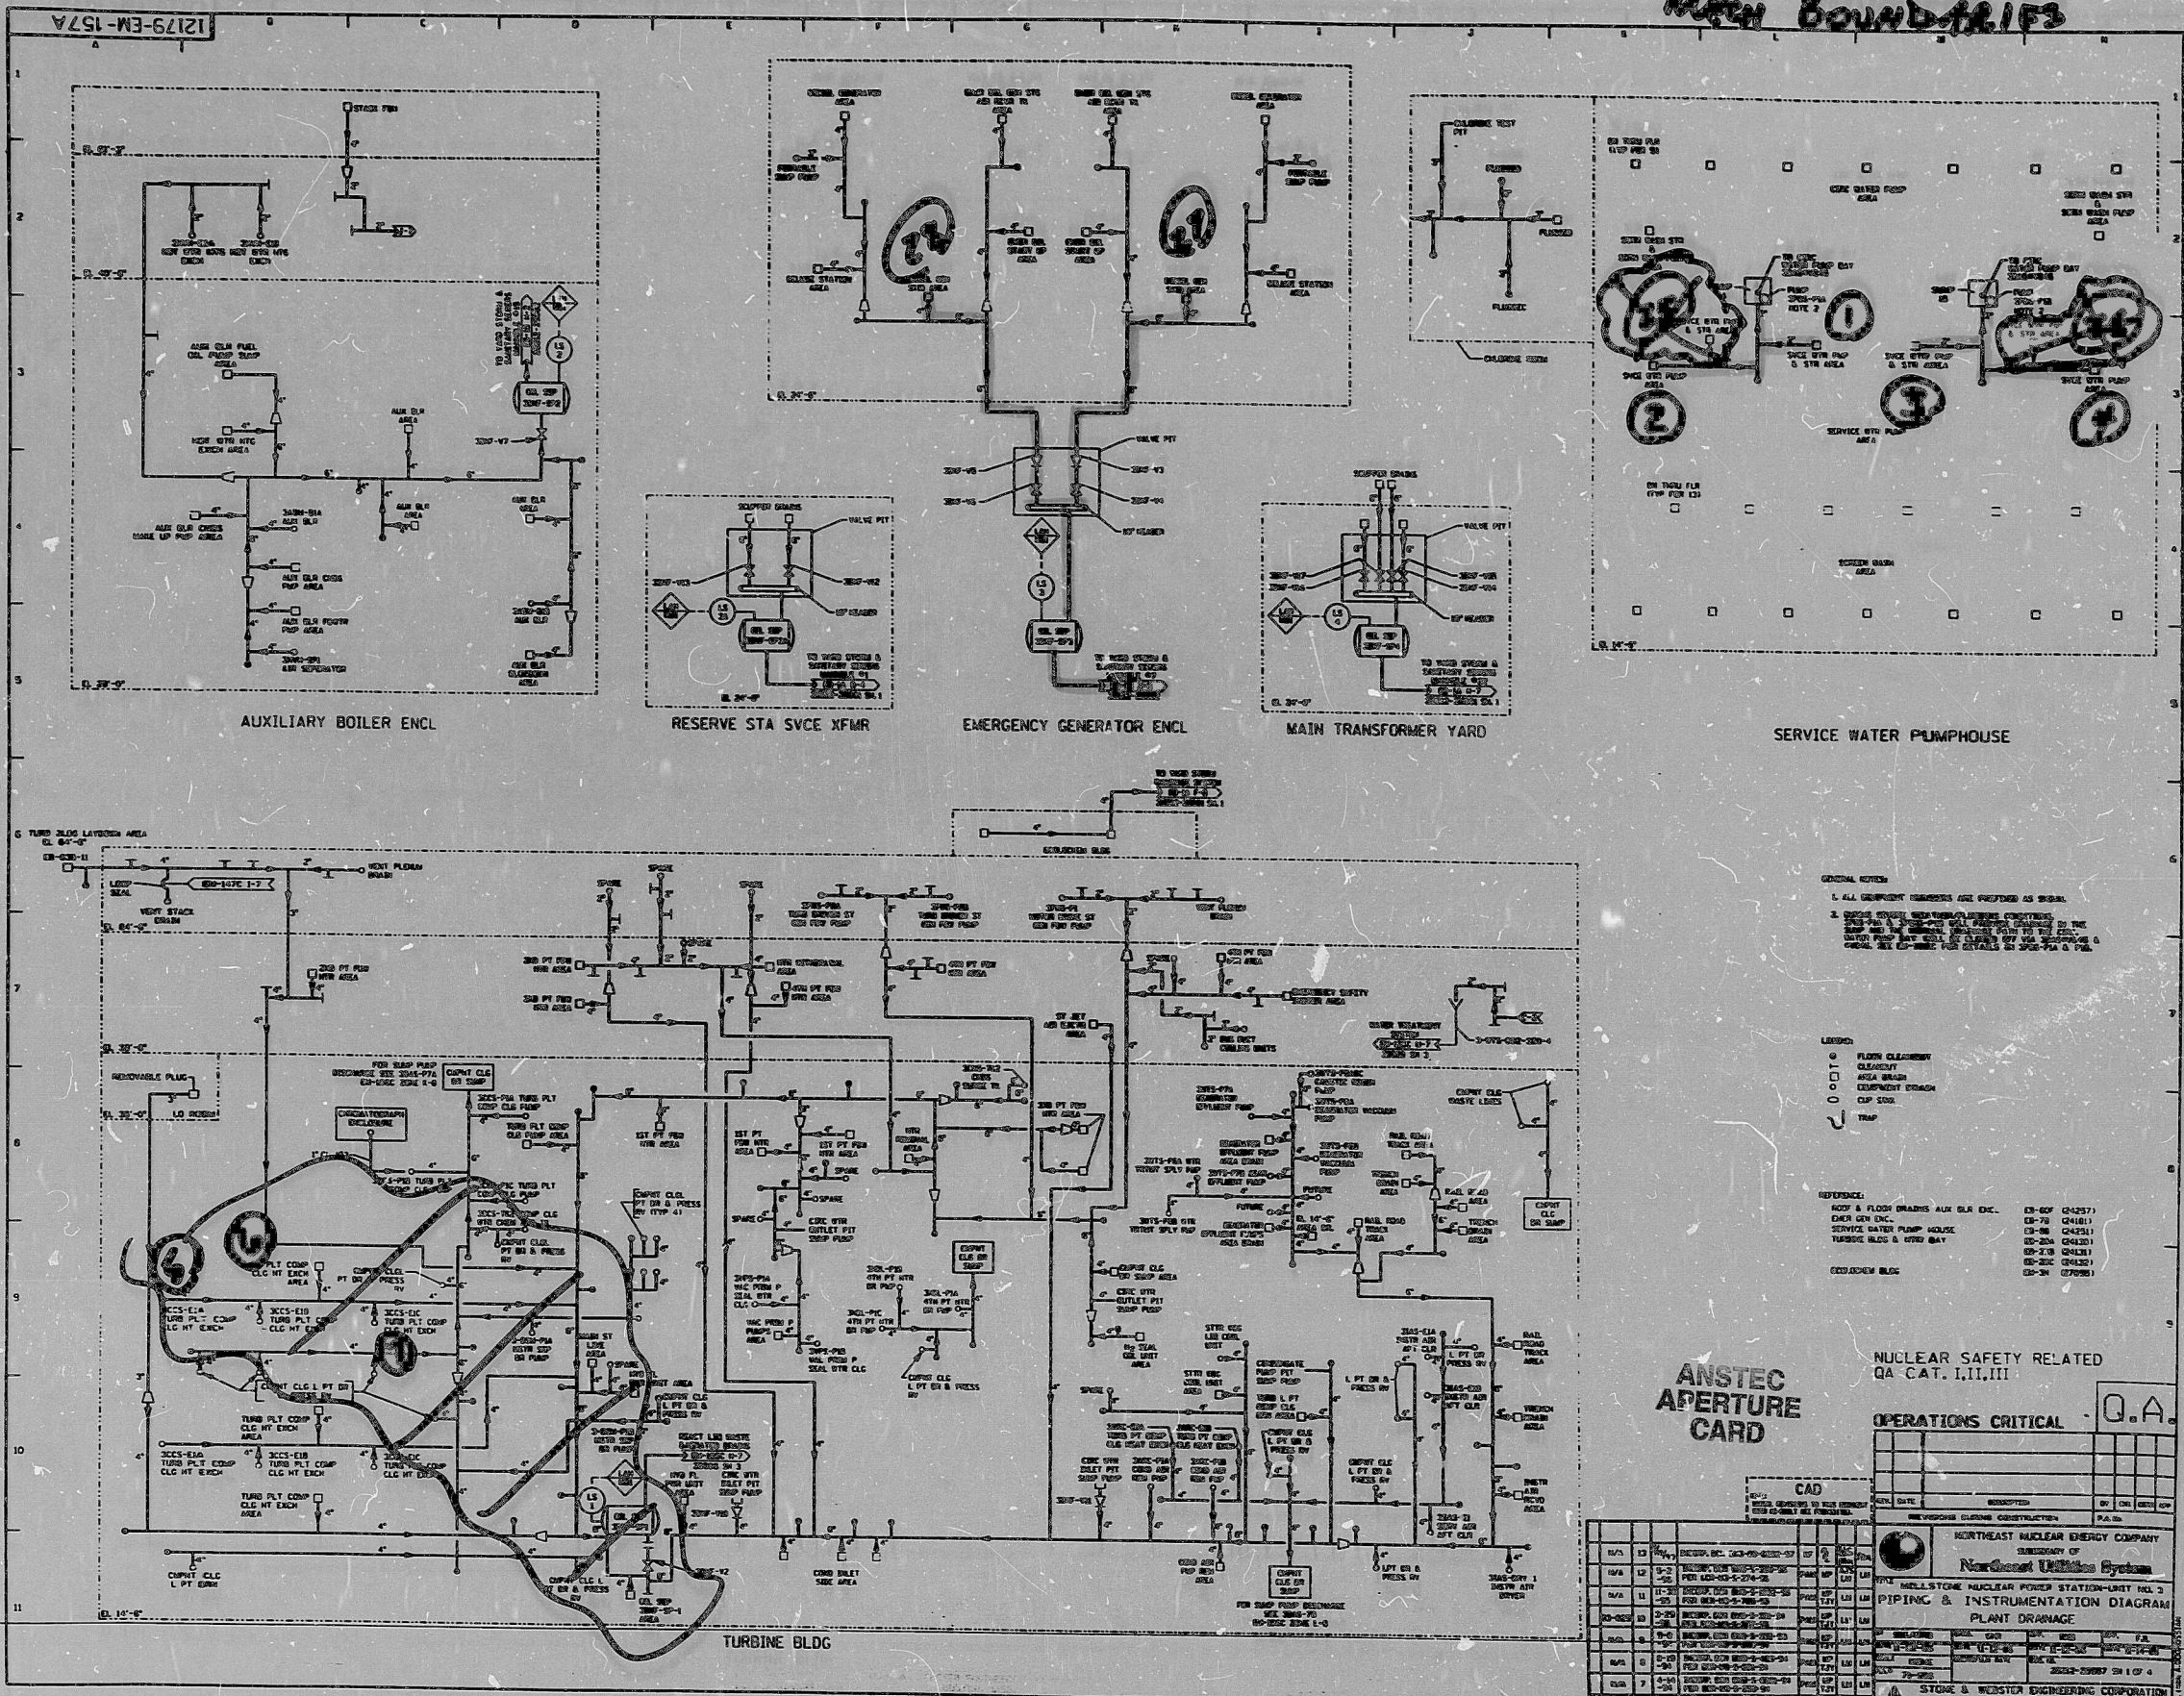

ANSTEC APERTURE CARD

NUCLEAR SAFETY RELATED
QA CAT. I, II, III

OPERATIONS CRITICAL **Q.A.**


SWP MECH BOUNDARY 1/5

9711050207

PDR RIDS

9711050207

