


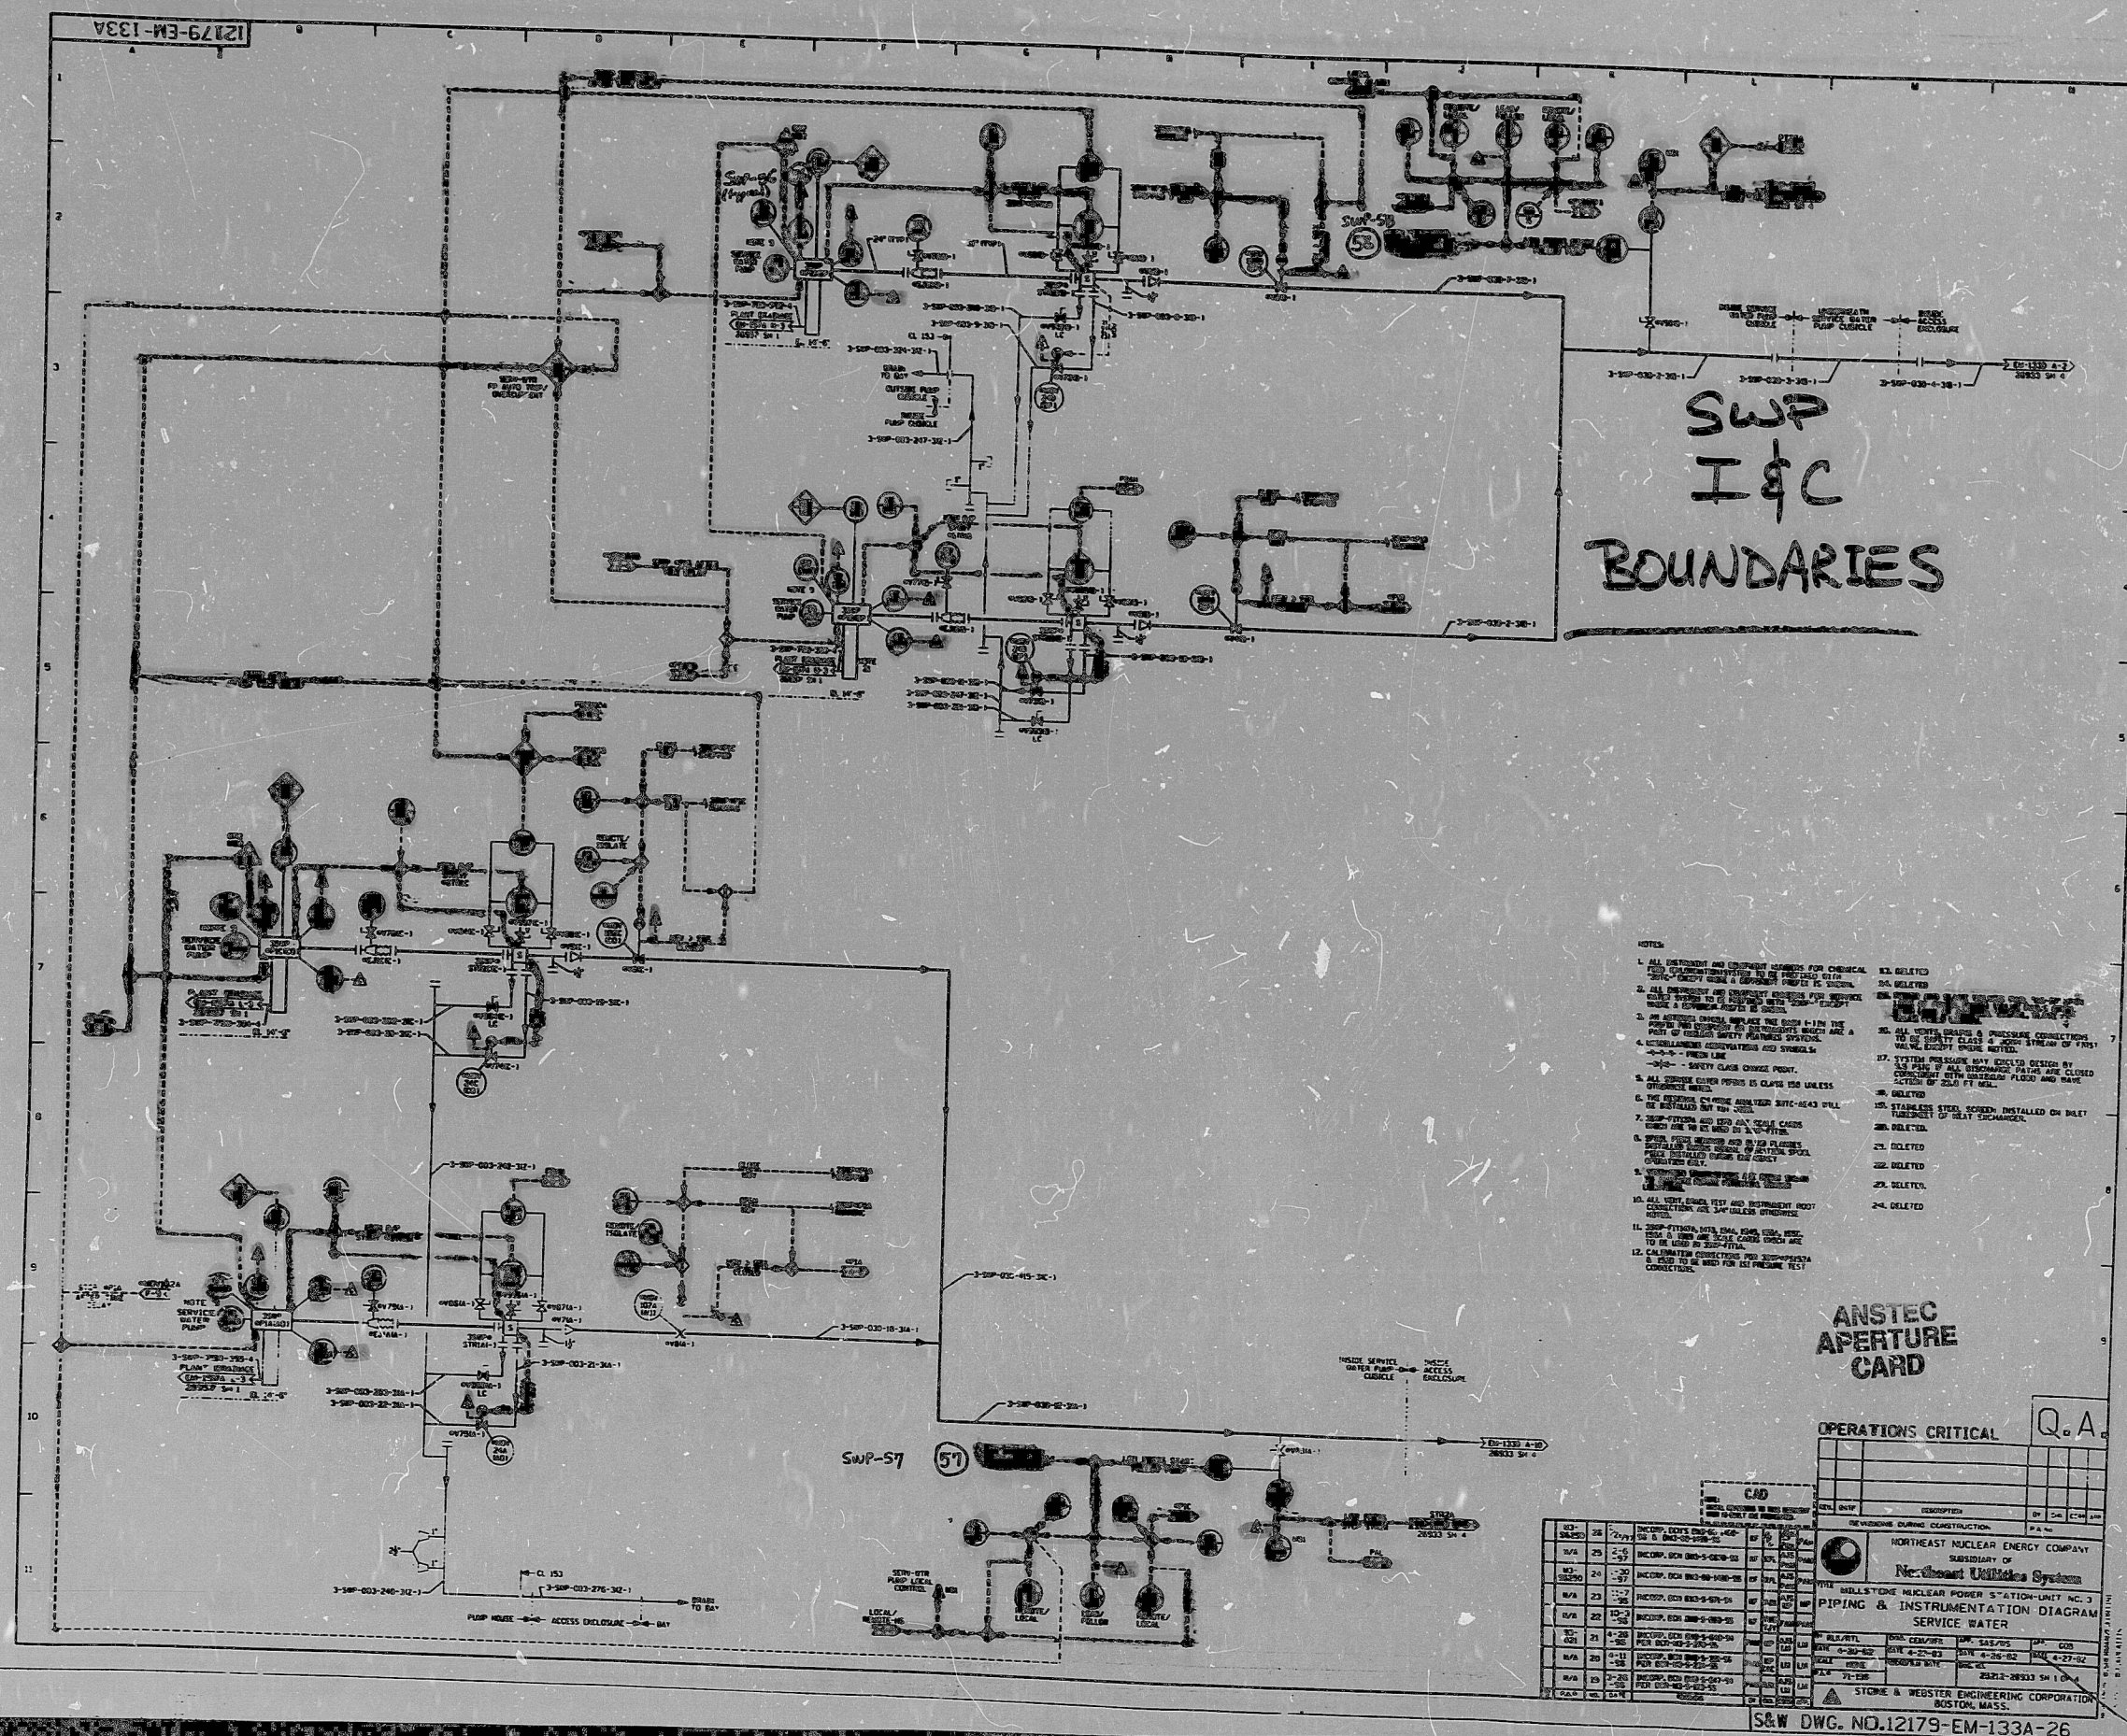

SWP
I & C
BOUNDARIES

**ANSTEC
APERTURE
CARD**

OPERATIONS CRITICAL

Q. A

[illegible]

S&W DWG. NO.12179-EM-133A-2

9711050248

PDR RIDS

9711050248

