

This drawing and the design it covers are the property of BECHTEL. They are hereby loaned out on the borrower's express agreement that they shall not be reproduced, copied, loaned, exhibited or used except in the limited way and for the limited purpose intended by the lender to the borrower.

SPC-CADD 11/83 E

8 0524102, 431E1256B.DGN
0524112, 20231F5KCP115.DGN


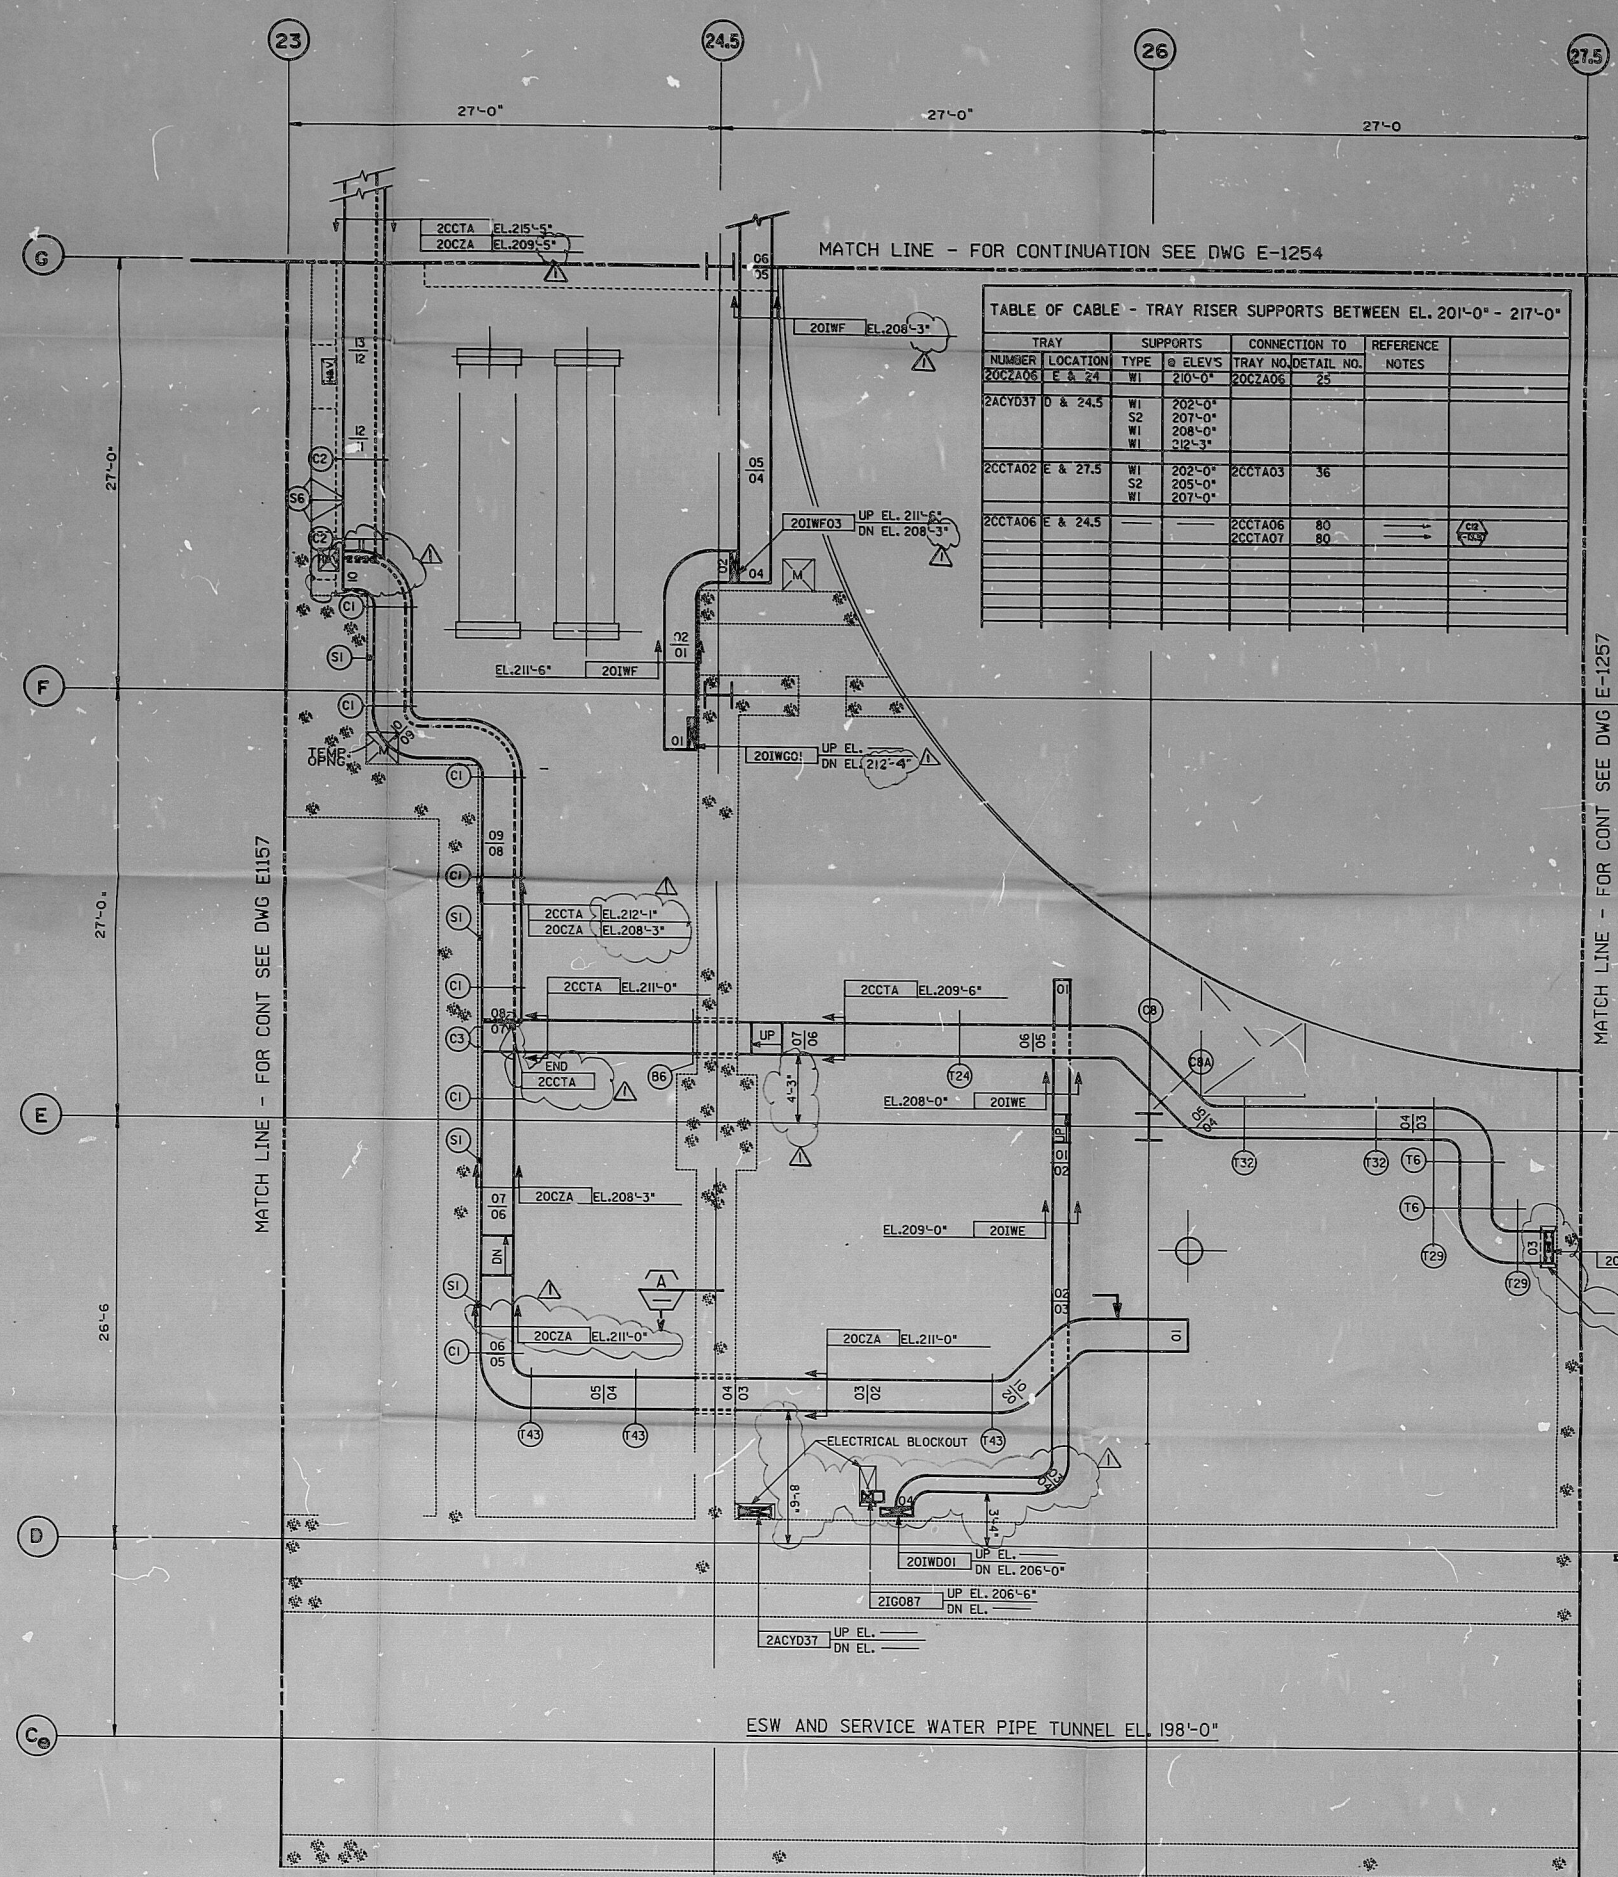


TABLE OF CABLE - TRAY RISER SUPPORTS BETWEEN EL. 201'-0" - 217'-0"

TRAY NUMBER	LOCATION	SUPPORTS TYPE	CONNECTION TO	REFERENCE	NOTES

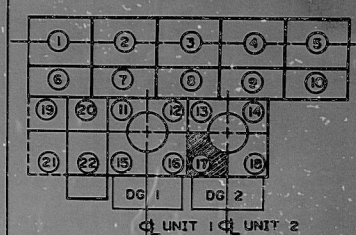

KEY PLAN

- NOTES:
- FOR CONTINUATION OF RACEWAYS UP SEE E-1250 AND DOWN SEE E-1252.
 - FIELD ENGINEERING SHALL VERIFY ALL SUPPORTS FOR ADEQUACY AND COMPLETENESS.
 - MINIMUM SIZE OF ELECTRICAL OPENING FOR 24 INCHES TRAY ARE 1'-0" X 2'-6".

- REFERENCE DRAWINGS:
- E-1500 RACEWAY SCHEDULES
 - E-1406 CONDUIT AND CABLE TRAY NOTES, SYMBOLS AND DETAILS
 - E-1410 TERMINAL AND PULL BOX NOTES SCHEDULES AND DETAILS
 - SPM-309 PIPING AND MECHANICAL-REACTOR ENCLOSURE UNIT 2 PLAN AT EL. 201'-0" AREA 17
 - M-309 PIPING AND MECHANICAL-REACTOR ENCLOSURE UNIT 2 PLAN AT EL. 201'-0" AREA 17
 - M-132 EQUIPMENT LOCATION-REACTOR ENCLOSURE UNIT 2 PLAN AT EL. 211'-0" AREA 17
 - M-1543 INSTRUMENT LOCATION-REACTOR ENCLOSURE UNIT 2 PLAN AT EL. 201'-0" AREA 17
 - M-166 HEATING AND VENTILATING-REACTOR ENCLOSURE UNIT 2 PLAN AT EL. 201'-0" AREA 17
 - C-119 REACTOR ENCLOSURE UNIT 2 FLOOR PLAN AT EL. 201'-0" AREA 17
 - M-1548 INSTRUMENT LOCATION-REACTOR ENCLOSURE UNIT 2-TUNNEL AT EL. 198'-0" AREAS 17 & 18

DATE	REVISION	BY	CHKD	APPD
11/83	1	R.G.GARCIA	CADD/RG	AS-48
SCALE 1/4" = 1'-0"				
BECHTEL SAN FRANCISCO				
LIMERICK GENERATING STATION UNITS 1 & 2 PHILADELPHIA ELECTRIC COMPANY				
RACEWAY LAYOUT-REACTOR ENCL. 2 UNIT COLUMNS D-G & 23-27.5 (AREA 17) PLAN EL. 201'-0" SLAB & ABOVE				
JOB NO.	DRAWING NO.	SHEET	REV	
8031	E-1256	2 OF 2	1	

NOTE: THIS DWG. IS FOR TRAY AND GUTTER INSTALLATION ONLY.
USE THIS DRAWING FOR ELECTRICAL WORK ONLY.
BACKGROUND EQUIPMENT MAY NOT BE CORRECT AS TO LOCATION OR SIZE.

PDR RIDS

8702190626

