X-19

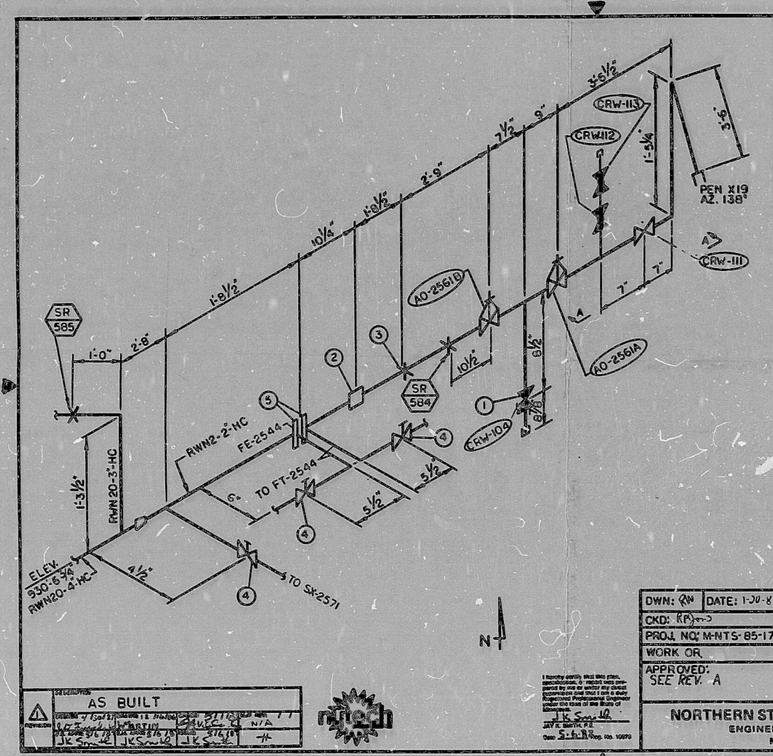

ITEM NO	DESCRIPTION
1	1"Ø HAND OPERATED VALVE
2	2"Ø S.W. COUPLING
3	ROD HANGER
4	¾ Ø X ¼ Ø HAND OPERATED VALVE
5	2"Ø STD FLANGES, S.W., 150# ASA, REF BECHTEL SPEC. M-40

NOTES
1. REF. P&ID: M-138 (NH-36044).
2. REF. FSK-746 FOR MORE INFO ON RWN2-2"HC.
3. ALL DIMENSIONS EXCEPT SUPPORT AND VALVE LOCATIONS (SR-584&5, CRW-111/112/113) ARE REF.
4. FOR SR-584 SEE DWG NL-88967.
5. FOR SR-585 SEE DWG NL-88968.

REVISIONS

A	AS BUILT: INCORPORATE THIS DWG. INTO NSP DWG. SYSTEM PER NDR: MO-564 DWN: DP 1-20-88 CHK: 1-26-88 MOD: 83M112 FILMED: 2-4-88

SIZE D RD

DWN: RN	DATE: 1-20-86	SIGNIFICANT NO	8700	—	200	1	4430 9072	29110
CKD: KR		GROUP	1	2	3	4	5	6
PROJ. NO: M-NTS-85-17		MONTICELLO NUCLEAR GENERATING PLANT MONTICELLO, MN						
WORK OR								
APPROVED: SEE REV. A		DRYWELL EQUIP DRAIN SUMP, APP. J LINE: RWN2-2"HC; DC-83M112; MOD. #6						

NORTHERN STATES POWER COMPANY
ENGINEERING DEPARTMENT
MINNEAPOLIS

SCALE NONE REV. A

FSK-746-1 SHT. 1 OF 2

AS BUILT

X-19

ANSTEC APERTURE CARD

9711180174

PDR RIDS

9711180174

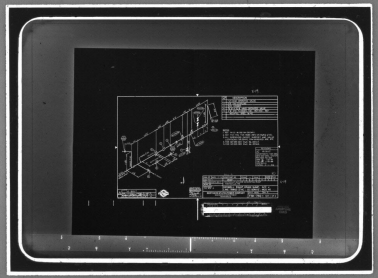

MMM 5824 FILMSORT® & DUPLICARD® Cards

3M St. Paul, MN