

SCALE RULES

E-1266 SHEET 1 OF 3

H

G

F

E

D

C

B

A

MATCH LINE - FOR CONTINUATION SEE DWG E-1111, E1126, E1127 AND E1183 SH. 2

MATCH LINE - FOR CONTINUATION SEE DWG E-1167

MATCHLINE - FOR CONTINUATION SEE DWG E-1216 AND E-1218

SEE PARTIAL PLAN A

MATCH LINE - FOR CONTINUATION SEE DWG E-1267

MATCH LINE - FOR CONTINUATION SEE DWG E-1268

SECTION A
SCALE: N.T.S.


SECTION B
SCALE: N.T.S.

PARTIAL PLAN - A

FOR CONSTRUCTION USE					
RACEWAYS					
ADDED	REVISED	DELETED	DATE	BY	REASON
2A1271	2A140	2C1053	06-27-85	R.G.GARCIA	C-6
2A142	2A140	2C1053	06-27-85	R.G.GARCIA	C-6
2A143	2A140	2C1053	06-27-85	R.G.GARCIA	C-6
2C1013	2A140	2C1053	06-27-85	R.G.GARCIA	C-6
2C1044	2A140	2C1053	06-27-85	R.G.GARCIA	C-6

NOTES: THIS DWG. IS FOR EXPOSED CONDUIT INSTALLATION ONLY. FOR CABLE TRAY AND GUTTER INSTALLATION SEE SHEET 2.

USE THIS DRAWING FOR ELECTRICAL WORK ONLY. BACKGROUND EQUIPMENT MAY NOT BE CORRECT AS TO LOCATION OR SIZE.

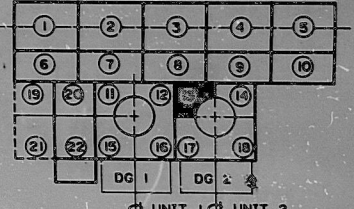

KEY PLAN

NOTES:

- FOR CONTINUATION OF RACEWAYS UP SEE DWG. E-1270 AND DOWN SEE E-1262.
- FOR CABLE TRAYS AND EMBEDDED CONDUITS SEE SHEET 2 AND 3 RESPECTIVELY.
- IF PVC SLEEVES ARE USED, PROVIDE AN ADDITIONAL 1/2" PVC SLEEVE AT EACH GROUP OF SLEEVES FOR FUTURE GROUNDING OF EXPOSED R.S. CONDUIT EXTENSION.
- SPECIAL PRECAUTION MUST BE TAKEN WHEN LOCATING & EQUIPMENT NEAR FLOOD LEVELS. FOR INSTALLATION OF E. EQUIPMENT SEE ARCHITECTURAL DRAWINGS 8031-A-309, NOTE 2 AND 8031-A-310, NOTE 2.

REFERENCE DRAWINGS:

- E-1500 RACEWAY SCHEDULES
- E-1406 & CONDUIT AND CABLE TRAY NOTES, SYMBOLS AND DETAILS
- E-1410 TERMINAL AND PULL BOX NOTES SCHEDULES AND DETAILS
- SPM-292 PIPING AND MECHANICAL-REACTOR ENCLOSURE UNIT 2 PLAN AT EL.283'-0" AREA 13
- M-292 PIPING AND MECHANICAL-REACTOR ENCLOSURE UNIT 2 PLAN AT EL.283'-0" AREA 13
- M-135 EQUIPMENT LOCATION-REACTOR ENCLOSURE UNIT 2 PLAN AT EL.283'-0" AREA 13
- M-1534 INSTRUMENT LOCATION-REACTOR ENCLOSURE UNIT 2 PLAN AT EL.283'-0" AREA 13
- M-1153 HEATING AND VENTILATING-REACTOR ENCLOSURE UNIT 2 PLAN AT EL.283'-0" AREA 13
- C-142 REACTOR ENCLOSURE UNIT 2 FLOOR PLAN AT EL.283'-0" AREA 13

REVISIONS

NO.	DATE	REVISION	BY	CHKD.	APPD.
1	06-27-85	ADDED, REVISED AND DELETED CONDUITS AS SHOWN	R.G.GARCIA		

SCALE: 1/4" = 1'-0"

BECHTEL
SAN FRANCISCO

LIMERICK GENERATING STATION UNITS 1 & 2
PHILADELPHIA ELECTRIC COMPANY

RACEWAY LAYOUT-REACTOR ENCL. 2 UNIT COLUMNS 6-J & 23-27.5 (AREA 13) PLAN EL. 283'-0" SLAB & ABOVE

JOB NO. 8031
DRAWING NO. E-1266
SHEET 1 OF 3

PDR RIDS

8702240012

