




PDR RIDS

9604250241

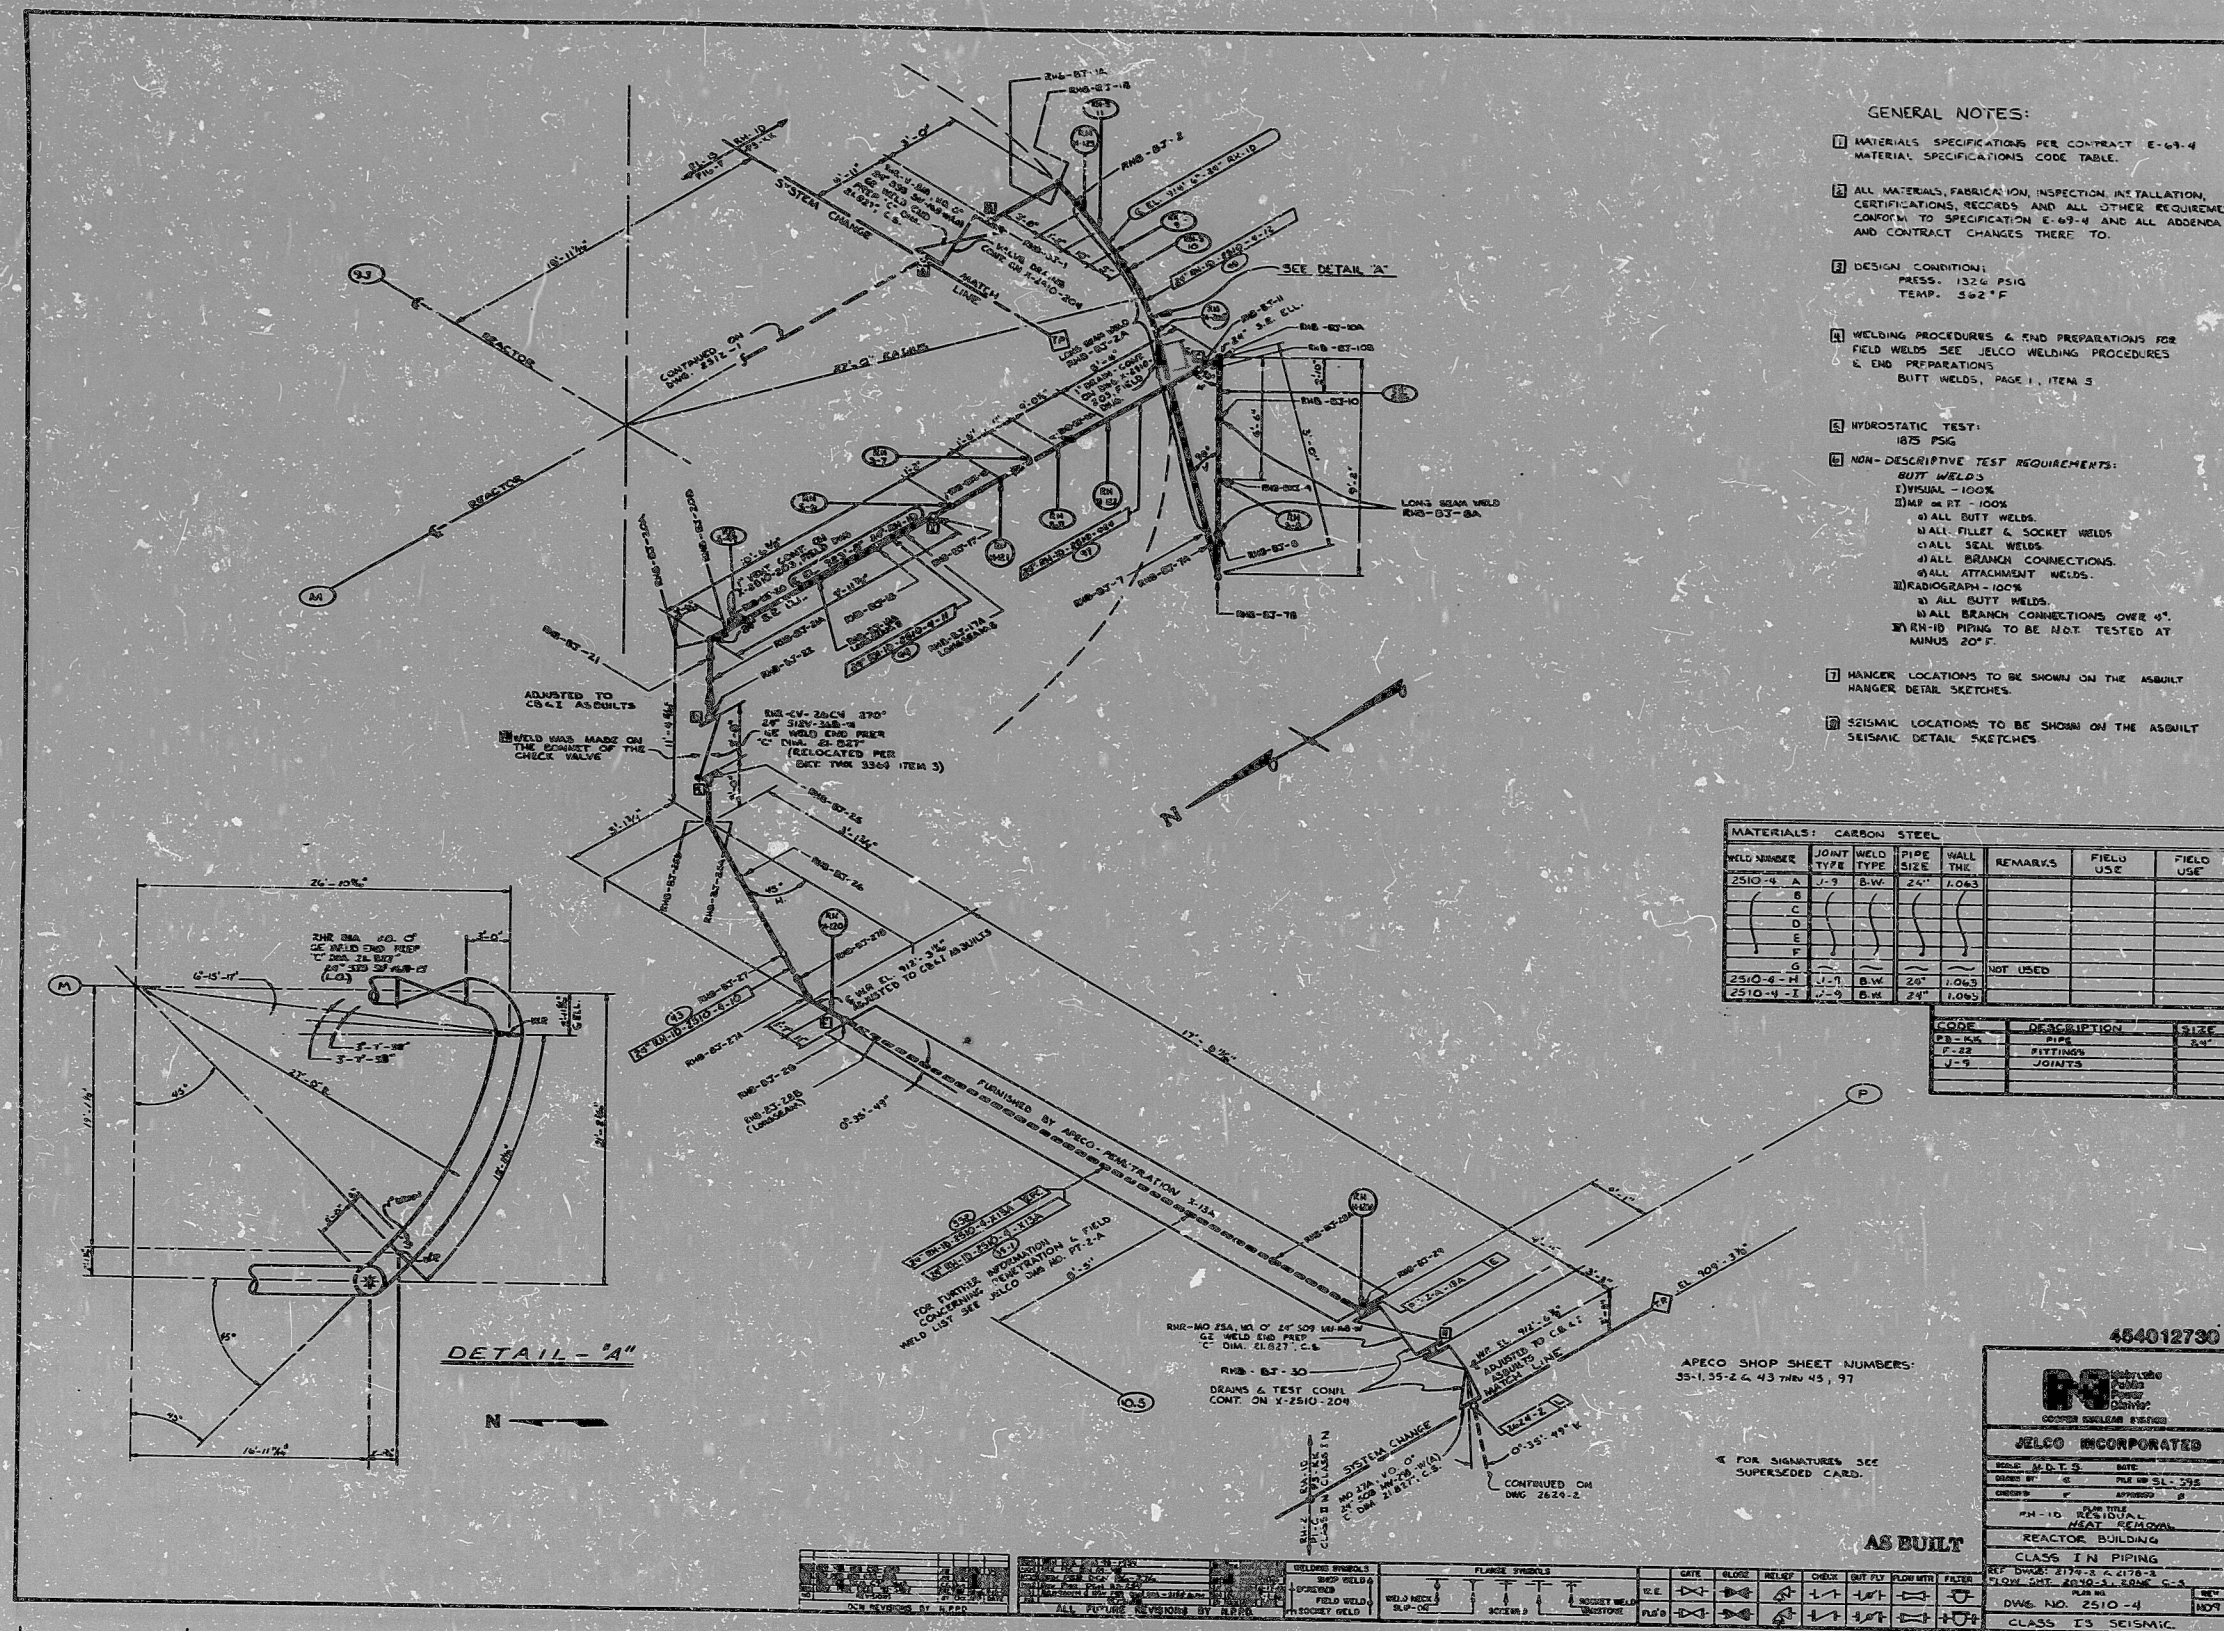