


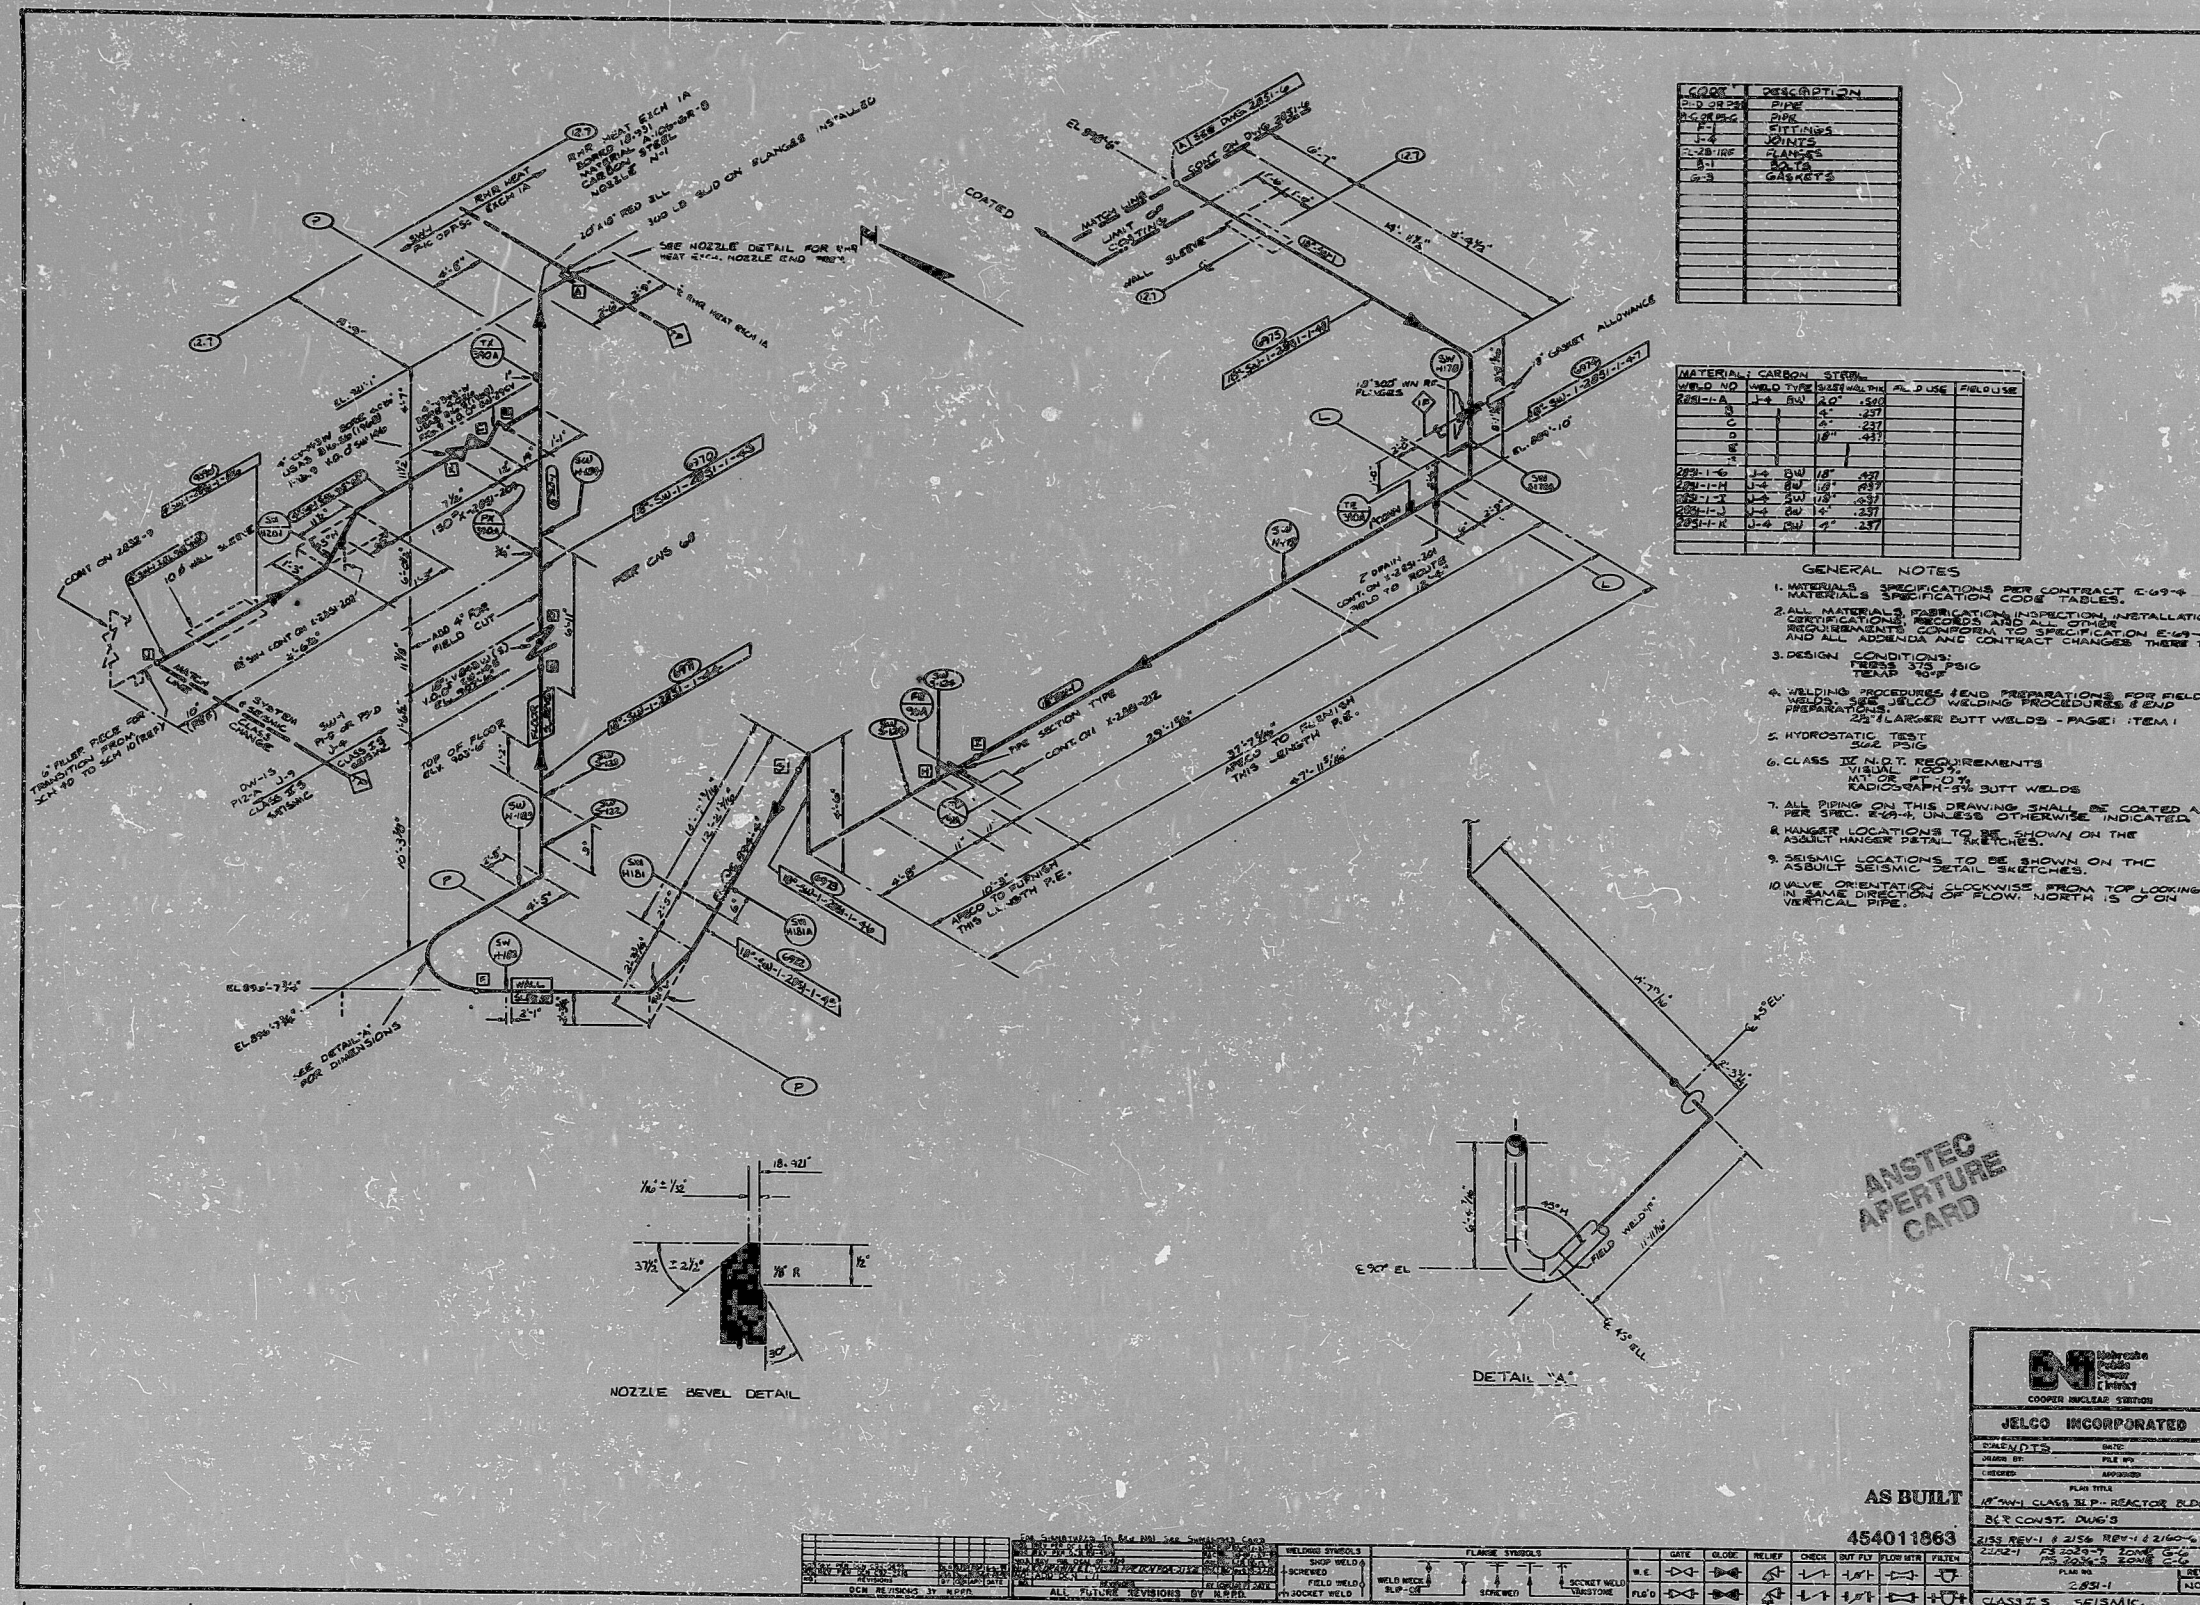



PDR RIDS

9604260056

