




PDR RIDS

9604260059

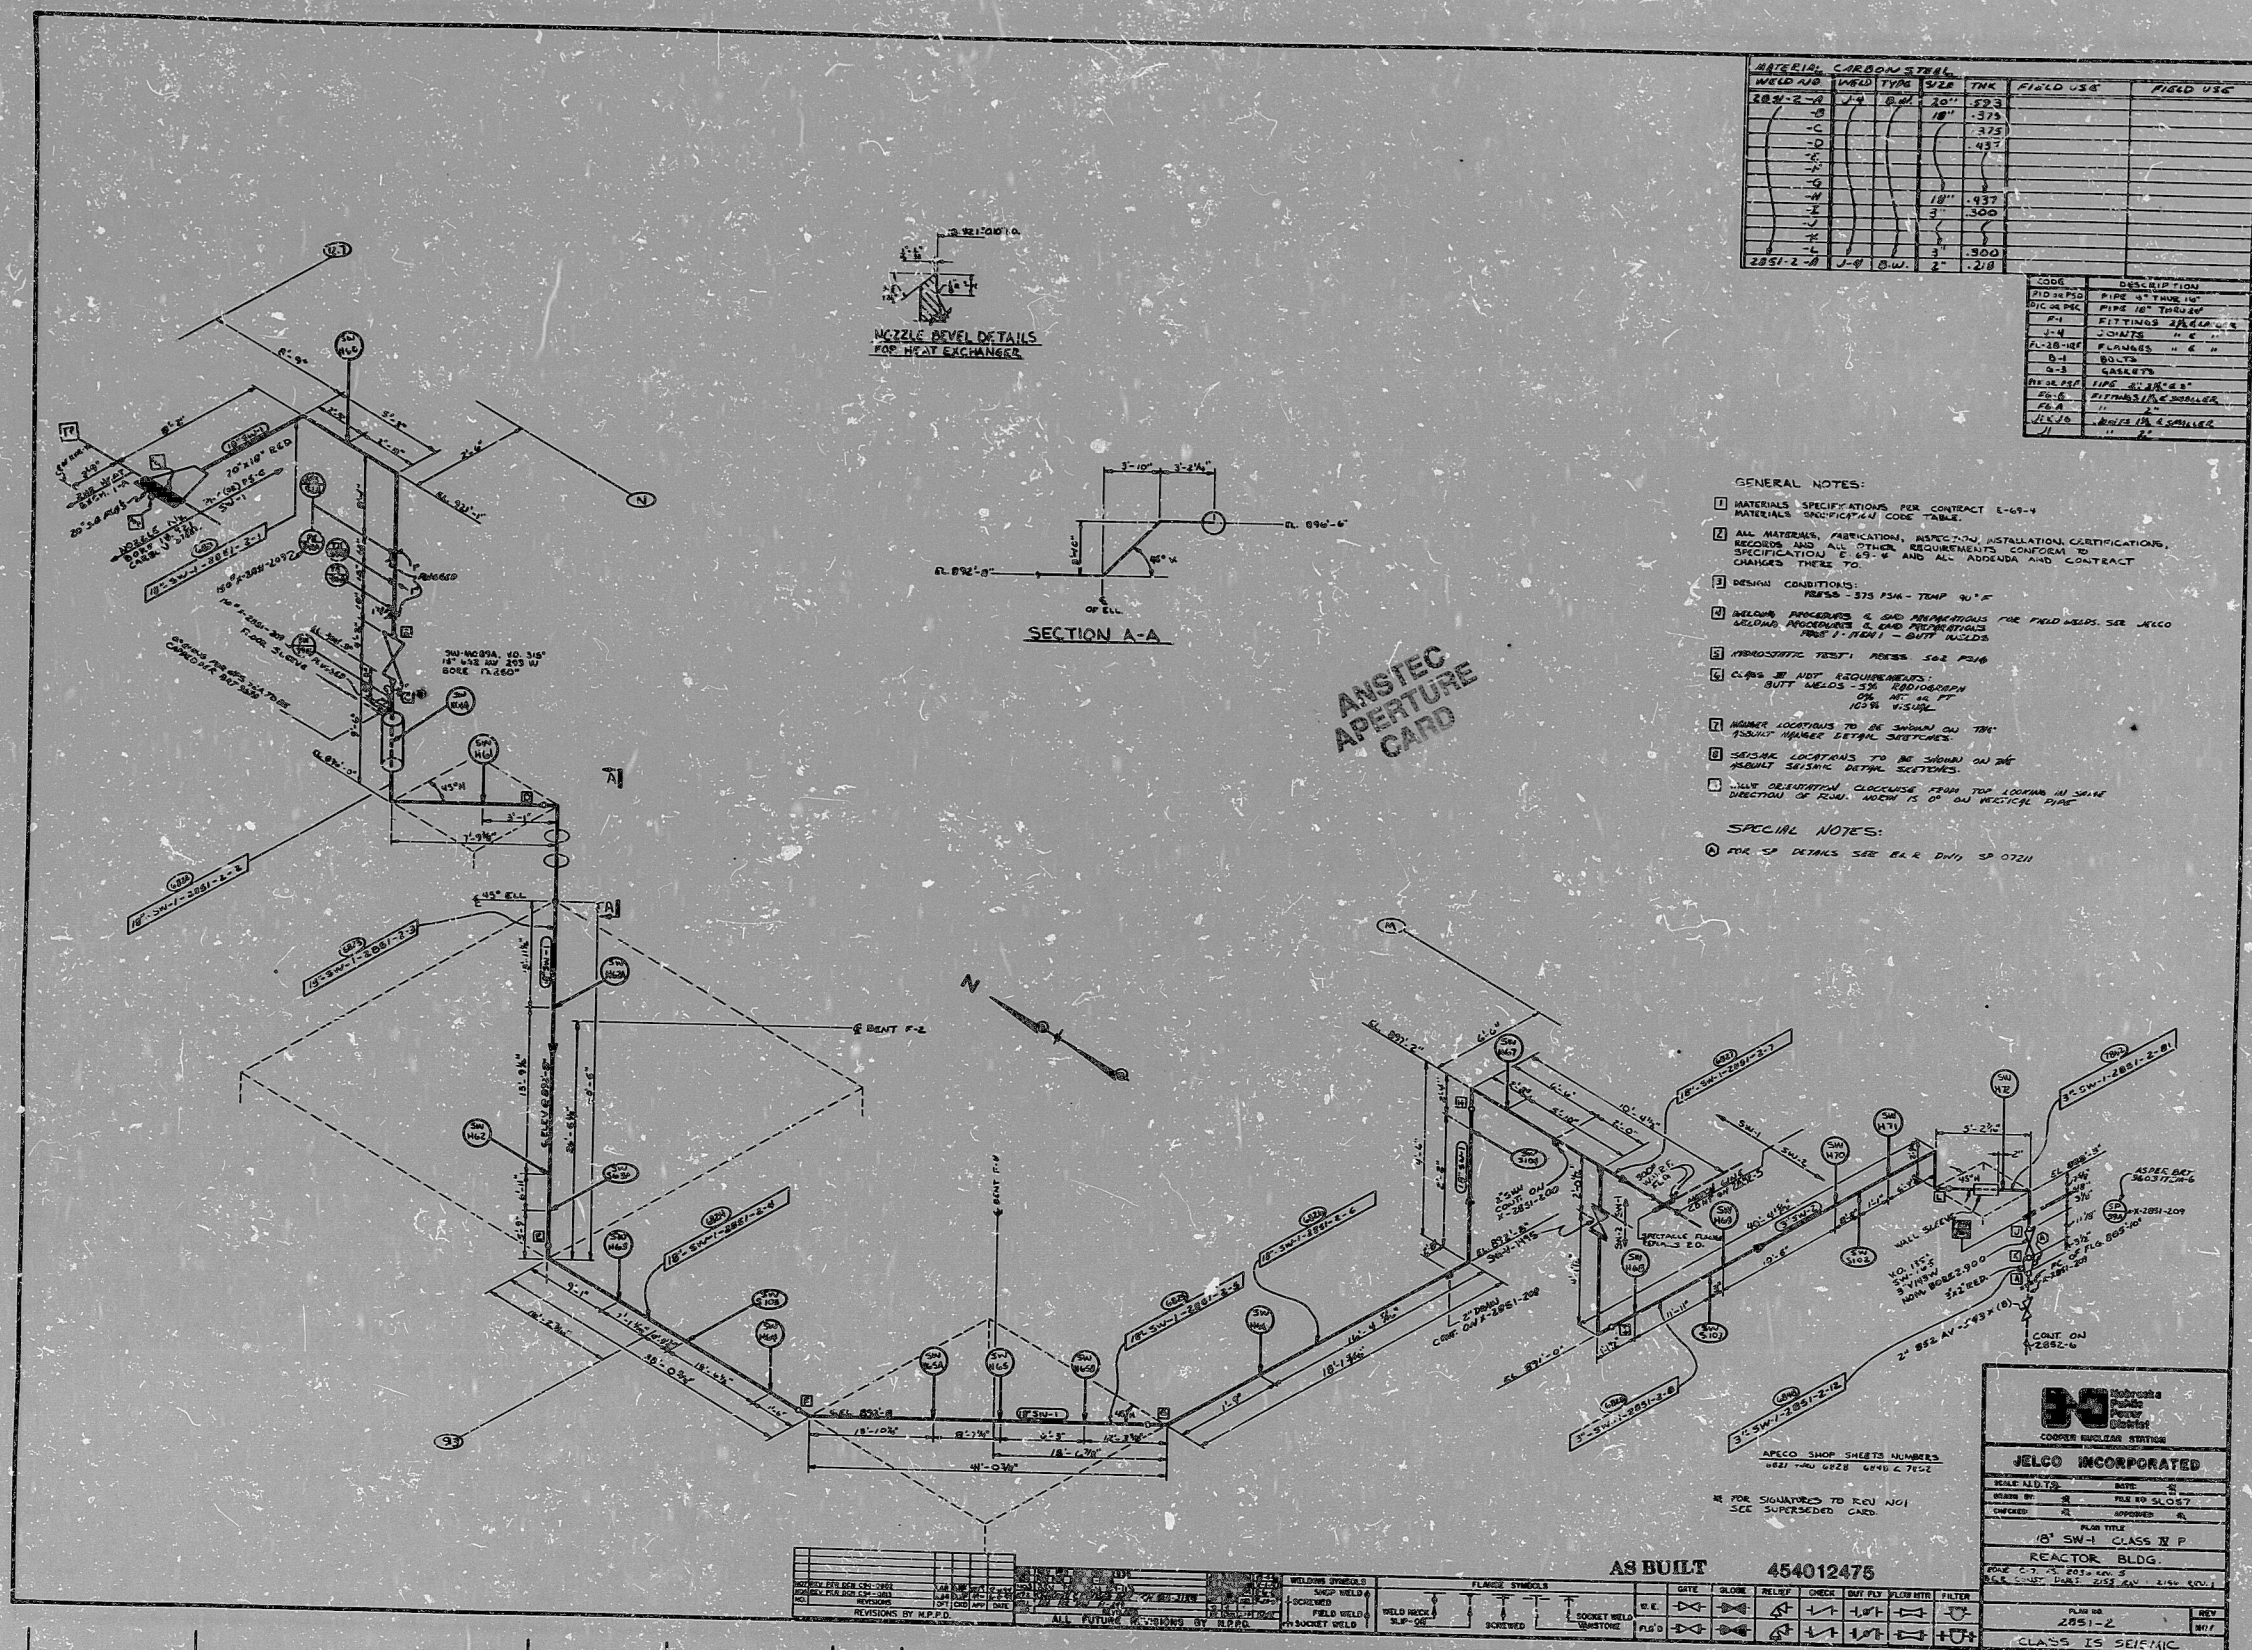