


27  
26  
25  
24  
23  
22  
21  
20  
19  
18  
17  
16  
15  
14  
13  
12  
11  
10  
9  
8  
7  
6  
5  
4  
3  
2  
1



Notes: Reference may be made to Plan No 1455A dated July 17, 1985, showing the Breakwater Surveys from July 1981 to July 1987.

SI  
APERTURE  
CARD

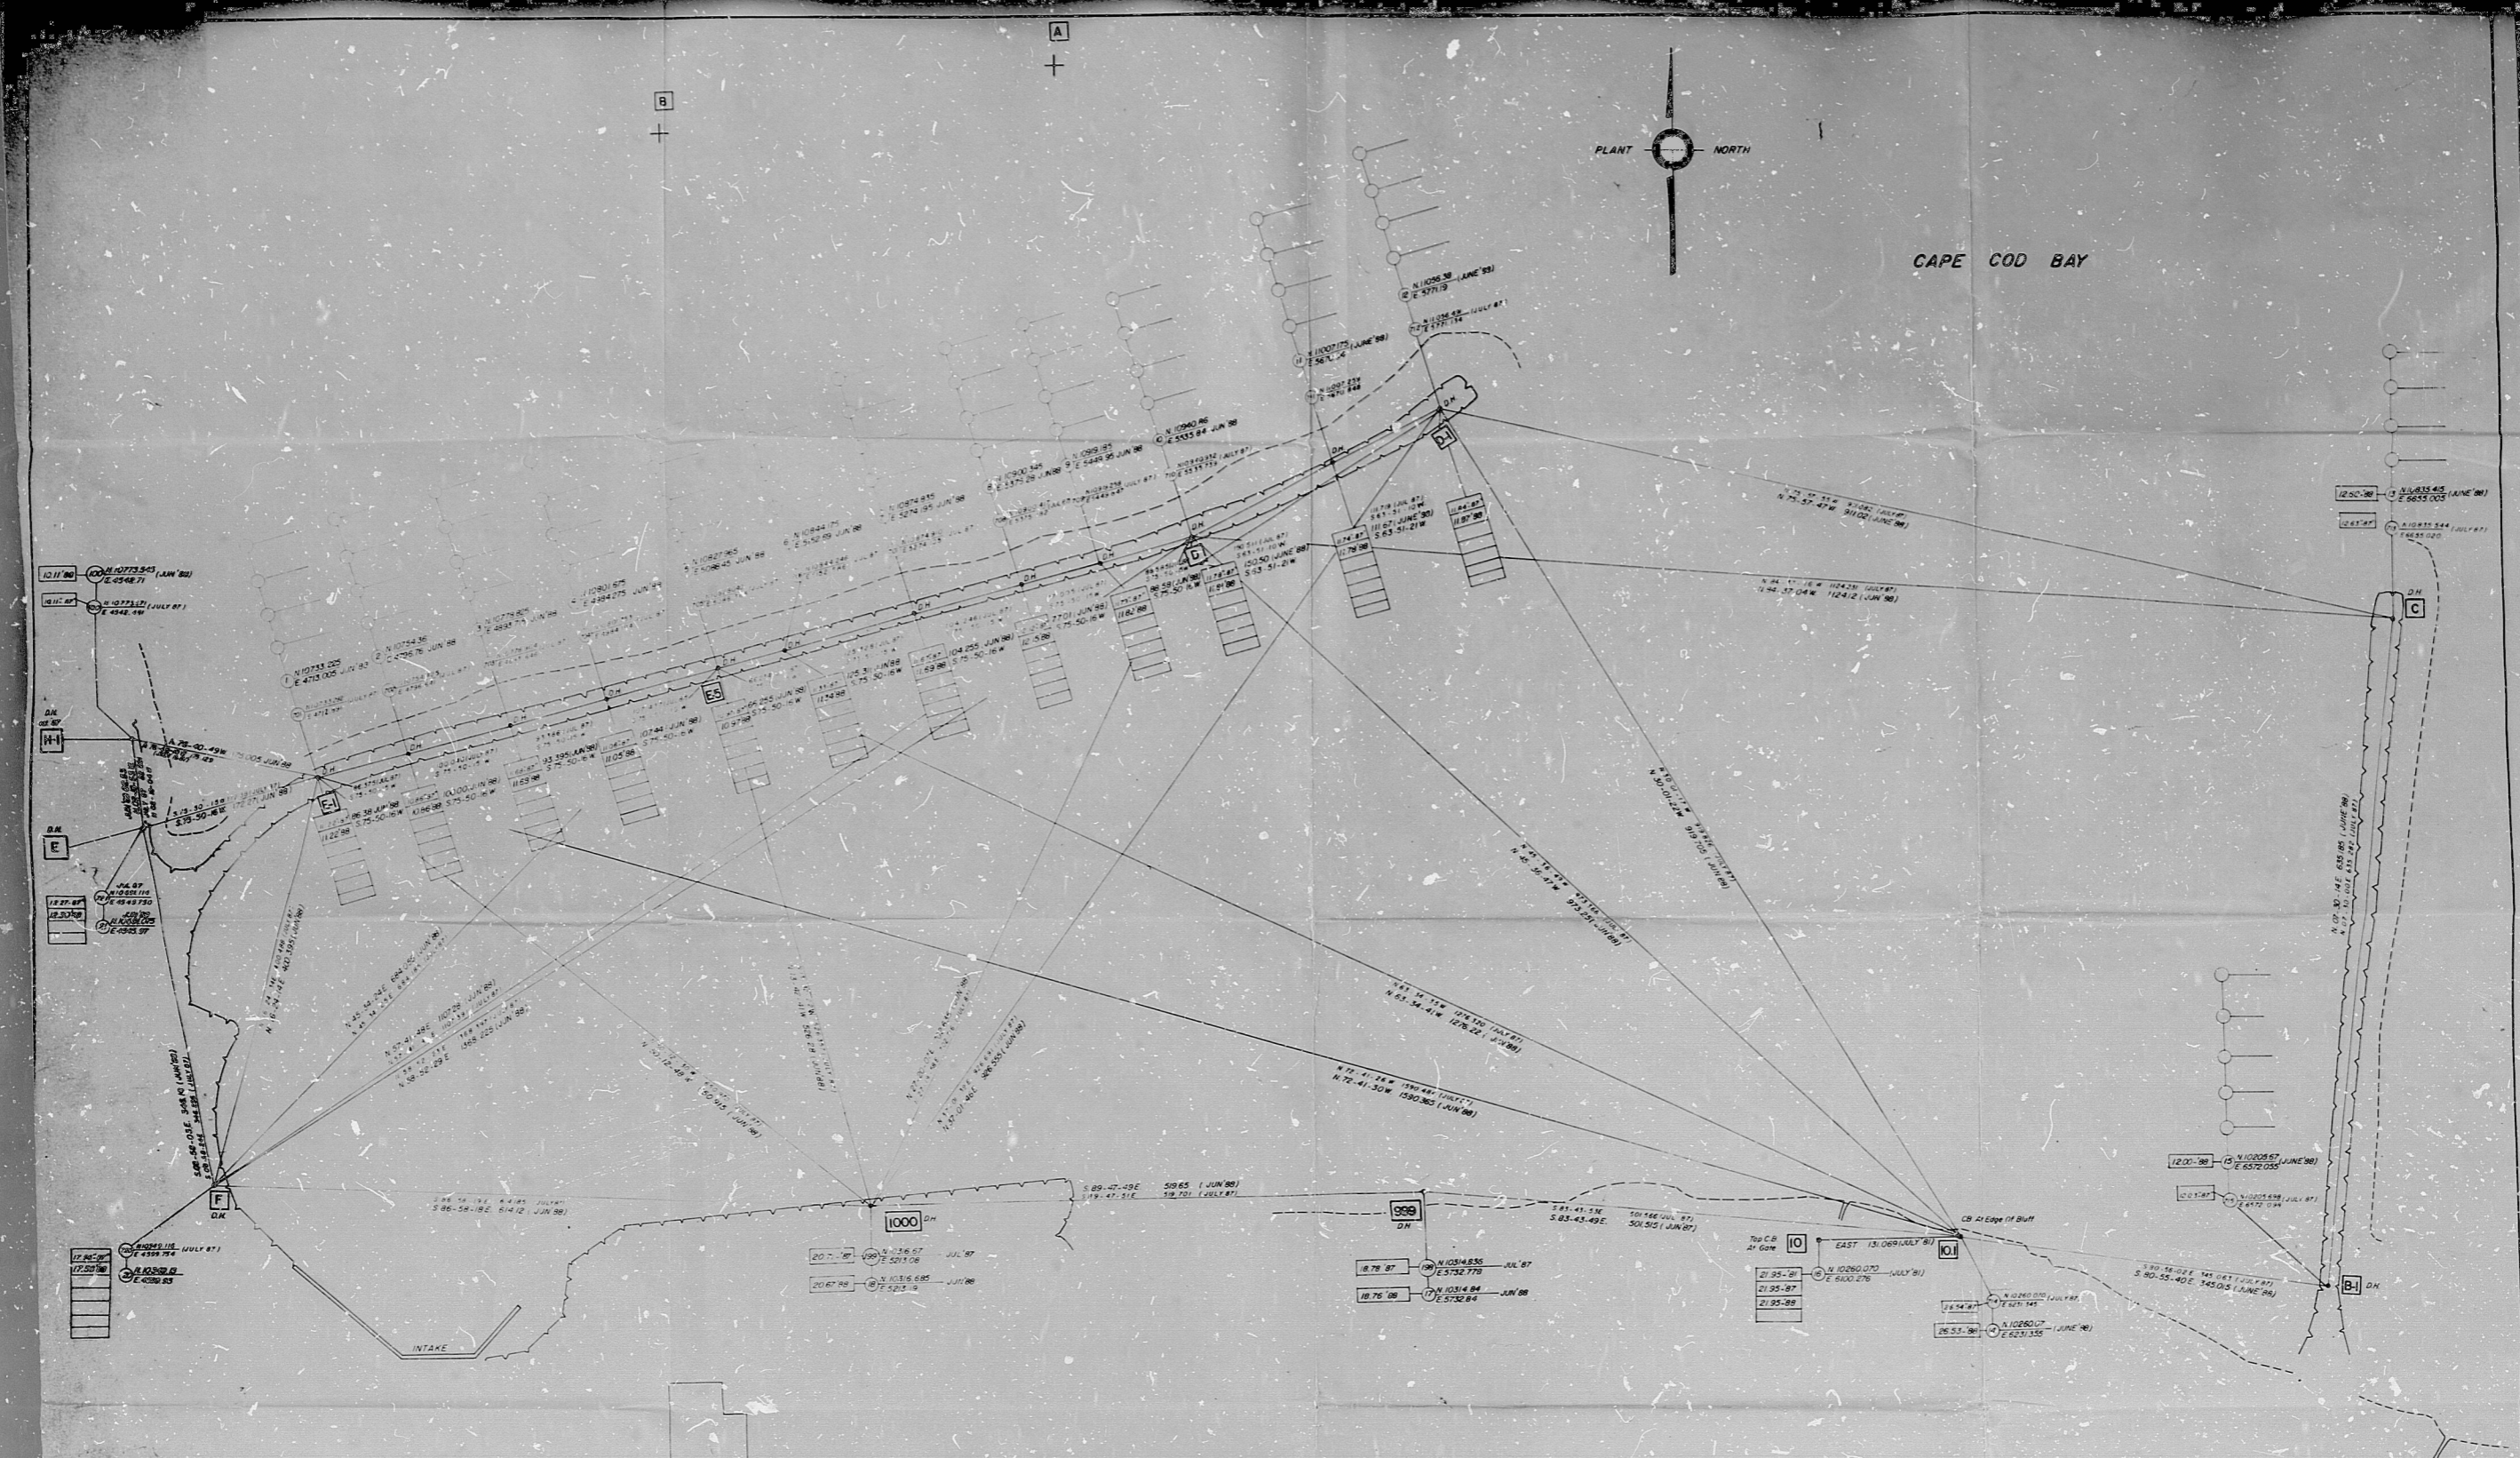

REVISIONS		WORKSHEET SHOWING BREAKWATERS, CHANNELS AND SOUNDINGS ROCKY HILL ROAD AREA, PLYMOUTH, MA	
		DESIGNED BY BOSTON EDISON COMPANY	THE BSC GROUP - NORWELL, INC. 293 R WASHINGTON ST NORWELL, MASS 02061
		DRAWN BY H.L.J.	DATE JULY 25, 1988
		TITLE MAIN BREAKWATER CAMERA LOCATIONS & SURVEY INFORMATION	Scale: 1" = 50'
		PROJECT NO. CI181 SH 2 OF 2	Sheet No. 1455-7 <sup>B</sup>

EO 13526 SURVEY INFORMATION  
NO. DATE BY  
Non Q  
JUL 25 1988  
CI181 SH 2 OF 2  
E.O.



PDR RIDS

8809290028

