


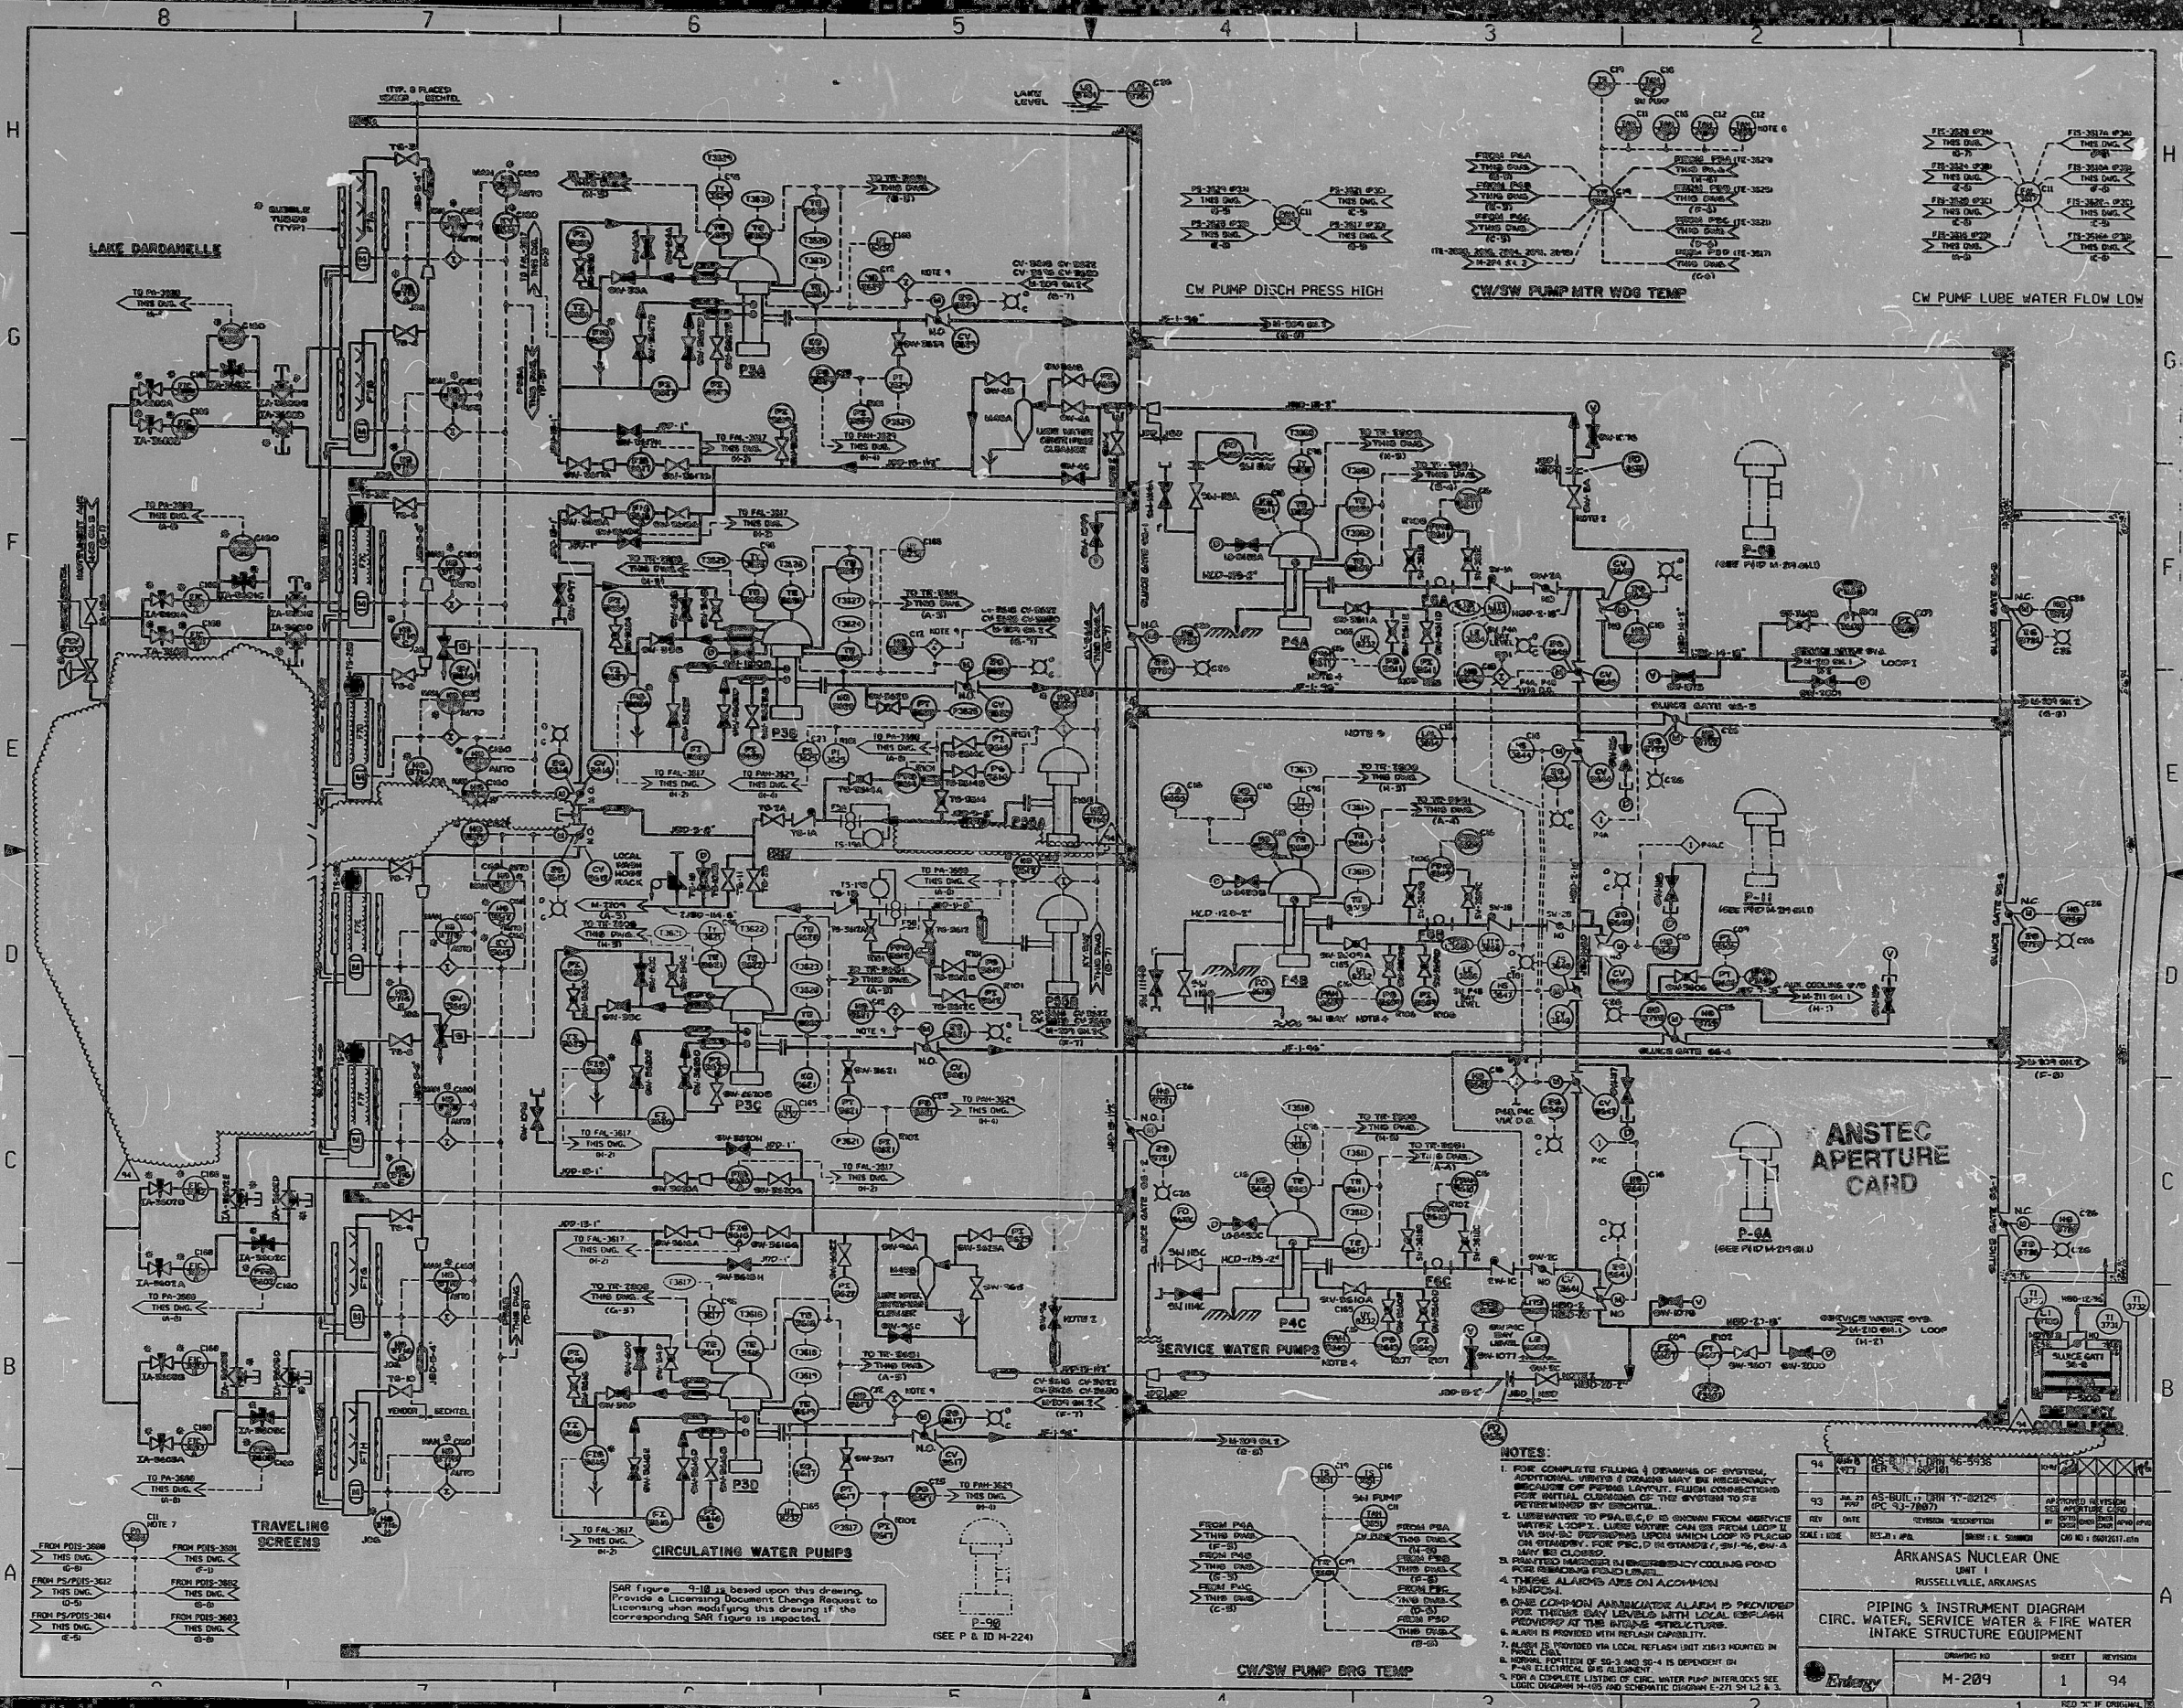

9712170023

PDR RIDS

9712170023

