
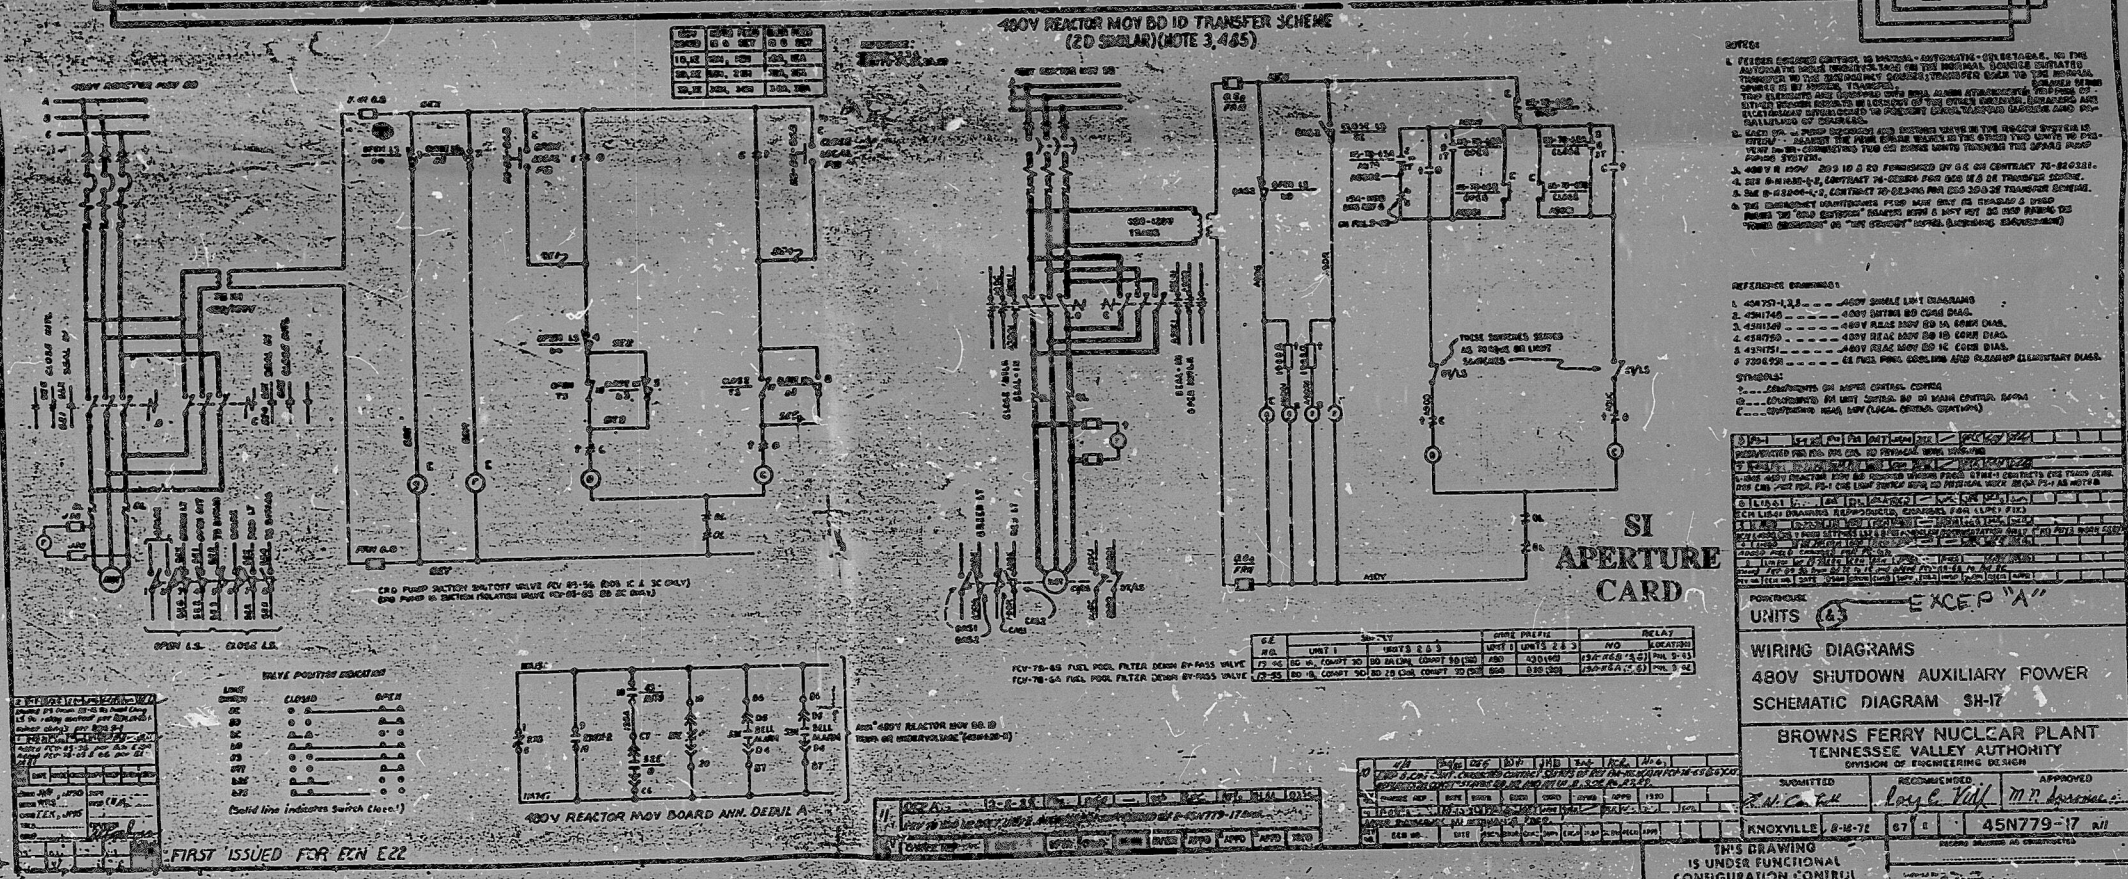



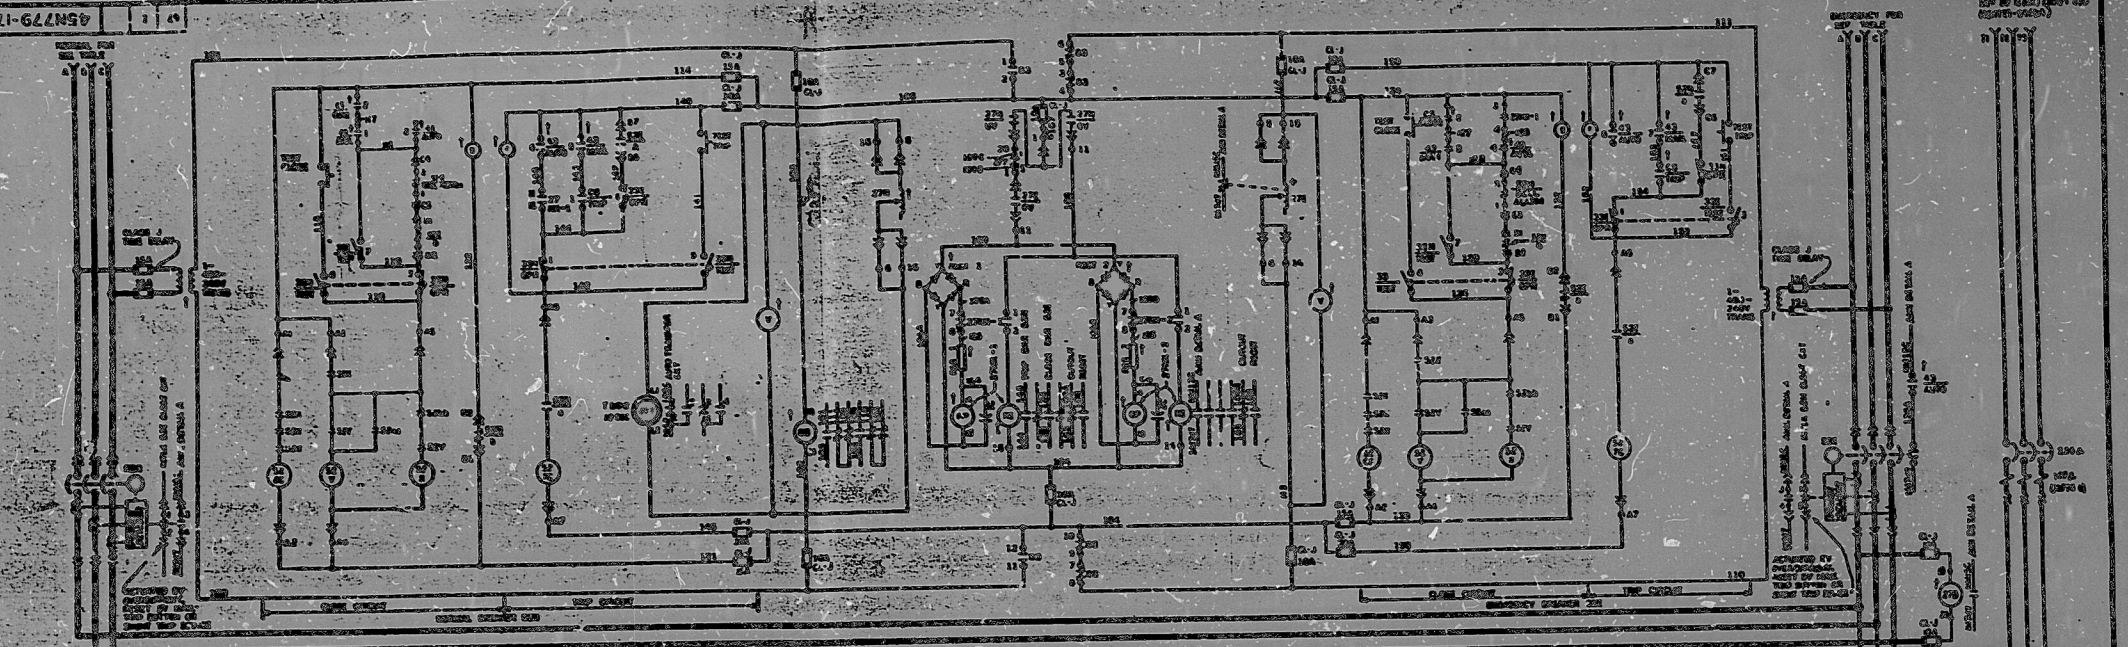


9810130259

FEB 12 1988

1 3 3 3 7

PDR RIDS

8810130259

