


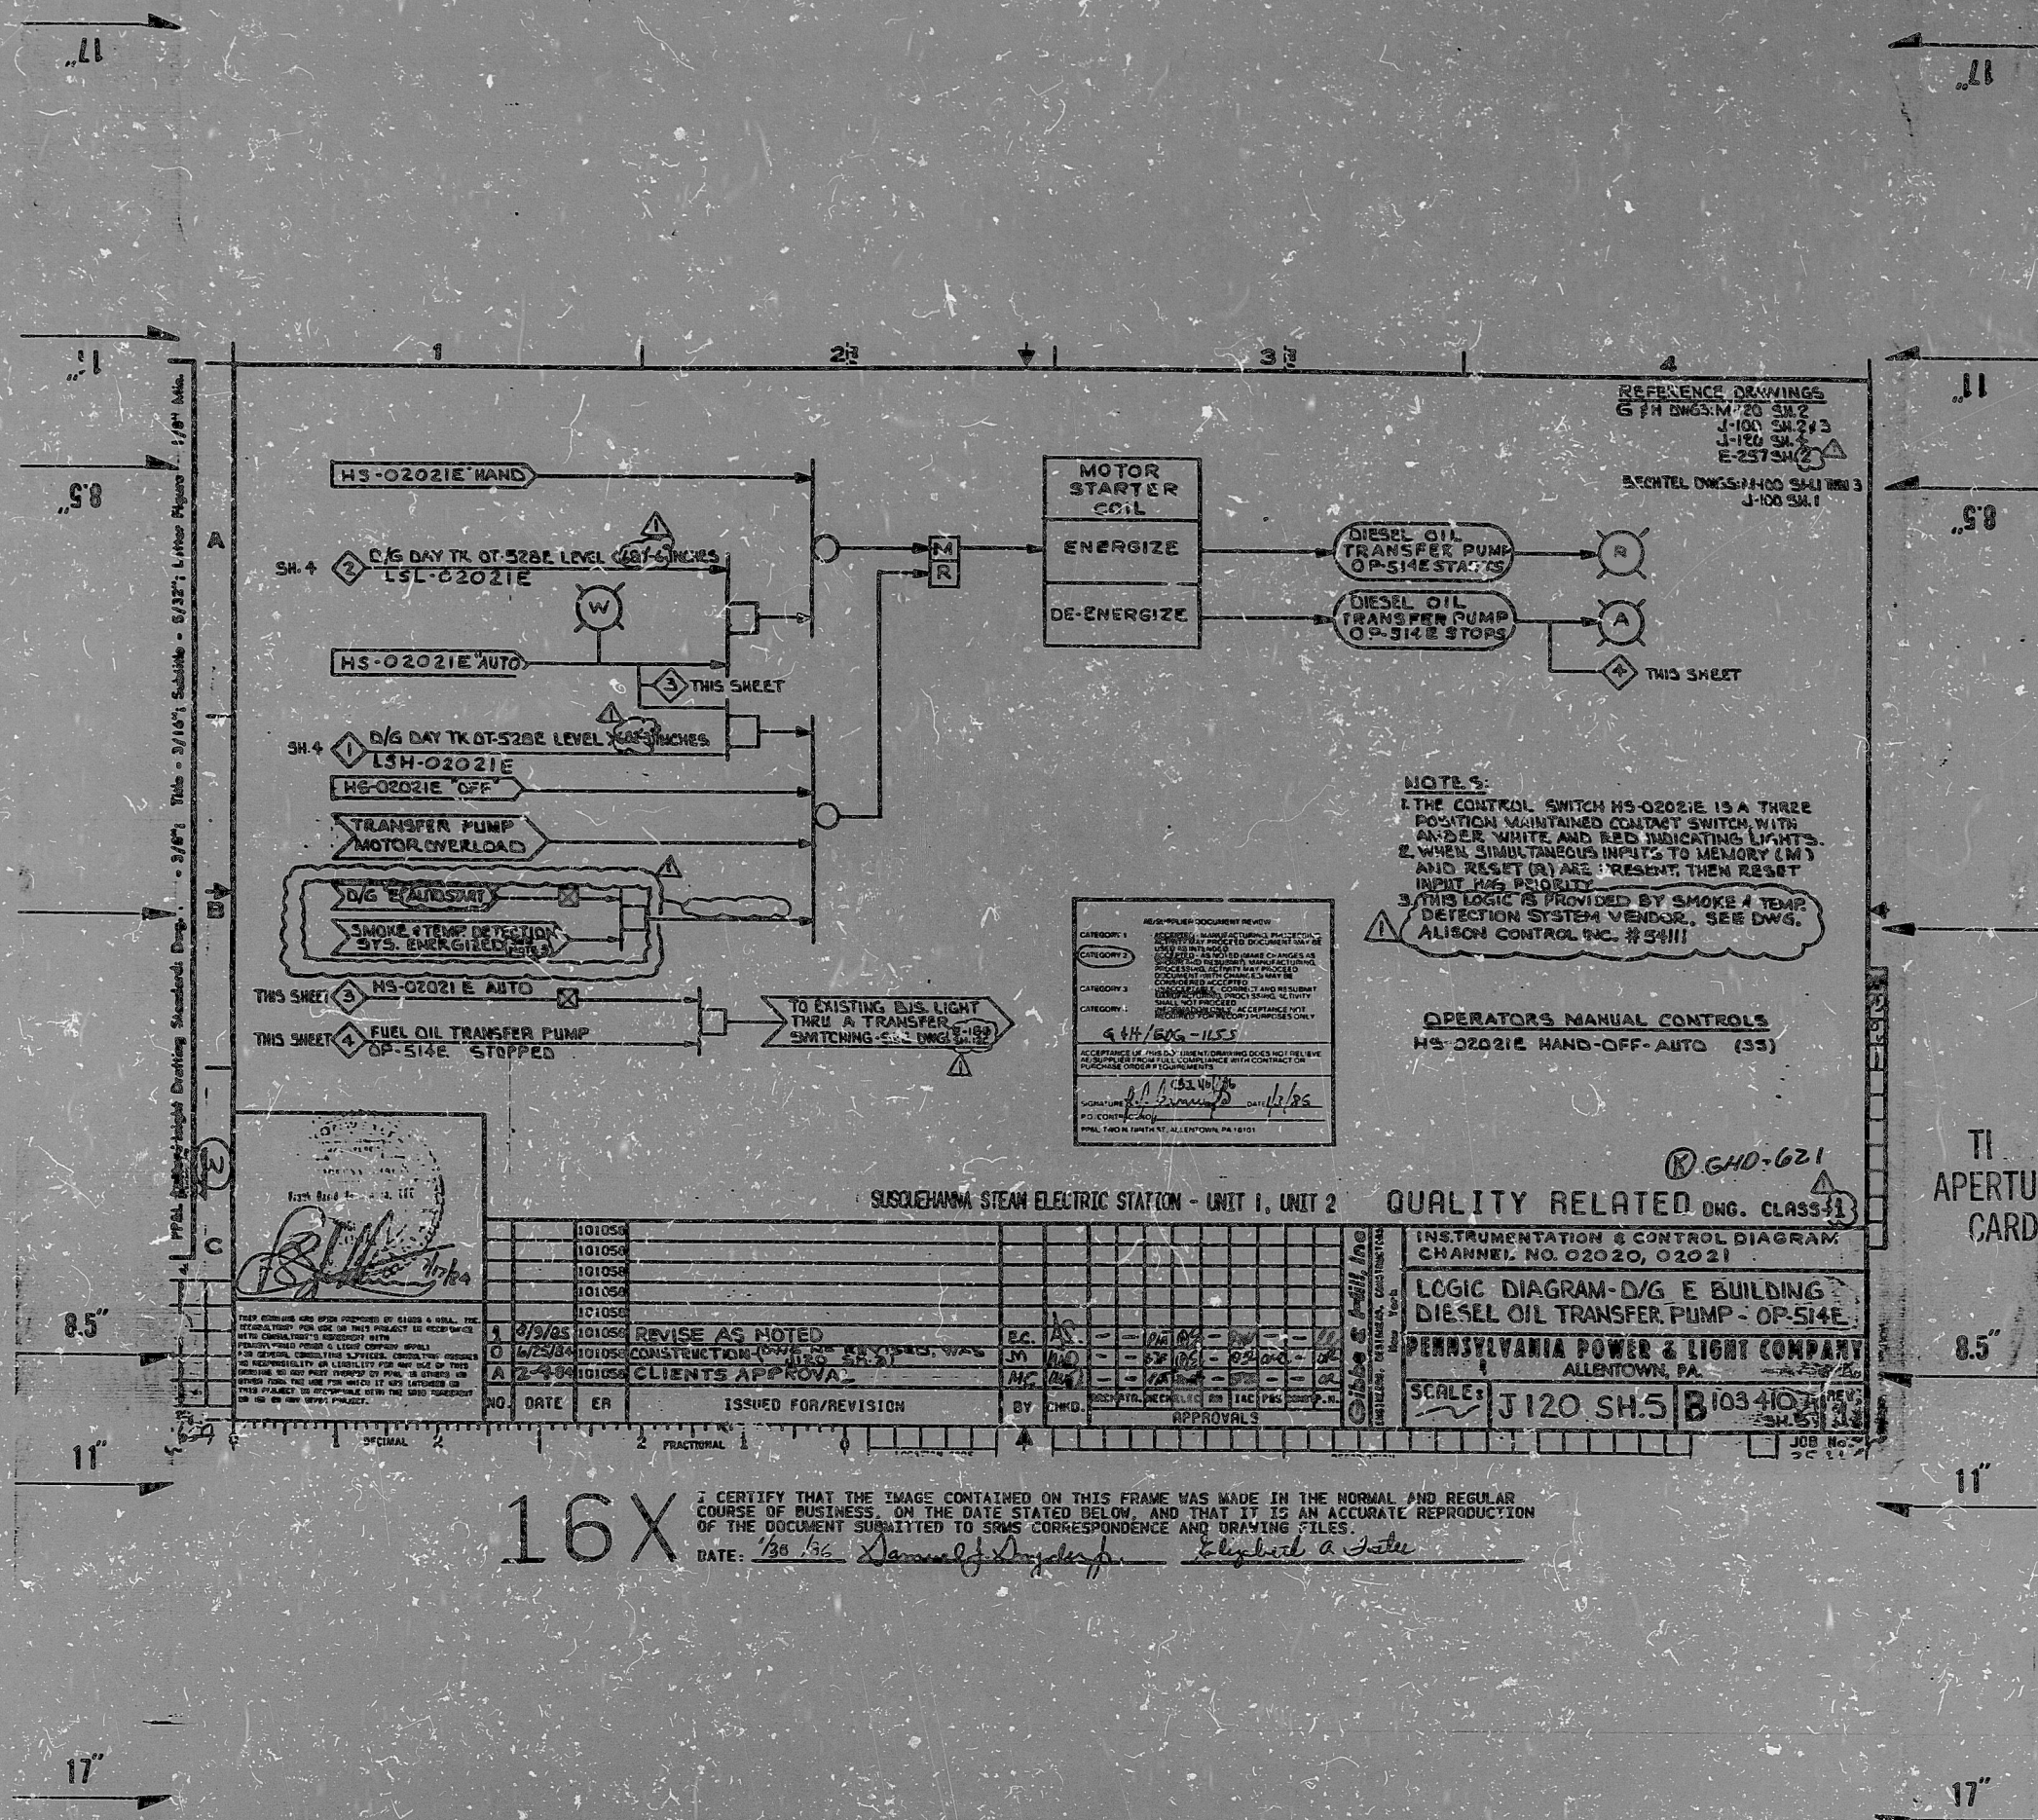

REFERENCE DRAWINGS
G 14 DWSM 120 SM 2
J-100 SM 213
J-100 SM 2
E-257 SM 2
BECHTEL DWSM 1400 SM 1 AND 3
J-100 SM 1

NOTES:
1. THE CONTROL SWITCH HS-02021E IS A THREE POSITION MAINTAINED CONTACT SWITCH WITH UNDER WHITE AND RED INDICATING LIGHTS.
2. WHEN SIMULTANEOUS INPUTS TO MEMORY (M) AND RESET (R) ARE PRESENT, THEN RESET INPUT HAS PRIORITY.
3. THIS LOGIC IS PROVIDED BY SMOKE & TEMP DETECTION SYSTEM VENDOR, SEE DWG. ALISON CONTROL INC. #54111

OPERATORS MANUAL CONTROLS
HS-02021E HAND-OFF-AUTO (33)

TI
APERTURE
CARD

16X

I CERTIFY THAT THE IMAGE CONTAINED ON THIS FRAME WAS MADE IN THE NORMAL AND REGULAR COURSE OF BUSINESS, ON THE DATE STATED BELOW, AND THAT IT IS AN ACCURATE REPRODUCTION OF THE DOCUMENT SUBMITTED TO SRMS CORRESPONDENCE AND DRAWING FILES.
DATE: 1/30/86 *James J. Dwyer* *Elizabeth A. Sater*

PDR RIDS

8603140338

DTC DD AINT

