


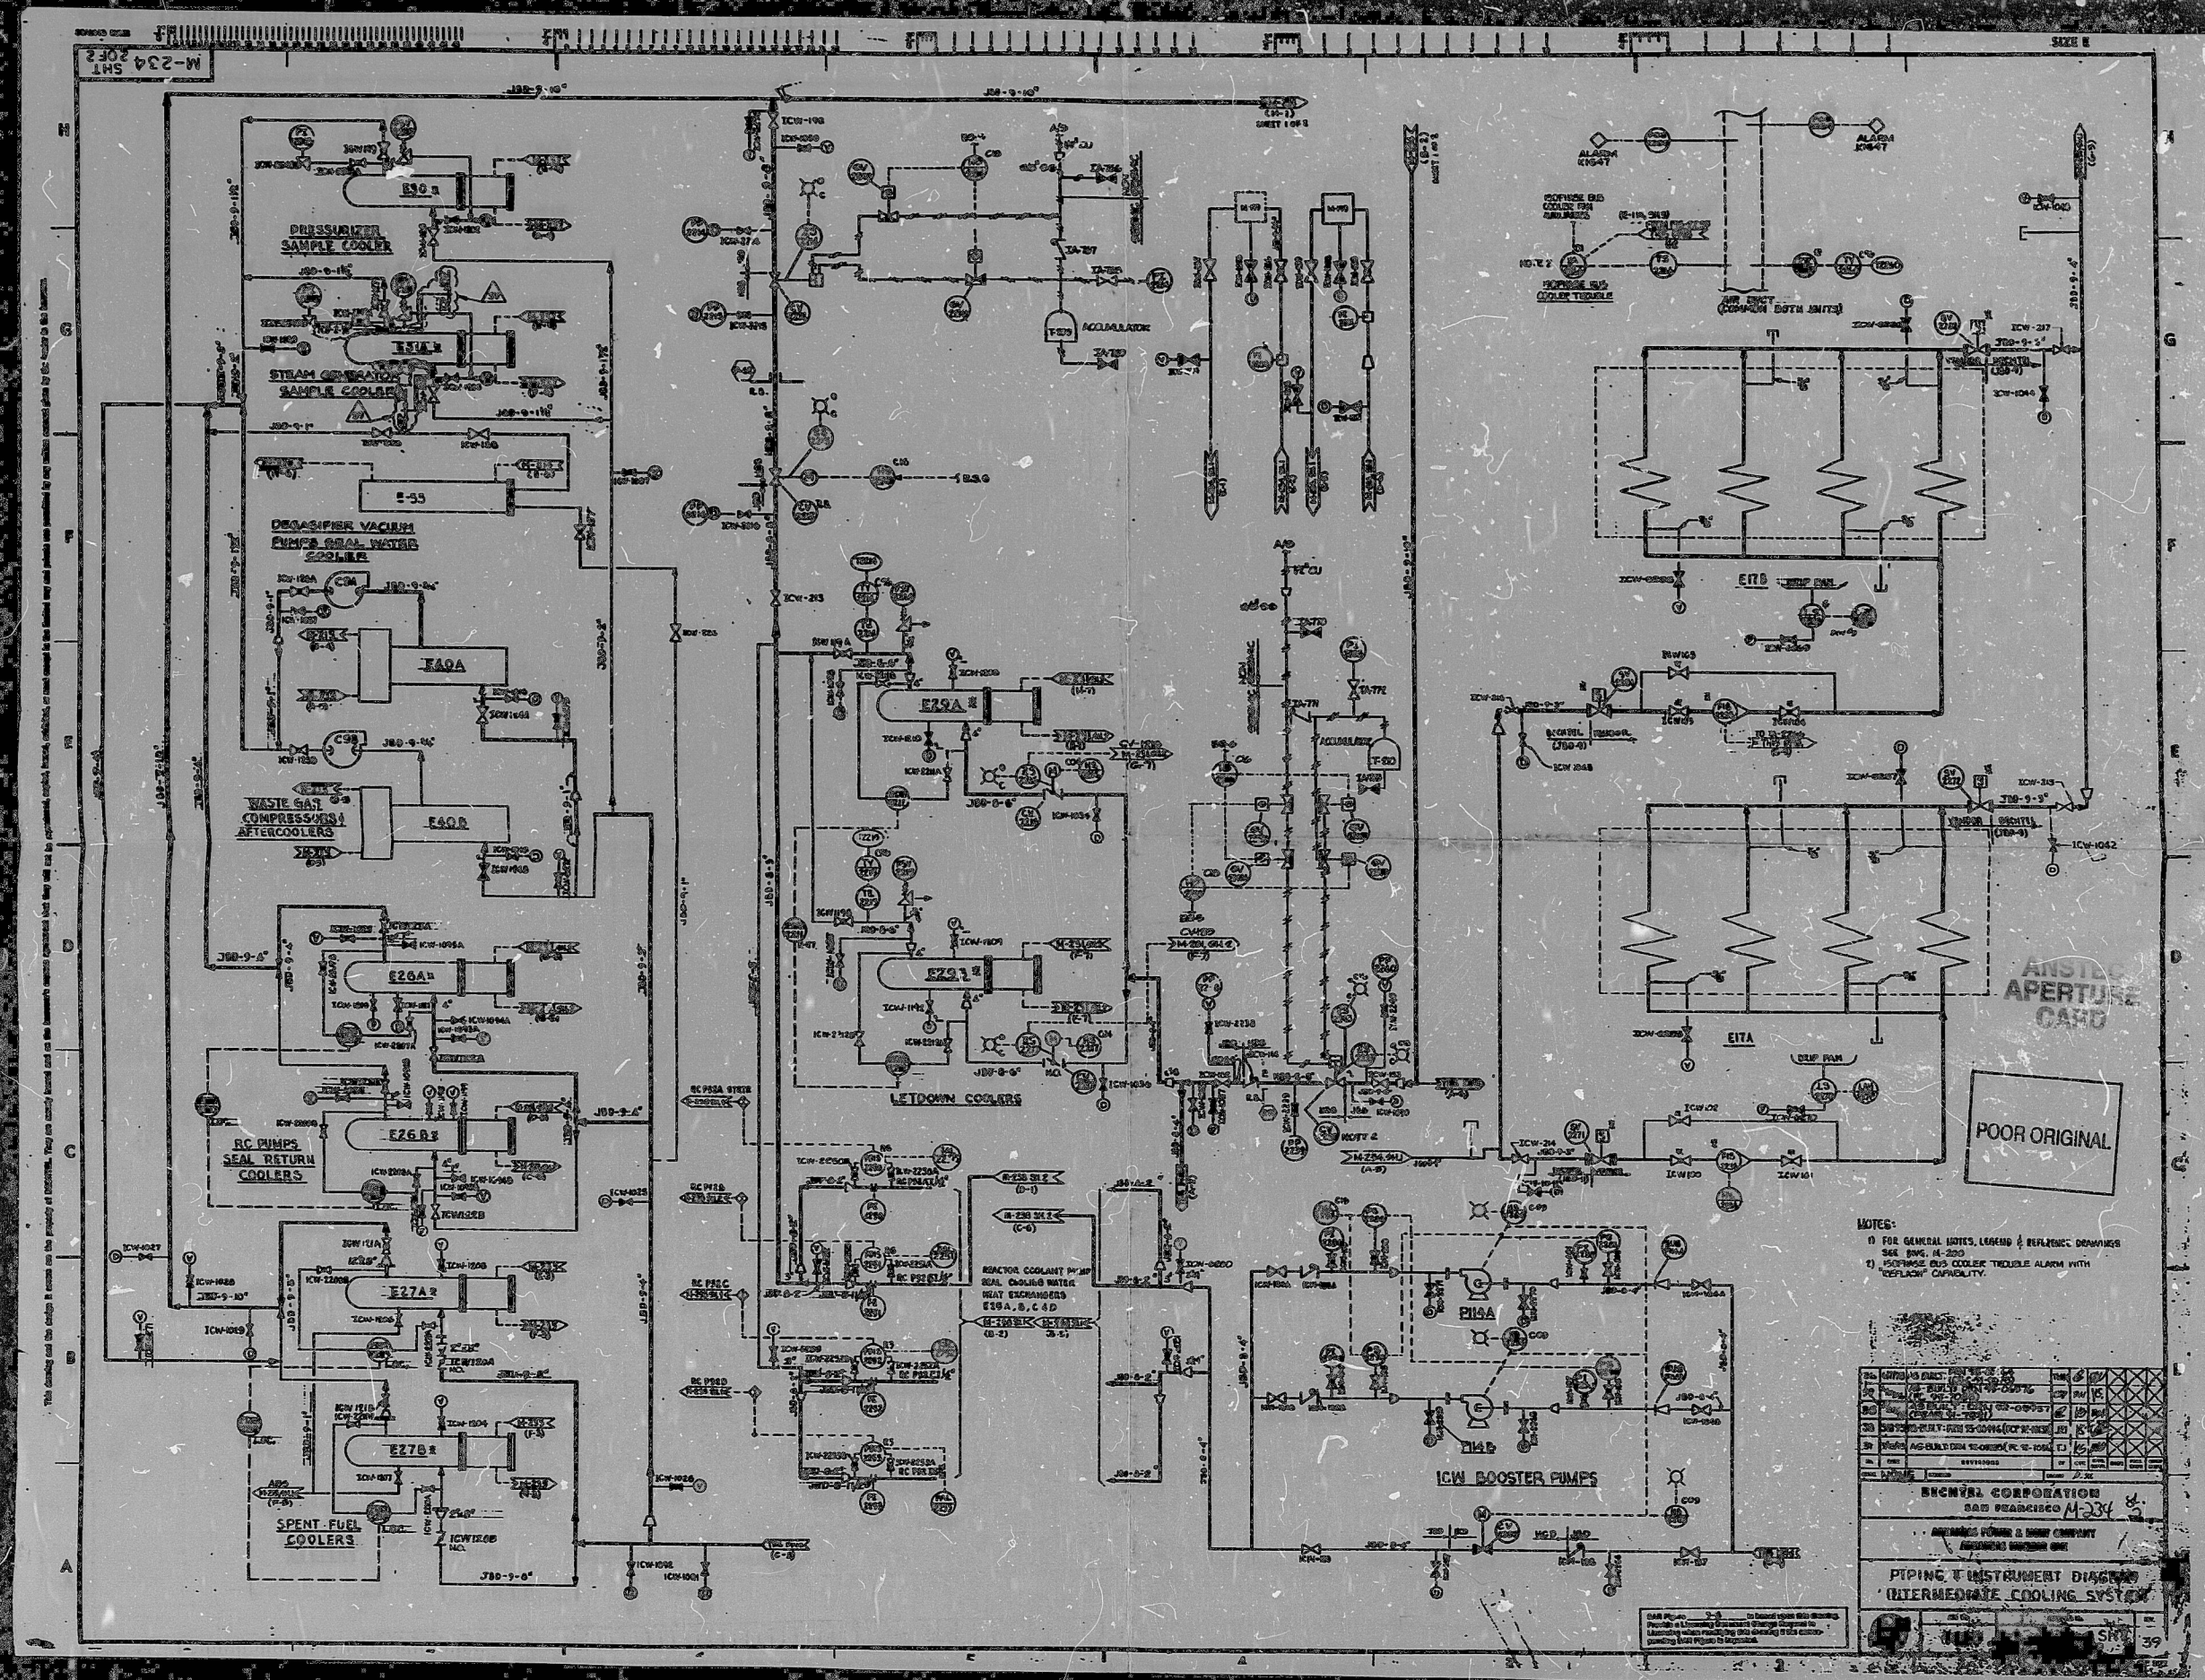



9712170231

PDR RIDS

9712170231

