


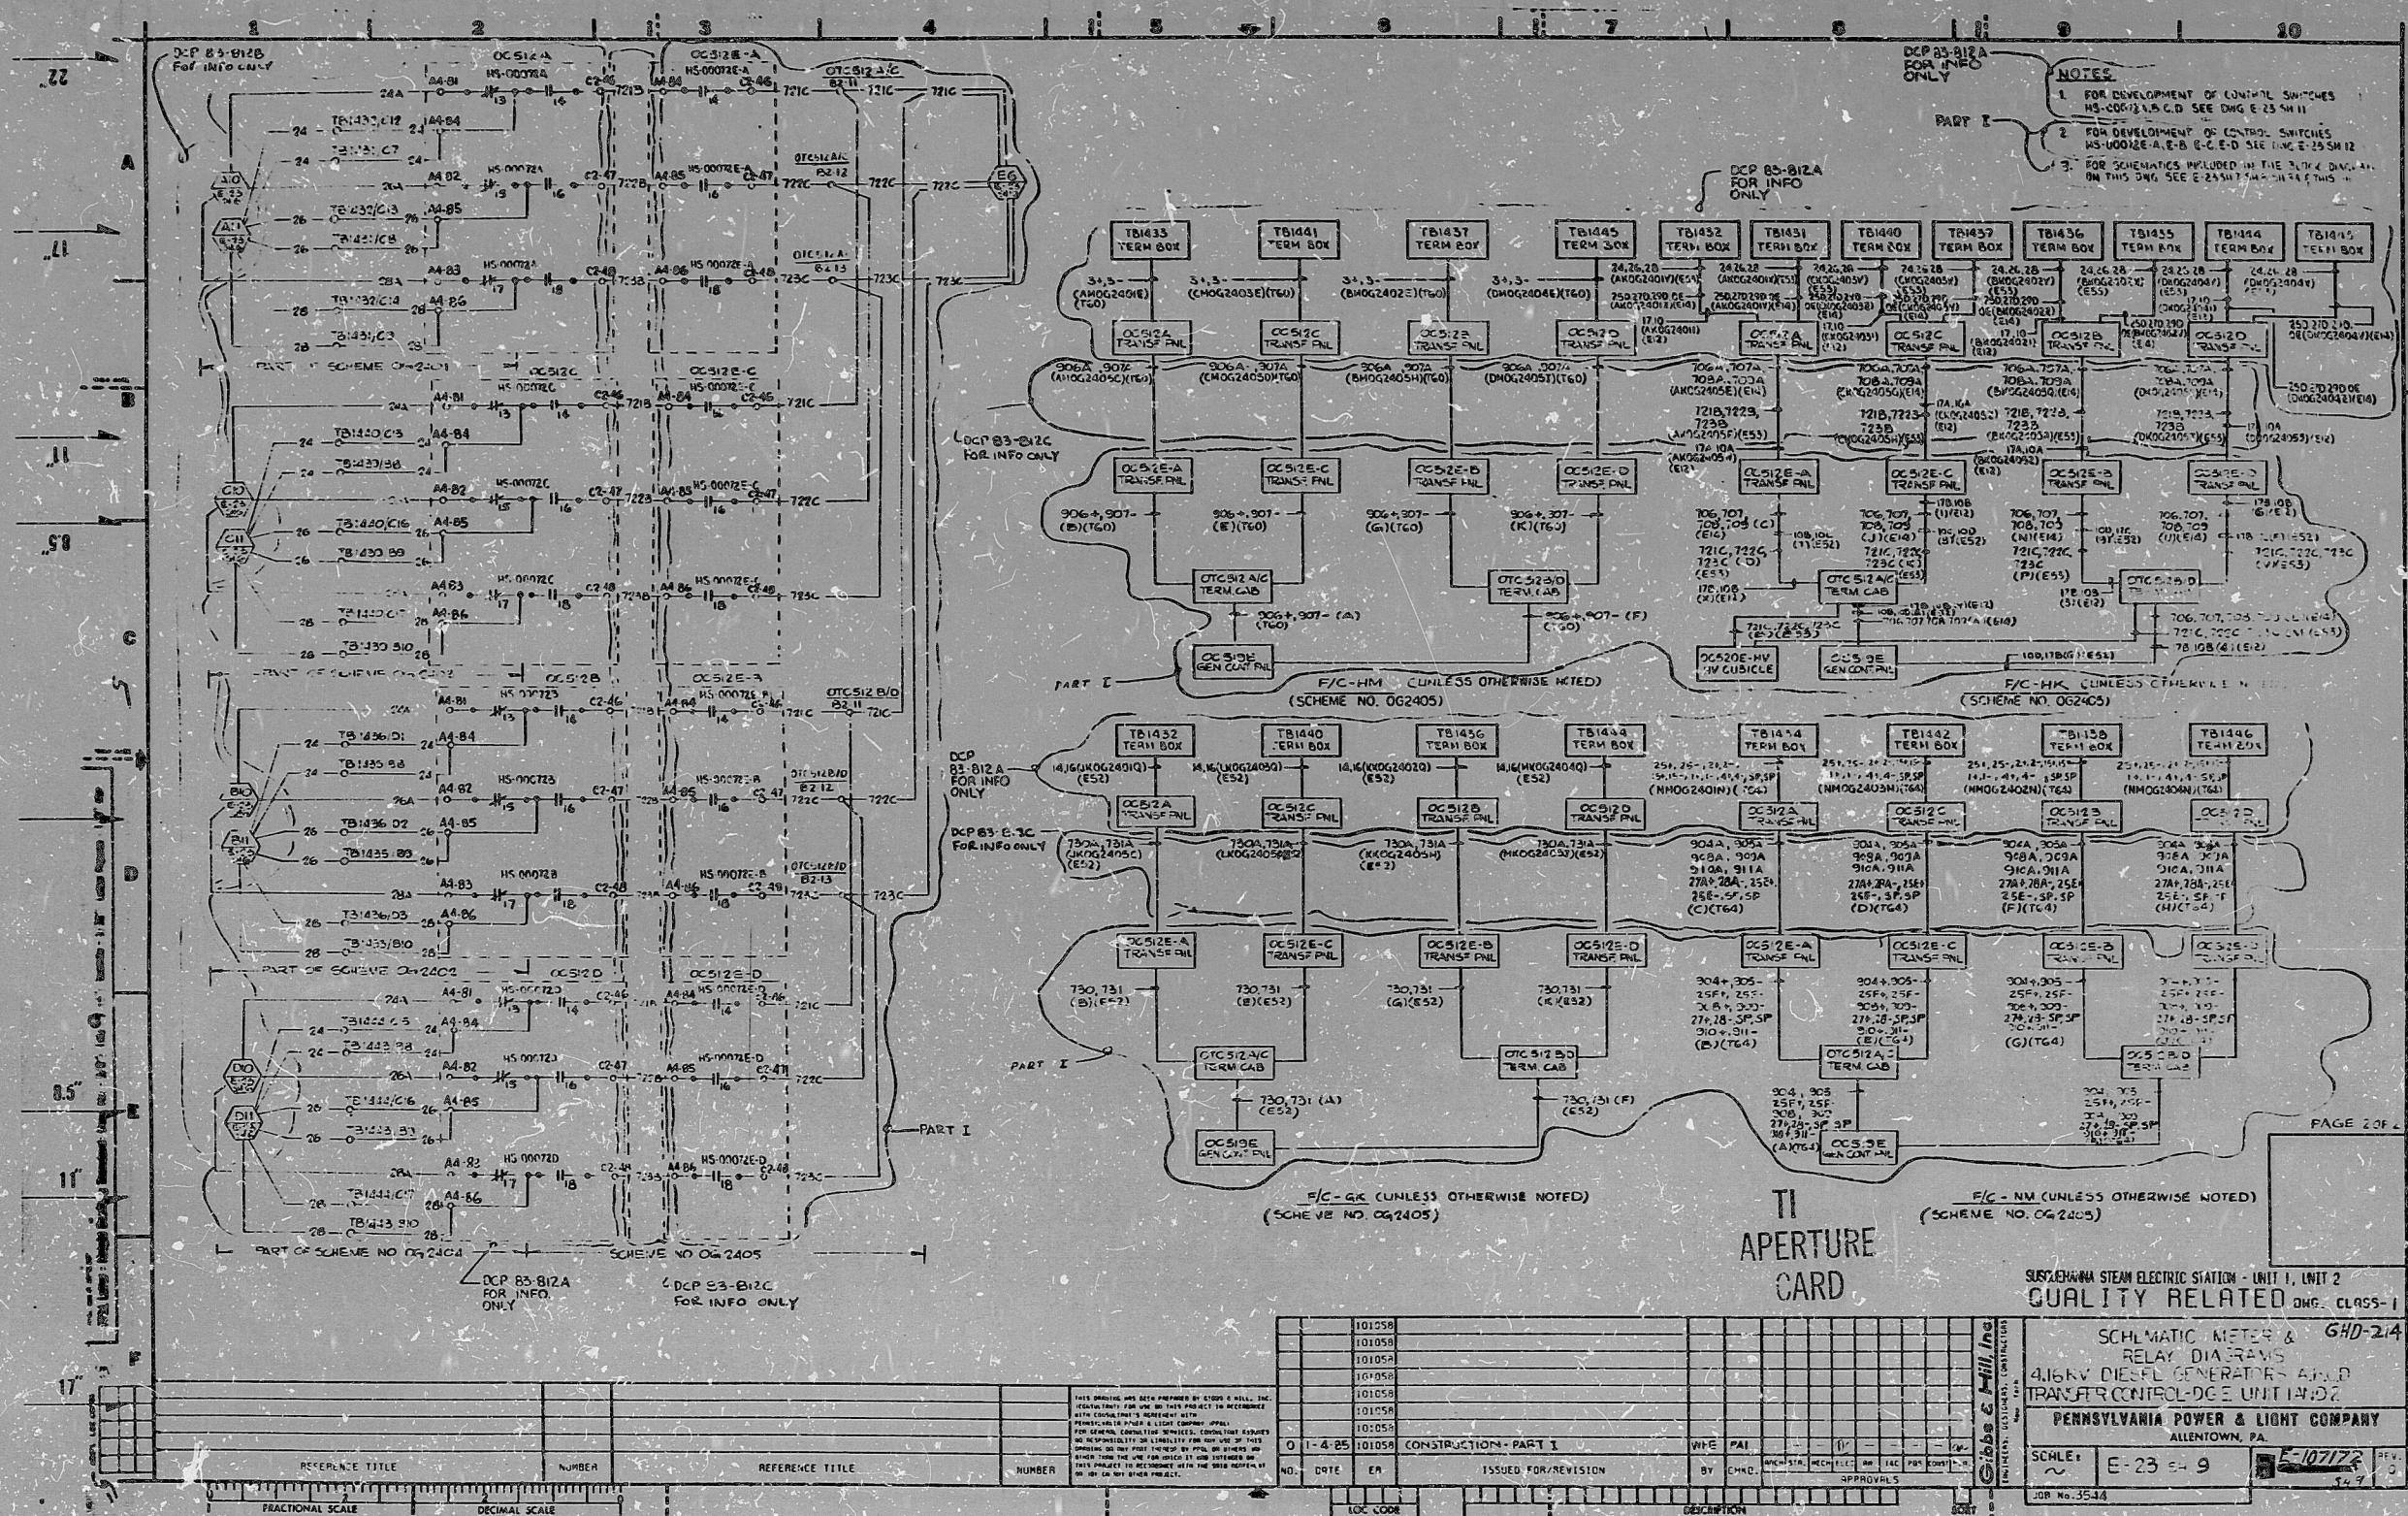

NOTES
1. FOR DEVELOPMENT OF CONTROL SWITCHES
HS-00012 A-B-C-D SEE DWG E-23-5411
2. FOR DEVELOPMENT OF CONTROL SWITCHES
HS-00012 E-A-B-C-D SEE DWG E-23-5412
3. FOR SCHEMATICS INCLUDED IN THE 24X DIMENSION
ON THIS DWG SEE E-23-5411 & E-23-5412

SUSQUEHANNA STEAM ELECTRIC STATION - UNIT 1, UNIT 2
QUALITY RELATED DWG. CLASS-1
SCHEMATIC METERS & GHD-214
RELAY DIAGRAMS
416KV DIESEL GENERATORS AND
TRANSFER CONTROL-DC UNIT 1A-D2
PENNSYLVANIA POWER & LIGHT COMPANY
ALLENTOWN, PA.
JOB No. 3544


I CERTIFY THAT THE IMAGE CONTAINED ON THIS FRAME WAS MADE IN THE NORMAL AND REGULAR
COURSE OF BUSINESS ON THE DATE STATED BELOW AND THAT IT IS AN ACCURATE REPRODUCTION
OF THE DOCUMENT SUBMITTED TO SRMS CORRESPONDENCE AND DRAWING FILES.
DATE: 9-15-1964 BY: [Signature]

24X

PDR RIDS

8603170005

75C-DDAC-E

