






PDR RIDS

8702250470

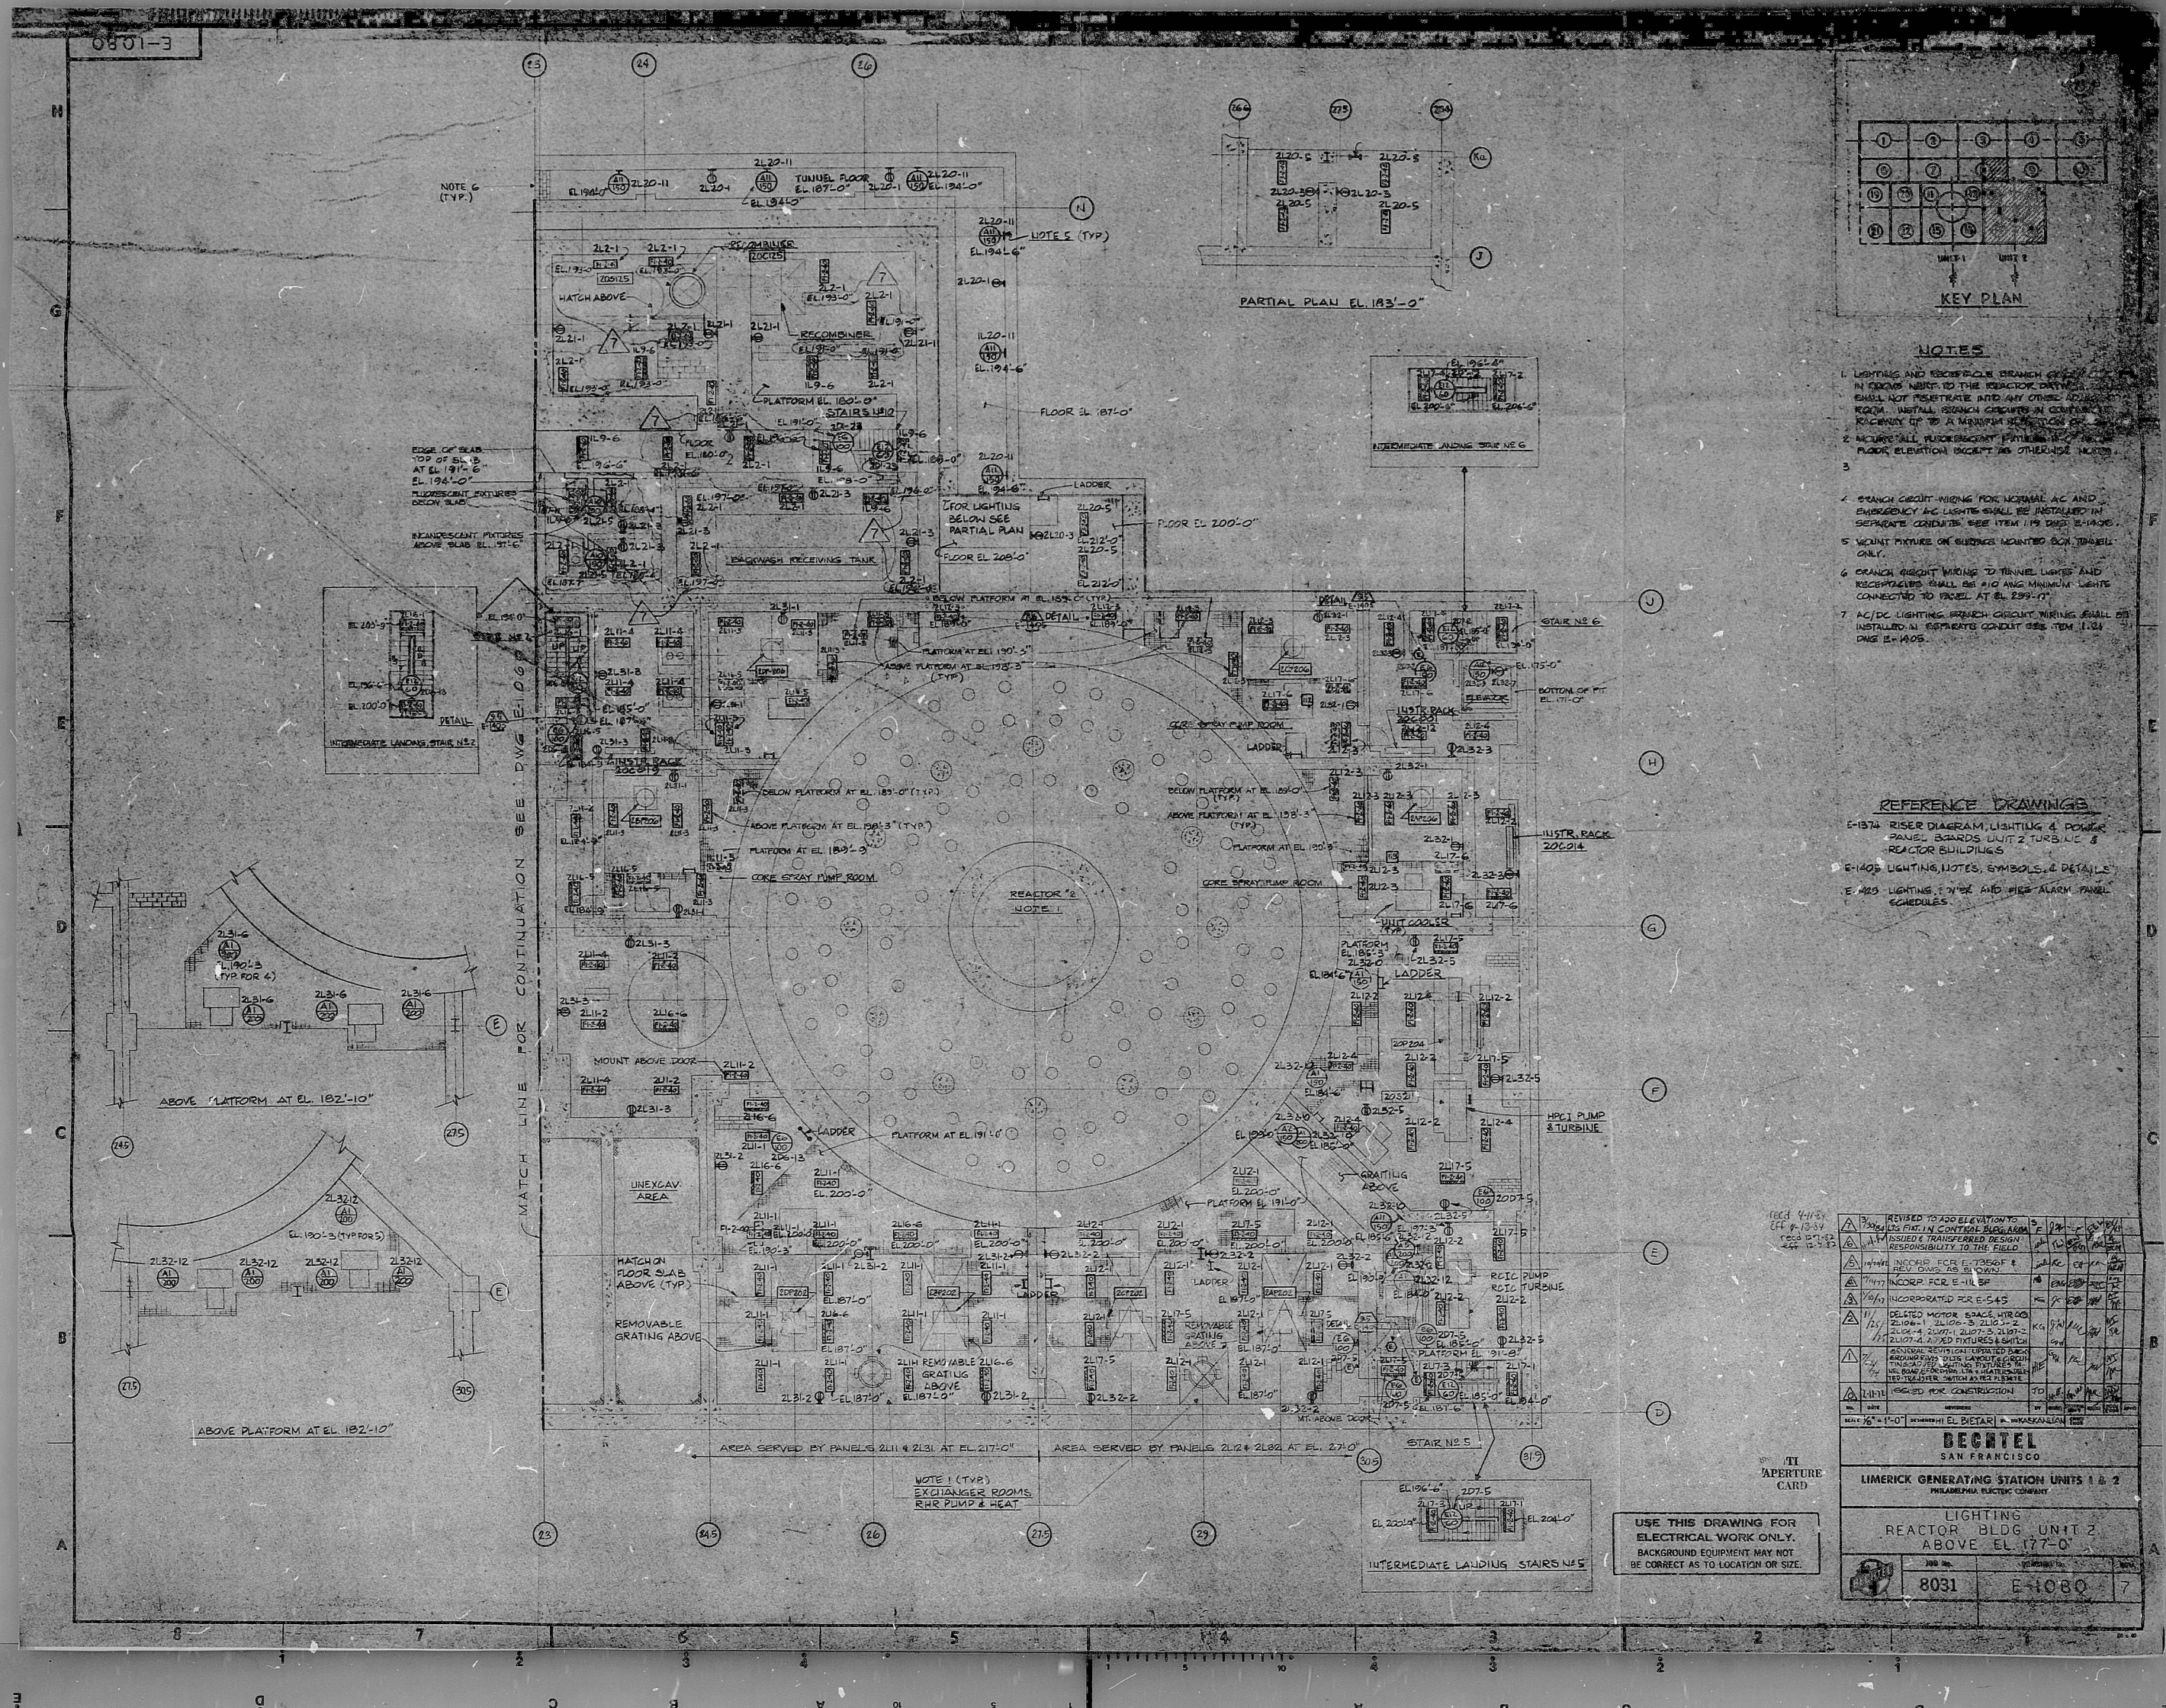