



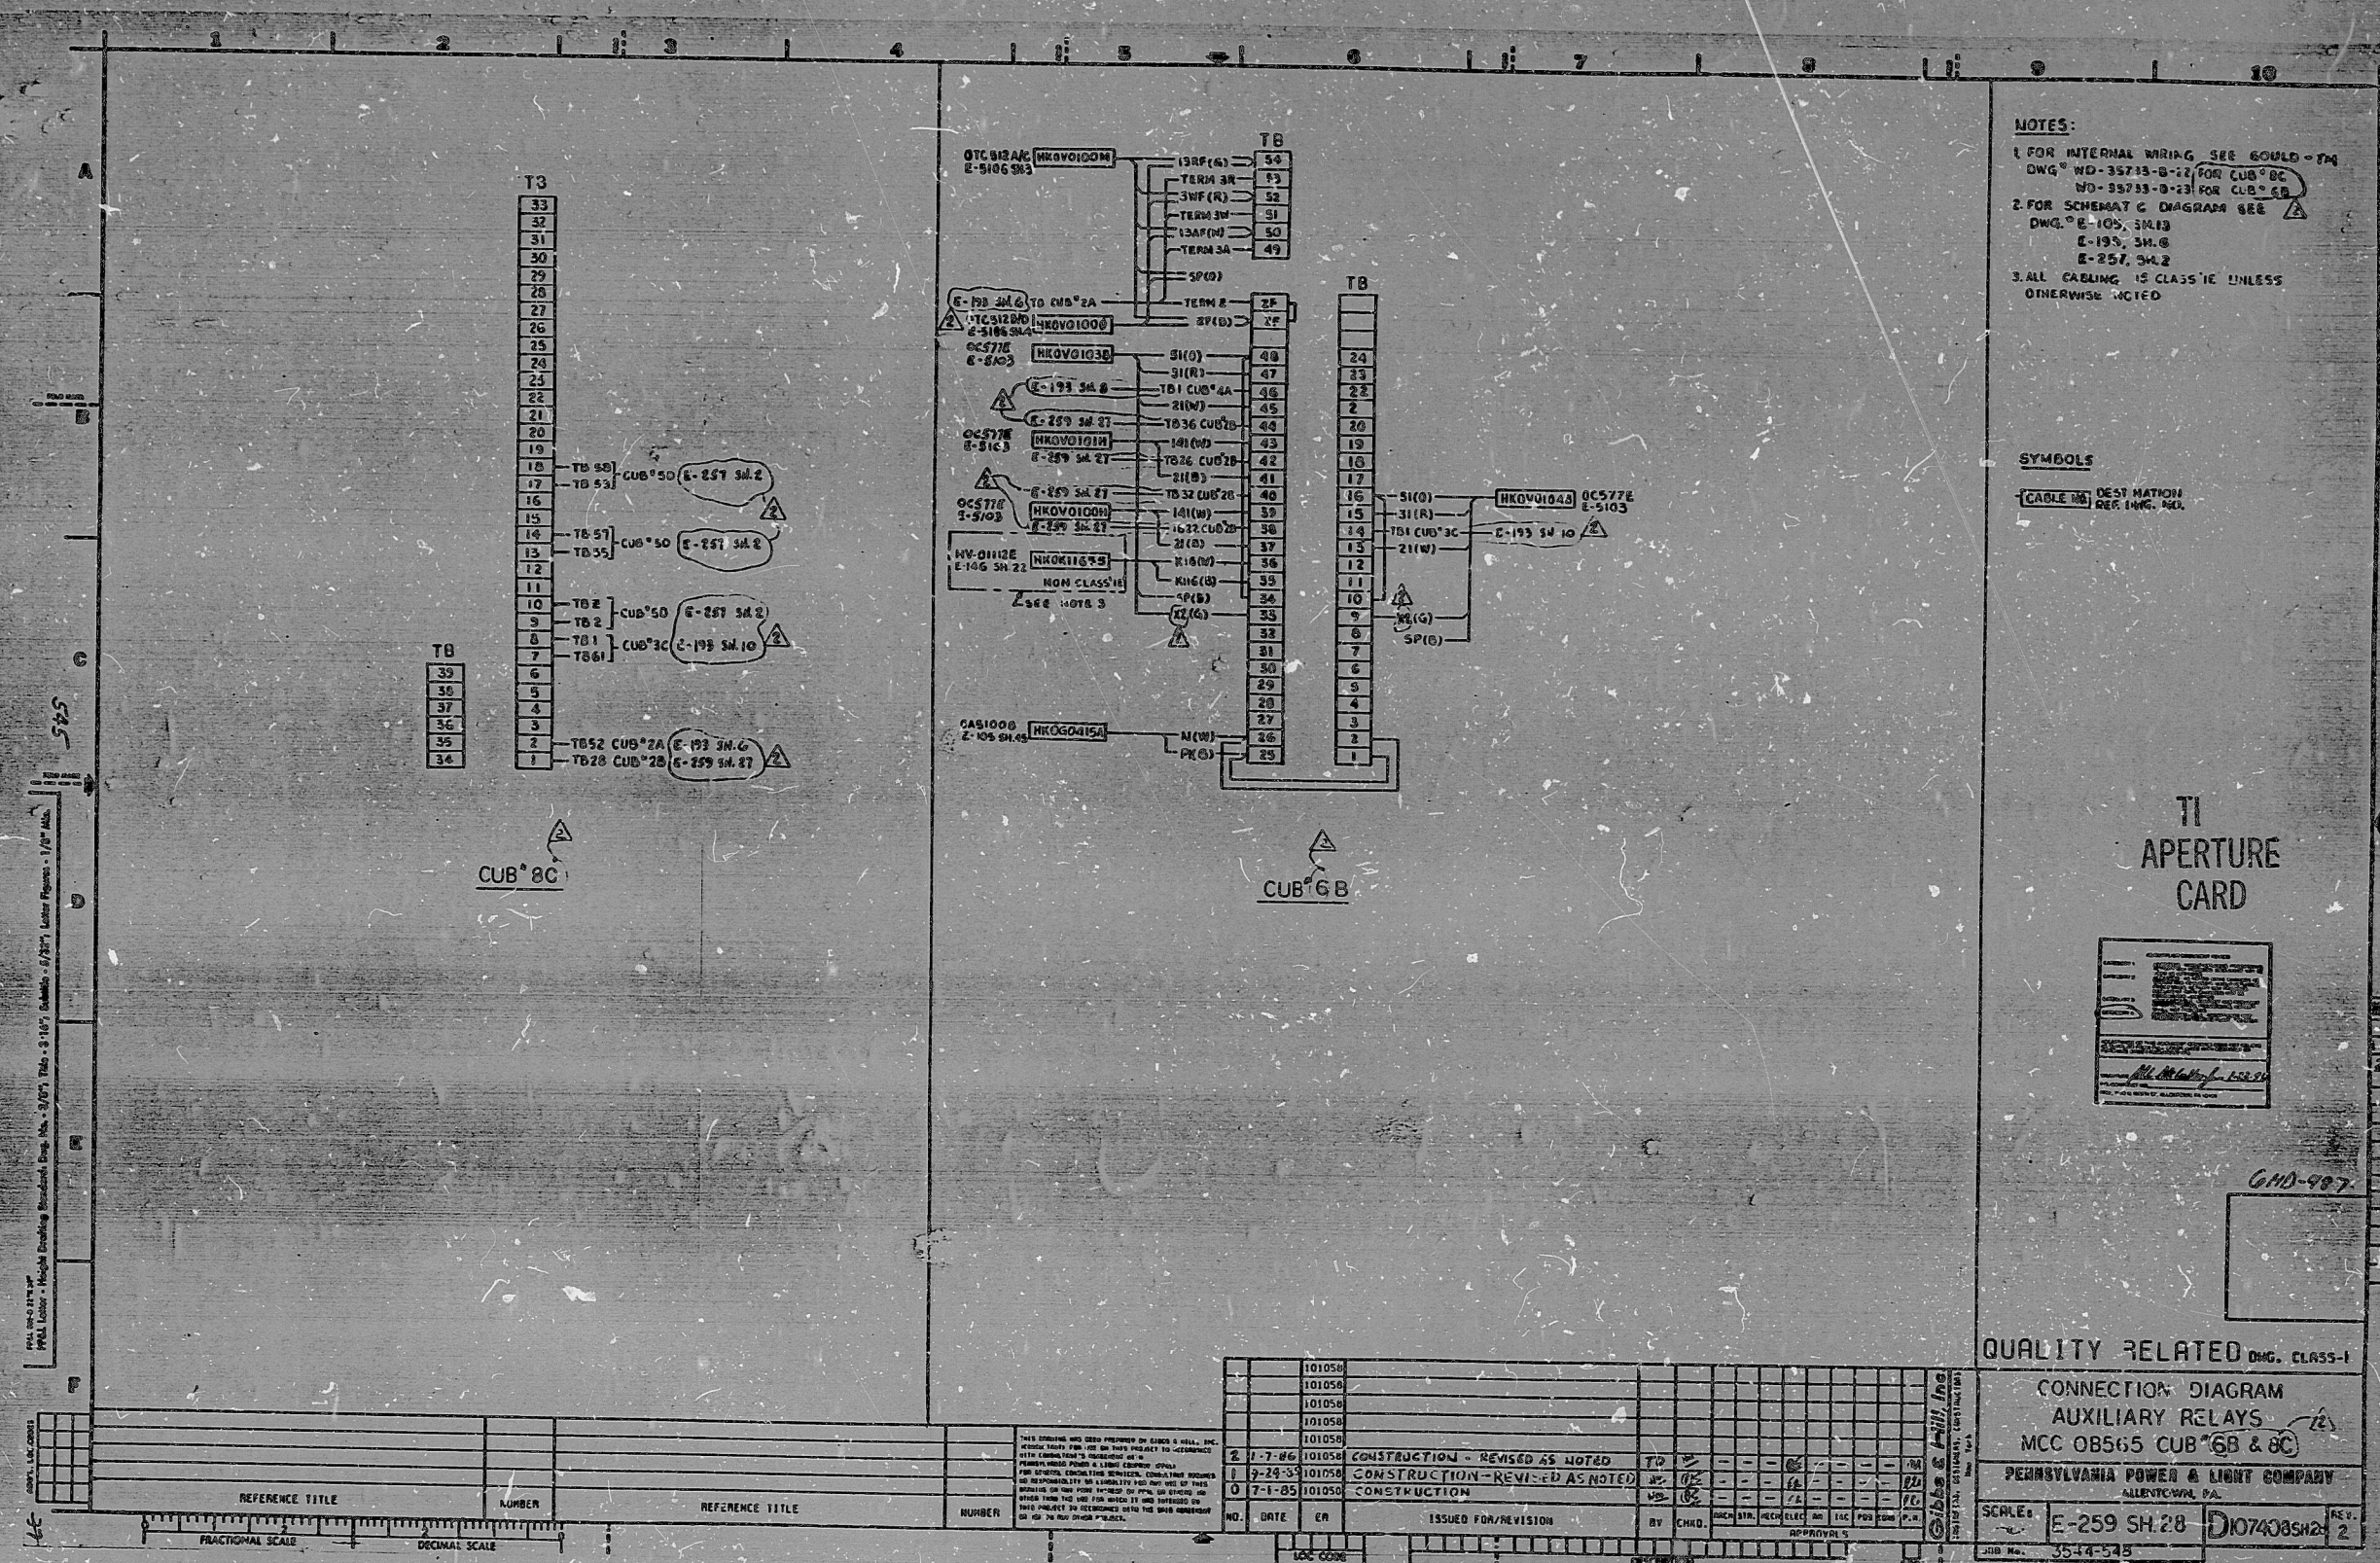

NOTES:
 1. FOR INTERNAL WIRING SEE SCHEMATIC - 74
 DWG. NO. 35733-0-21 FOR CUB*8C
 NO. 35733-0-23 FOR CUB*5A
 2. FOR SCHEMATIC C DIAGRAM SEE
 DWG. NO. 105, 3M.13
 E-193, 3M.6
 E-257, 3M.2
 3. ALL CABLEING IS CLASSIC UNLESS
 OTHERWISE NOTED

SYMBOLS
 CABLE NO. DESTINATION
 REF. ING. NO.

TI
 APERTURE
 CARD

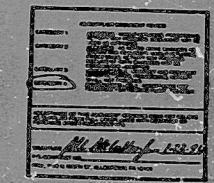

GND-997

QUALITY RELATED DWG. CLASS-1

CONNECTION DIAGRAM
 AUXILIARY RELAYS
 MCC 08565 CUB*6B & 8C

PENNSYLVANIA POWER & LIGHT COMPANY
 ALLENTOWN, PA.

SCALE: E-259 SH.28 D107408SH2
 SUB No. 35-4-548

24X

I CERTIFY THAT THE IMAGE CONTAINED ON THIS FRAME WAS MADE BY THE METHOD AND REGARDING
 DATE: 10/1/56

PDR RIDS

8603170025

DTC-BBAGCC

