


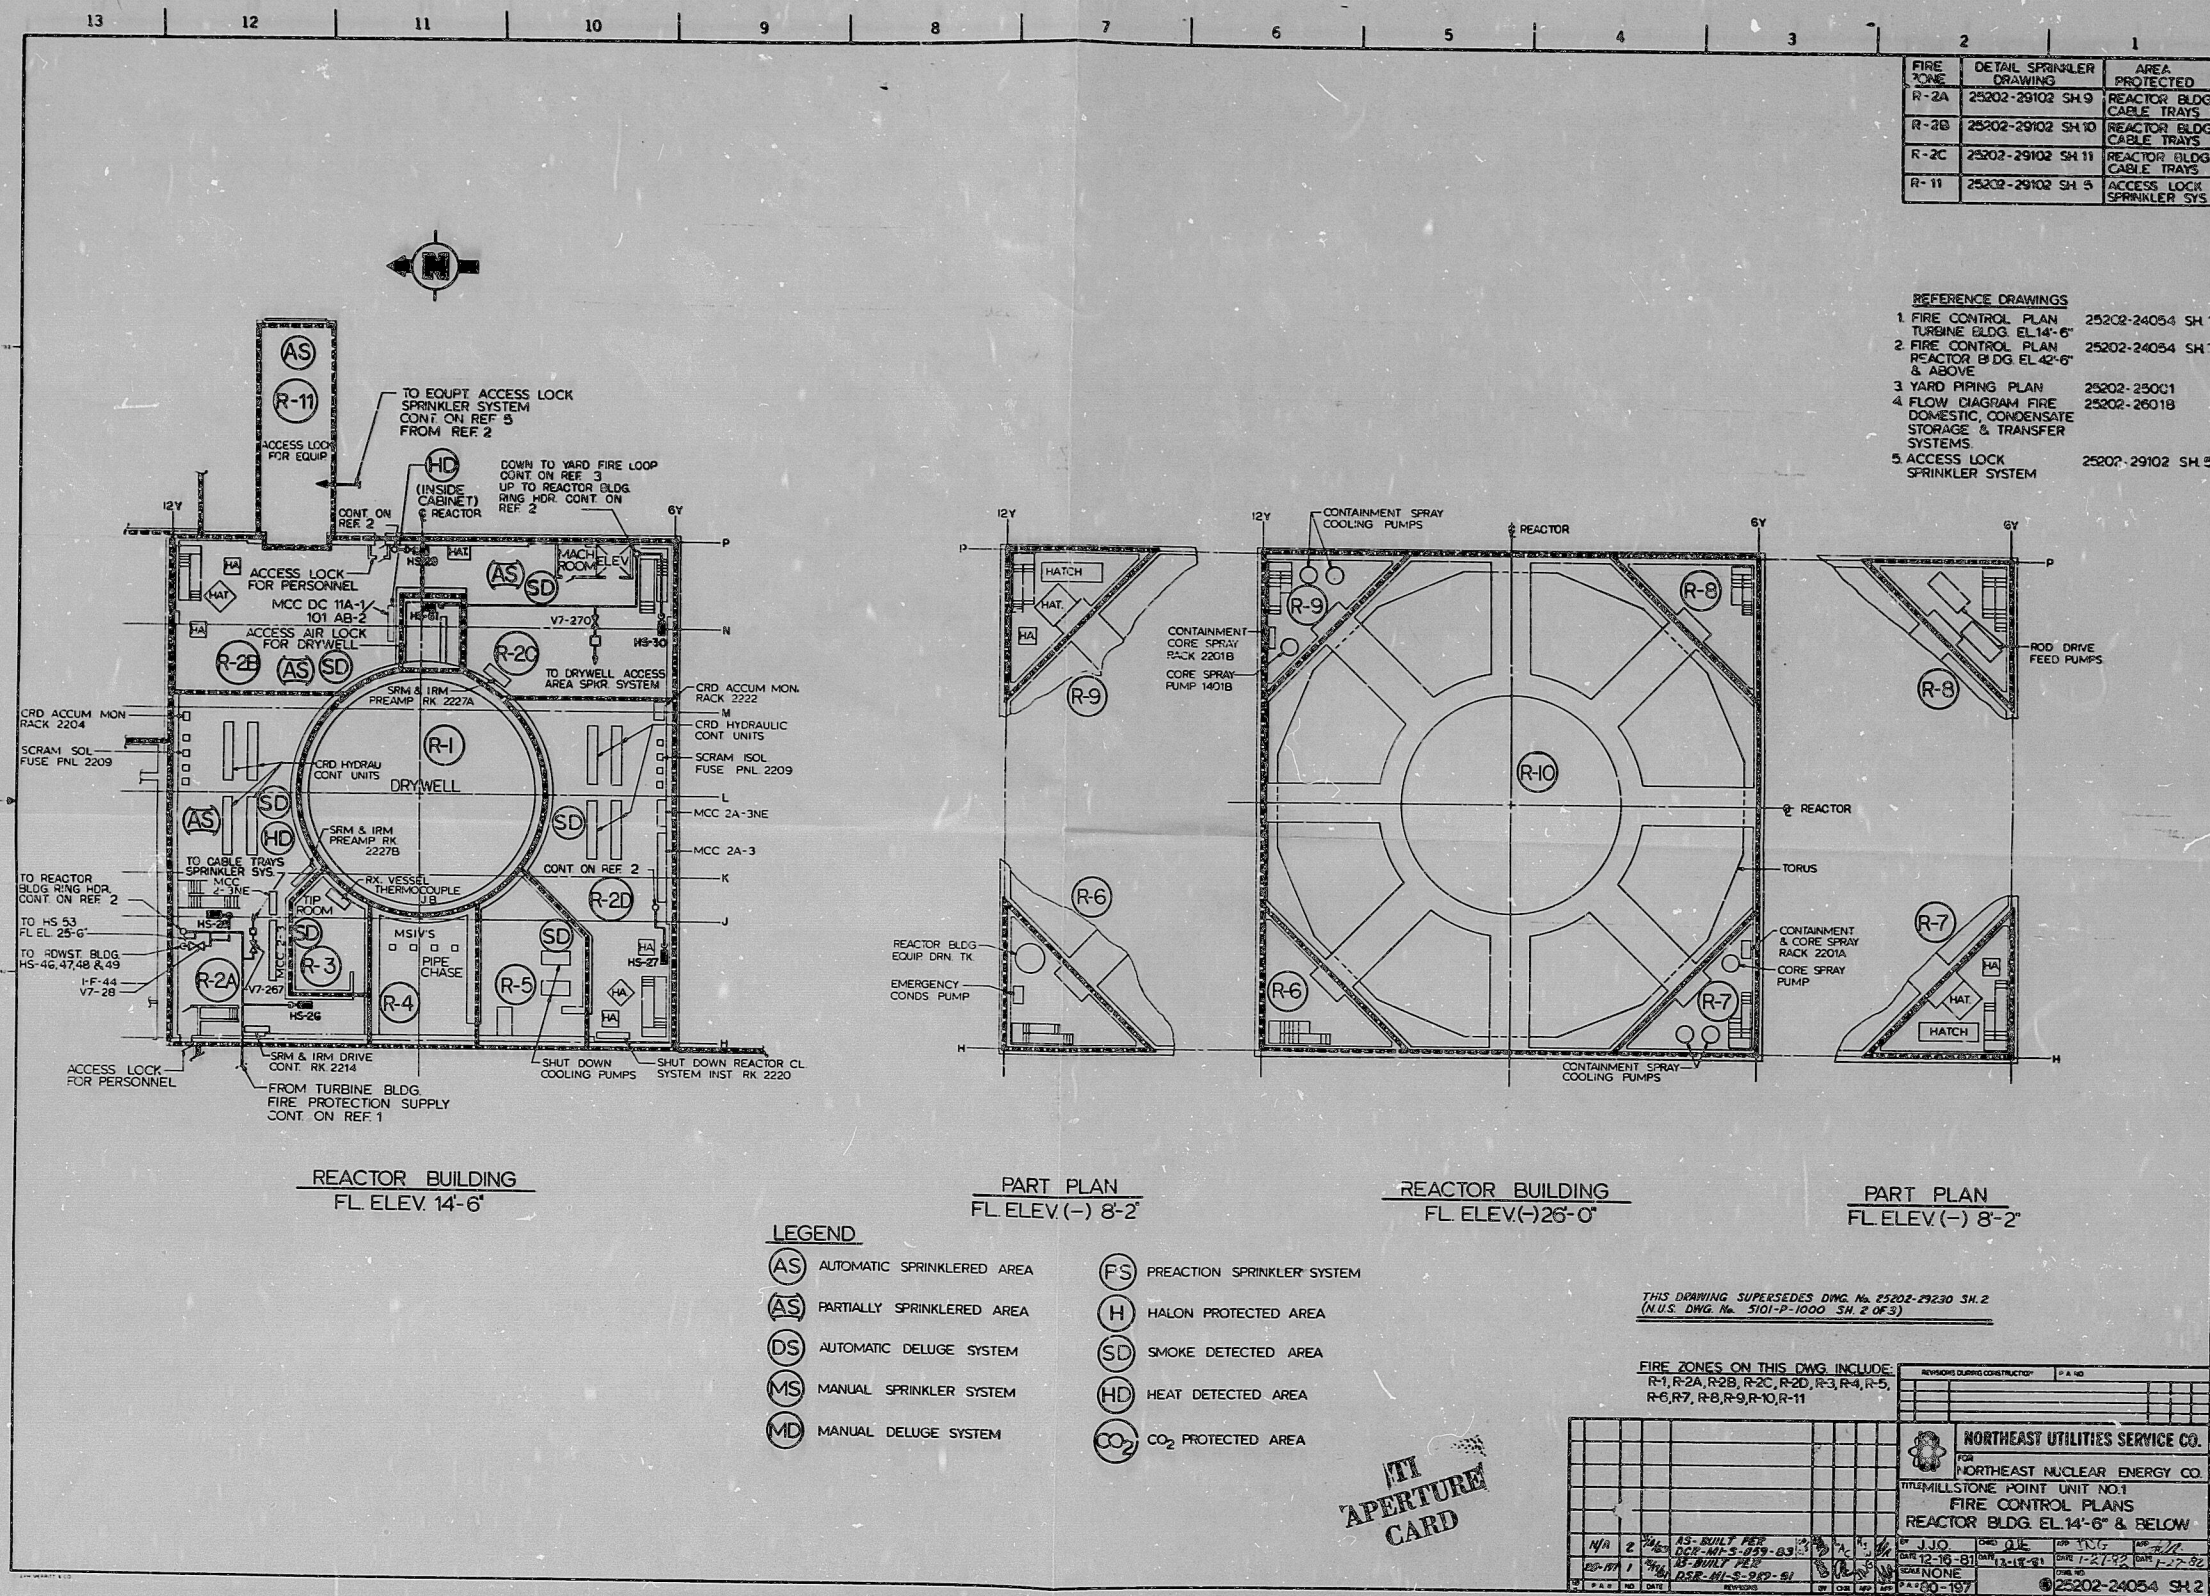

8604180151



PDR RIDS

8604180151

