
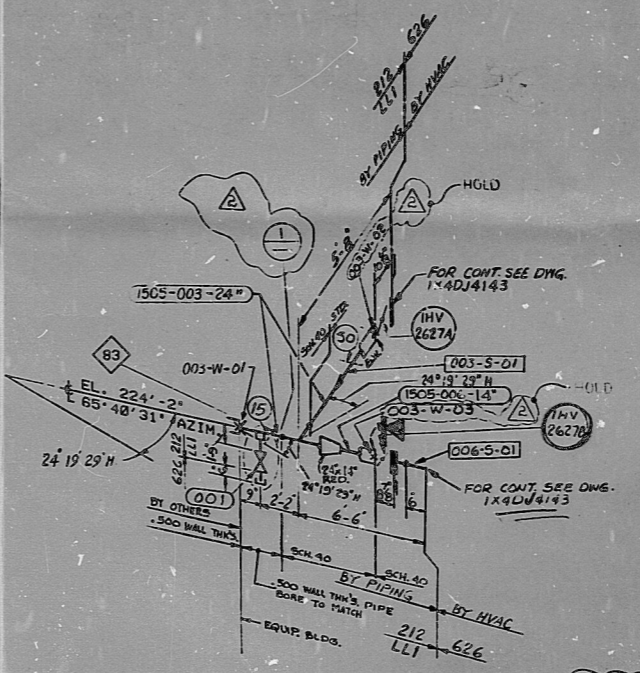


THIS DRAWING AND THE DESIGN IT COVERS ARE PROPERTY OF BECHTEL. THEY ARE TO BE LOANED AND ON THE BORROWER'S EXPRESS AGREEMENT THAT THEY WILL NOT BE REPRODUCED, COPIED, LOANED, EXAMINED, OR USED EXCEPT IN THE PRIVATE USE OF THE BORROWER.

THIS DRAWING AND THE DESIGN IT COVERS ARE PROPERTY OF BECHTEL. THEY ARE TO BE LOANED AND ON THE BORROWER'S EXPRESS AGREEMENT THAT THEY WILL NOT BE REPRODUCED, COPIED, LOANED, EXAMINED, OR USED EXCEPT IN THE PRIVATE USE OF THE BORROWER.

PIPE SUPPORT LIST
NODE SUPPORT TAG NO.
15 W-1505-003-H001
50 W-1505-003-H002

SPOOL NUMBER	REV. NO.	SHOP SH'T. NO.	ACT. PRG.	REMARKS

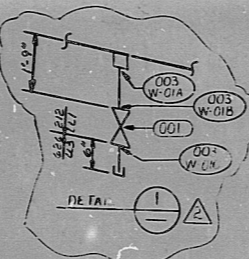

ACTIVITY PACKAGE NUMBER	CONVENTION
4-1-3111-1-030	

NOTE:
 1. FOR GENERAL NOTES SEE DWG. 1X404001
 2. CLEAN ASSY PER CLASS 'B' REQ.
 3. THIS DRAWING COVERED BY PROCEDURE II-64, CLOSURE SYS.

Installers Note
 1. SEE DWG. 1X404001 FOR GENERAL NOTES
 2. SEE DWG. 1X404001 FOR GENERAL NOTES
Q. A. Approval
 PULLMAN PD. PROC.
 BECHTEL
 LOS ANGELES
 GEORGIA POWER COMPANY
 ALVIN W. VOGTLE NUCLEAR PLANT
 CTB NORM. PROCESS PURGE SUPP. S.S.
 FABRICATION ISOMETRIC
 EQUIPMENT BLDG. AREA 9E, LVE 182
 SCALE: N.T.S.
 DRAWING NO. 1X4-1505-003-81
 JOB NO. 9510
 P.E. EGS

LINE NUMBER	PROJ. CLASS	PIPING CLASS	PIPING AREA	CIVIL/STRUCTURAL	STRESS	FEED	REFERENCE DWGS	NO.	REVISIONS	DATE DRAWN	CHK'D	DATE SUPPLY	PLANT DESIGN	EGS	P.E.	JOB NO.	SCALE	DRAWING NO.	REV.
1505-003-14"	212	111	1X3DL4E01	1X2002F100		1X408213			ISSUED FOR INSTALLATION	02-83	W.E.S.	02-83	PLANT DESIGN	EGS	P.E.	9510	N.T.S.	1X4-1505-003-81	2
1505-003-24"	212	111	1X3DL4E01	1X2002F100		1X408213			DELETED CTBY SIDE, ADDED SUPPORTS & TRANSFERRED TO GPC	02-83	W.E.S.	02-83	PLANT DESIGN	EGS	P.E.	9510	N.T.S.	1X4-1505-003-81	1
									ISSUED FOR CONSTRUCTION EQUIP. BLDG. ONLY	02-83	W.E.S.	02-83	PLANT DESIGN	EGS	P.E.	9510	N.T.S.	1X4-1505-003-81	1

8605130282

TI
 APERTURE
 CARD

PDR RIDS

8605130282

