


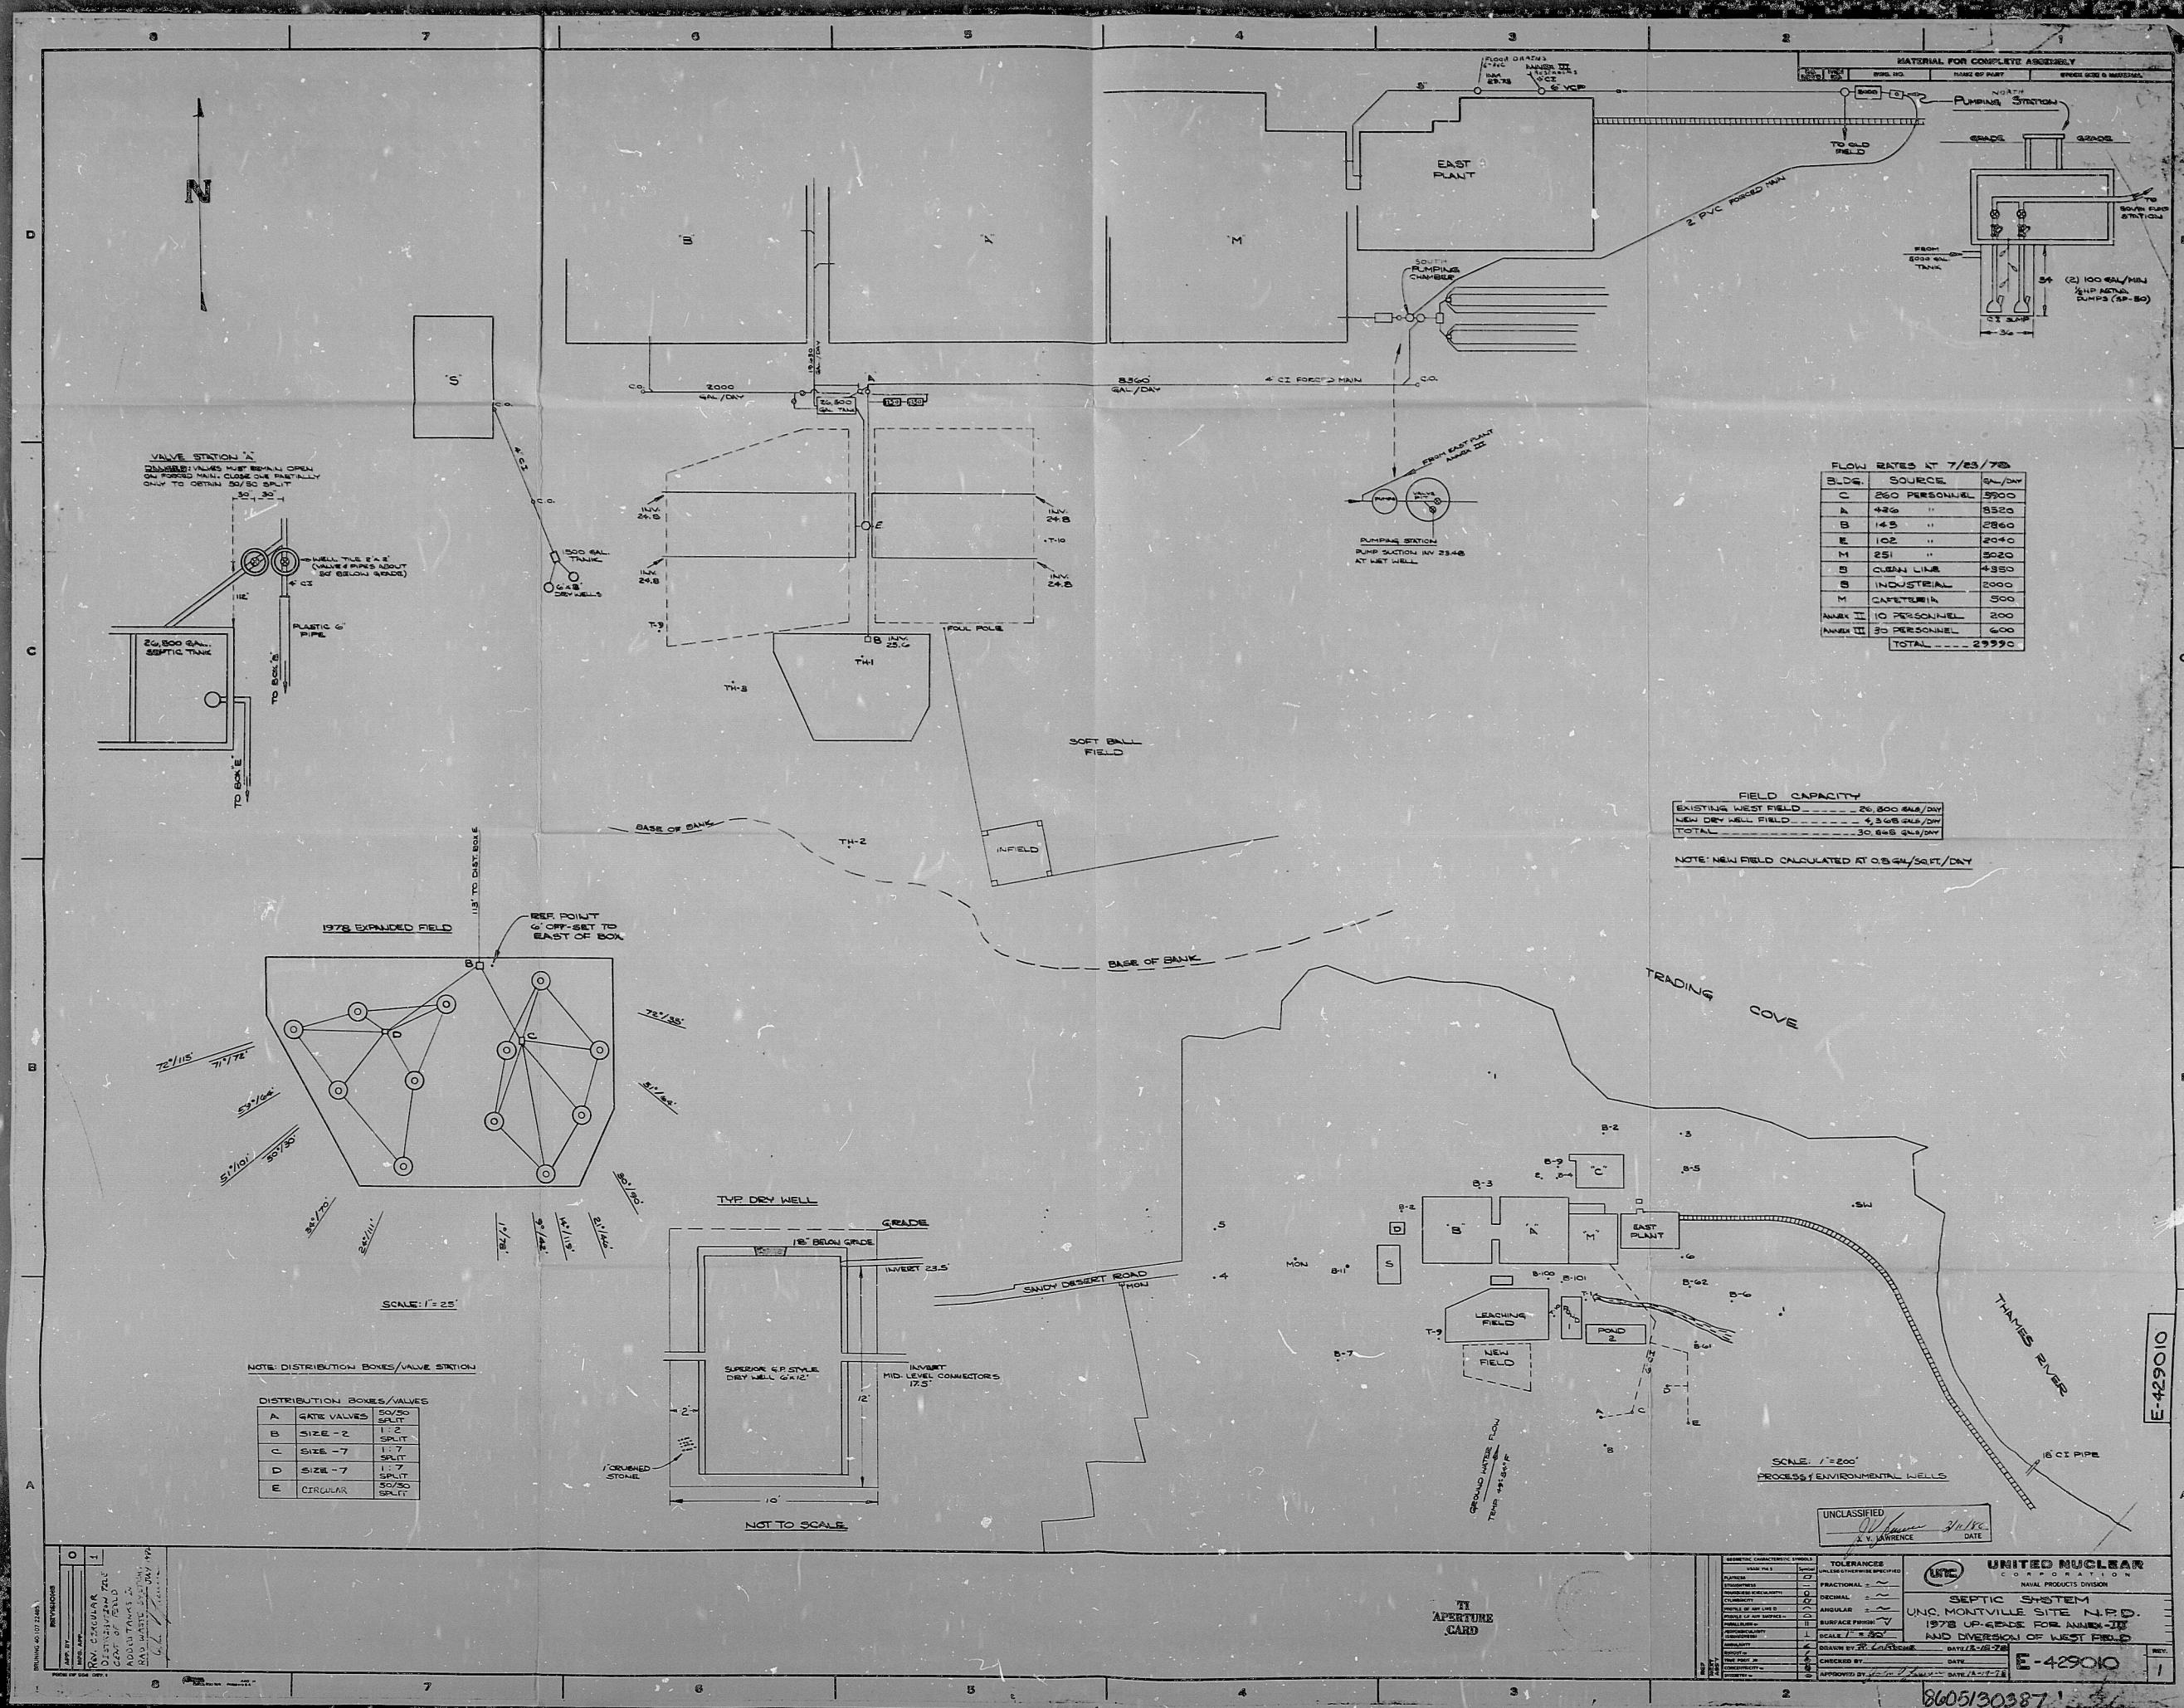

PDR

8605130387

