


DAELE

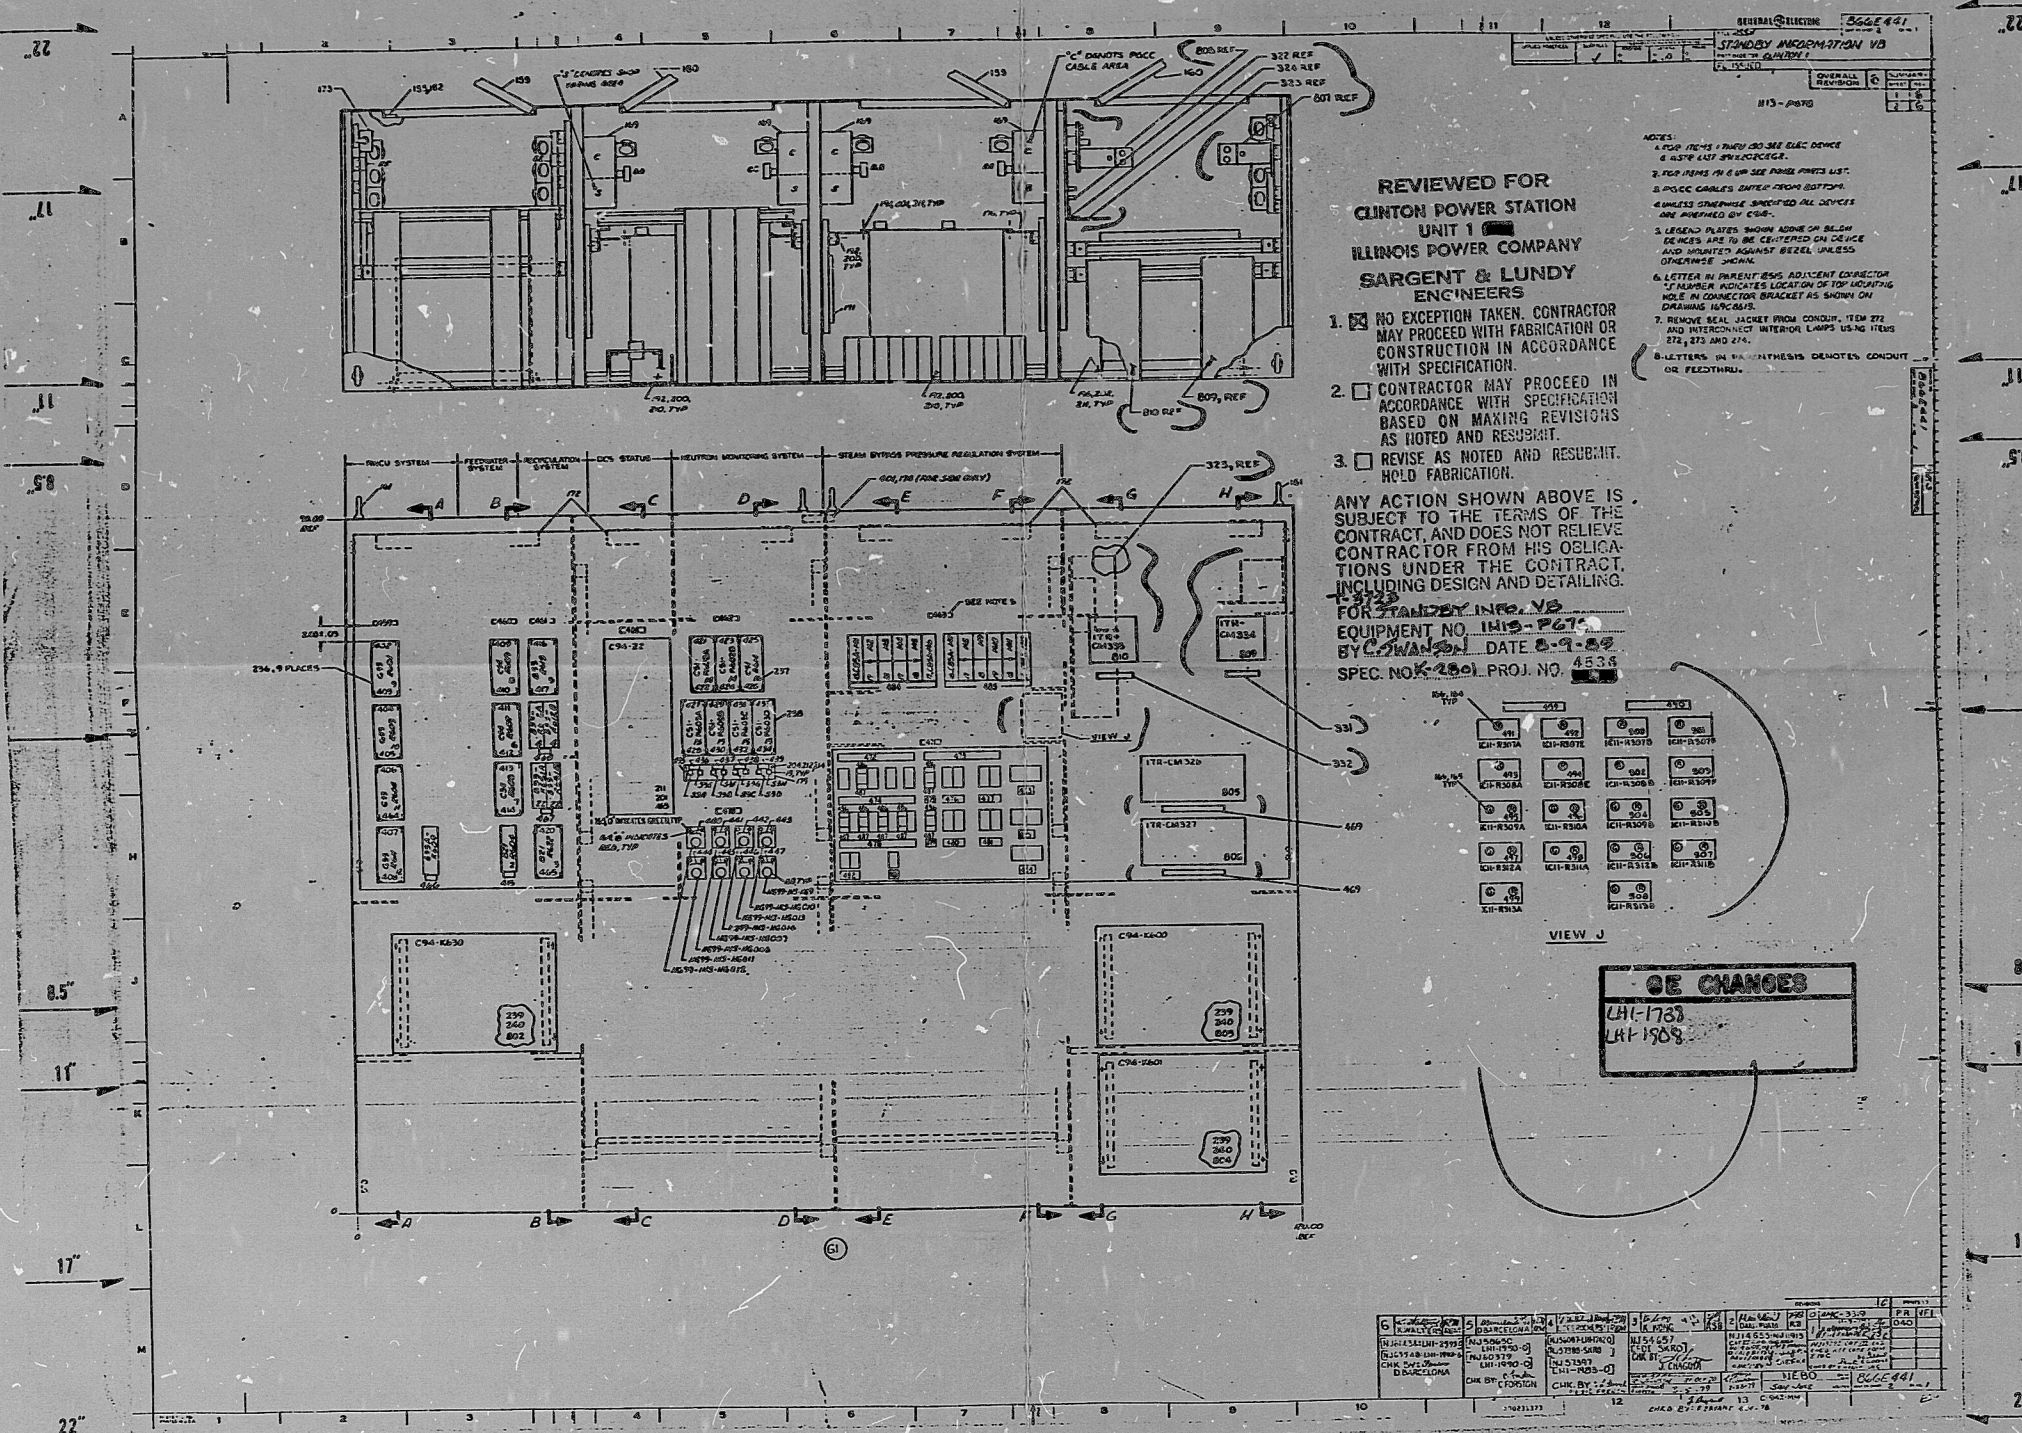

8703100017

TI
APERTURE
CARD

PDR RIDS

8703100017

