


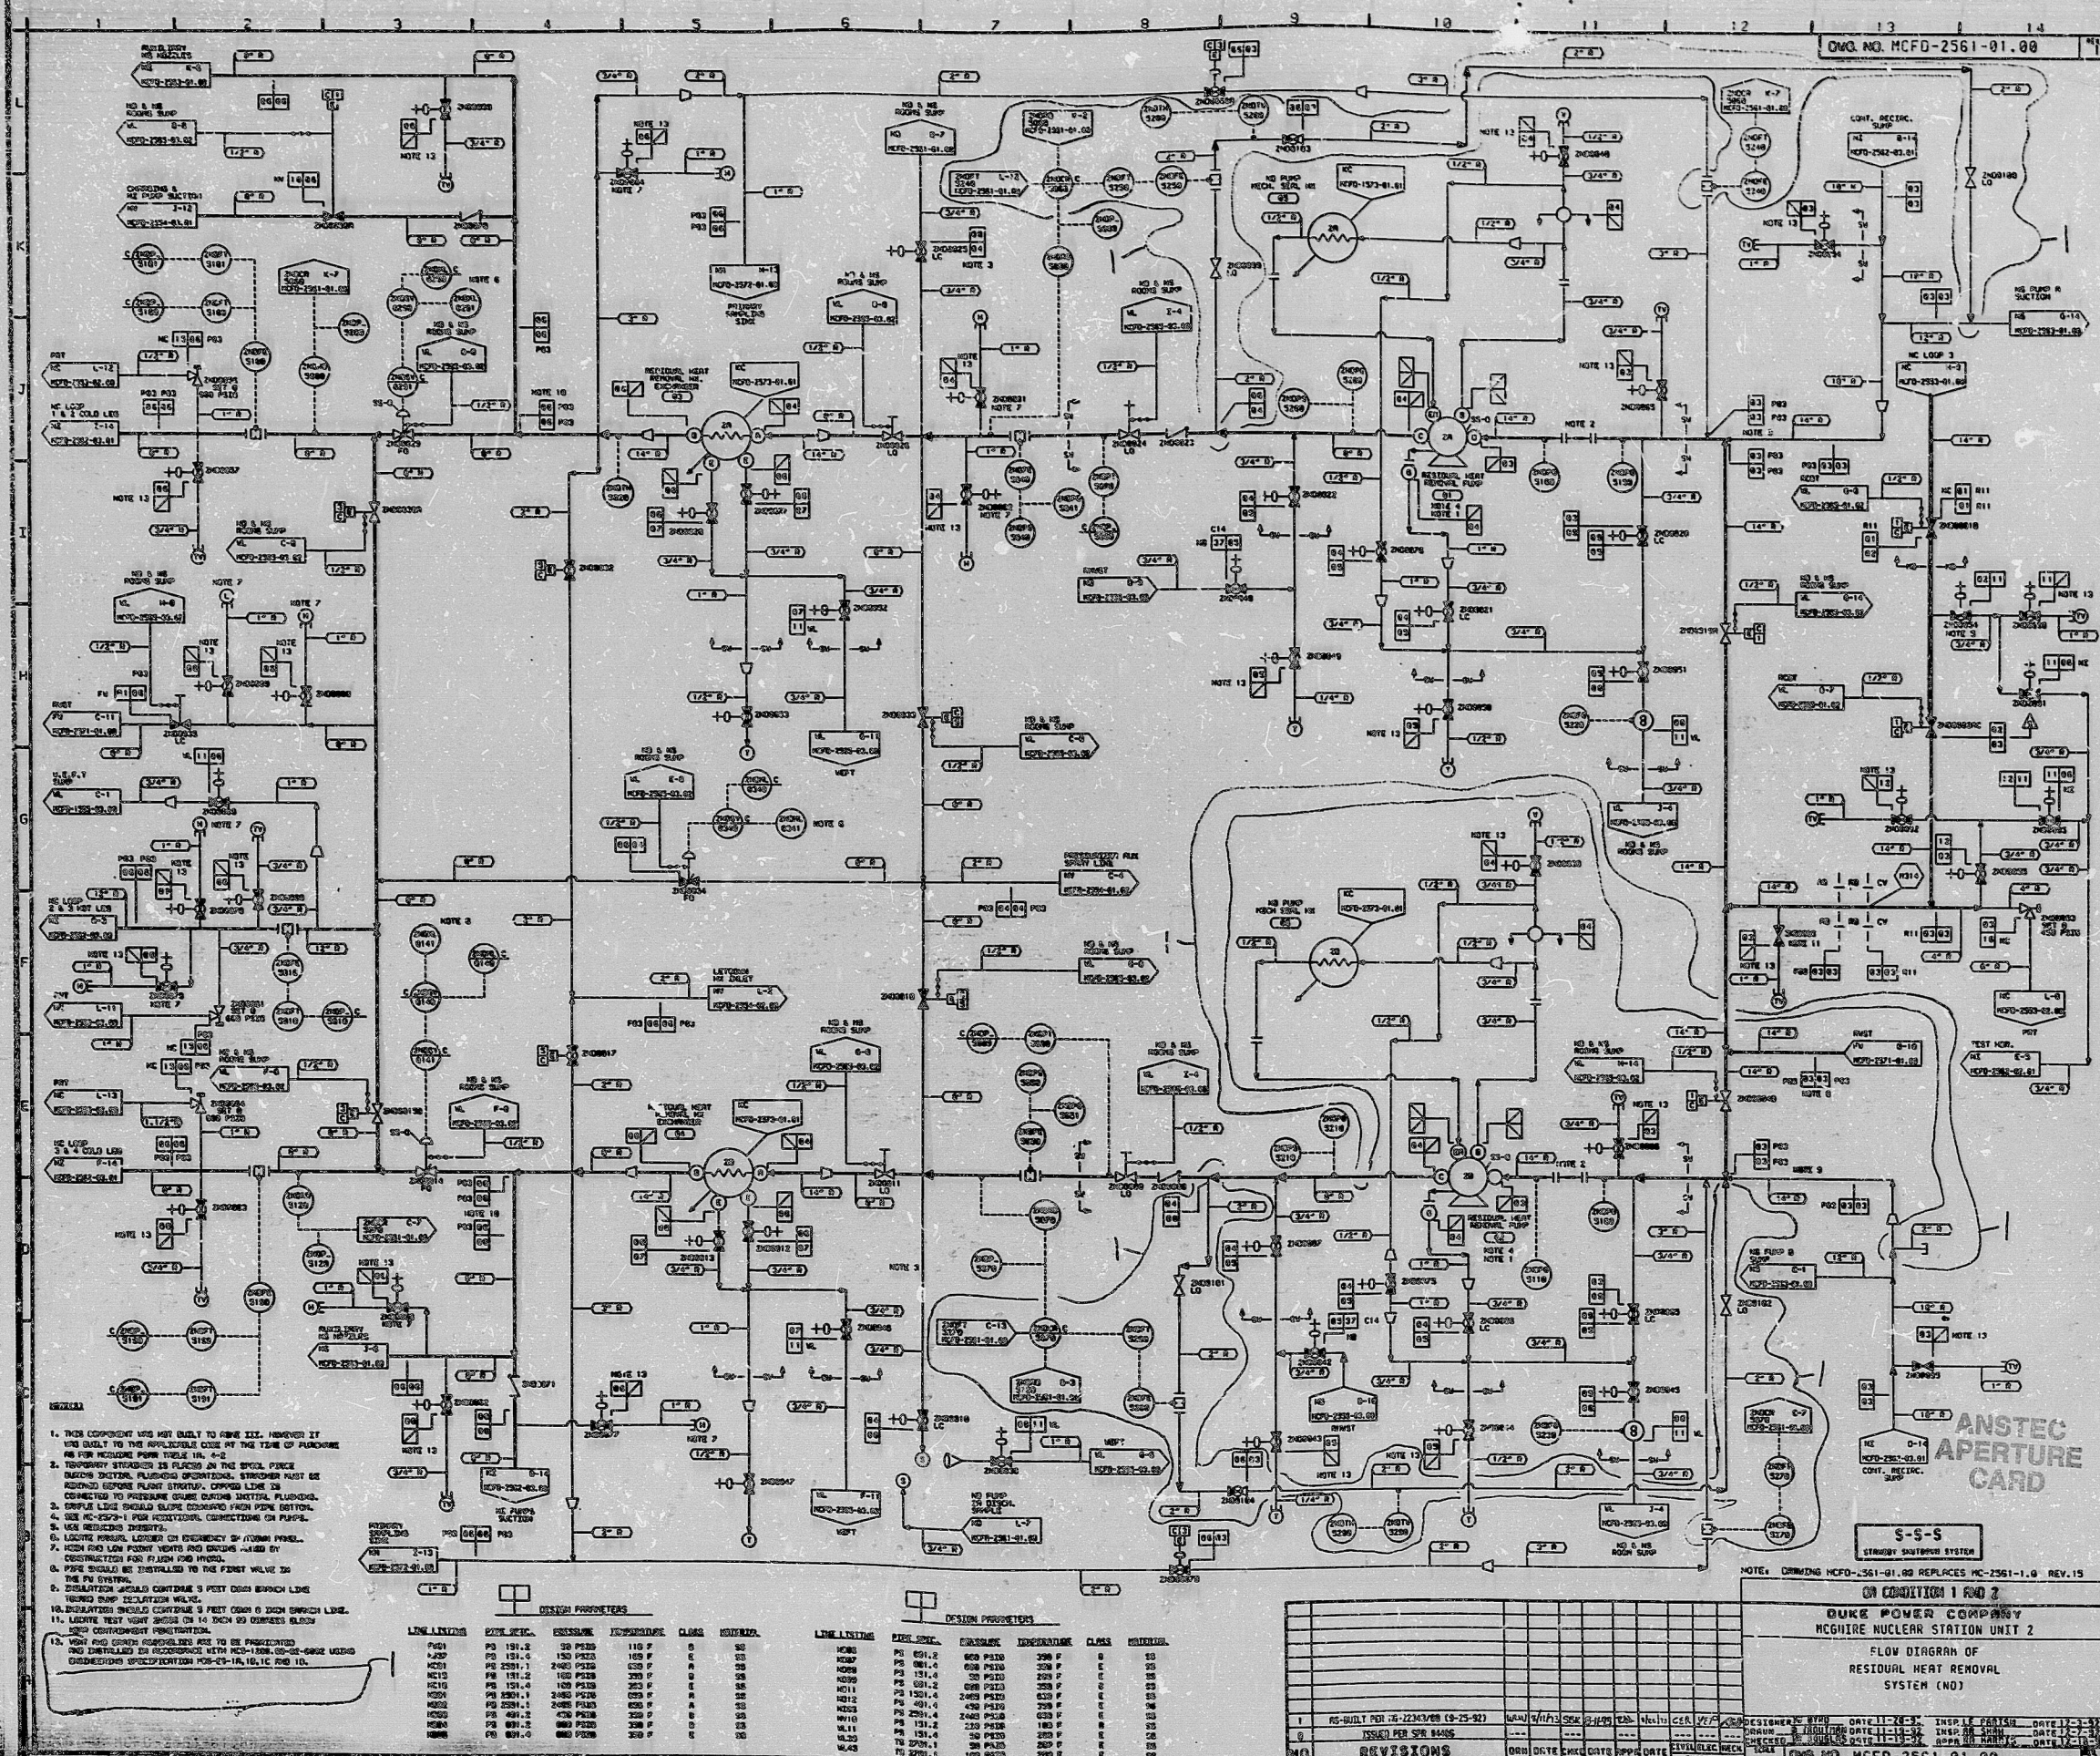

**ANSTEC
APERTURE
CARD**

S-S-S

NOTE: DRAWING HCFD-2361-01.00 REPLACES MC-2361-1.0 REV.15
ON CONDITION 1 AND 2
DUKE POWER COMPANY
MCQUIRE NUCLEAR STATION UNIT 2
FLOW DIAGRAM OF
RESIDUAL HEAT REMOVAL
SYSTEM (NO)

[illegible]

DESIGNER: BYRD	DATE 11-28-91	INSP: L. P. PANKS	DATE 12-1-91


PDR RIDS

9504120224

