
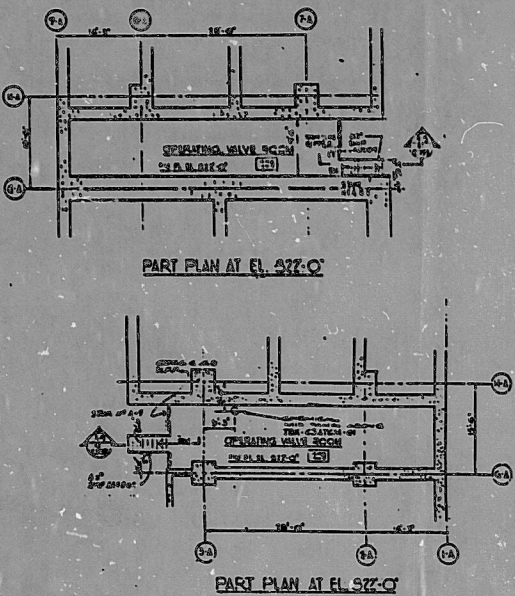


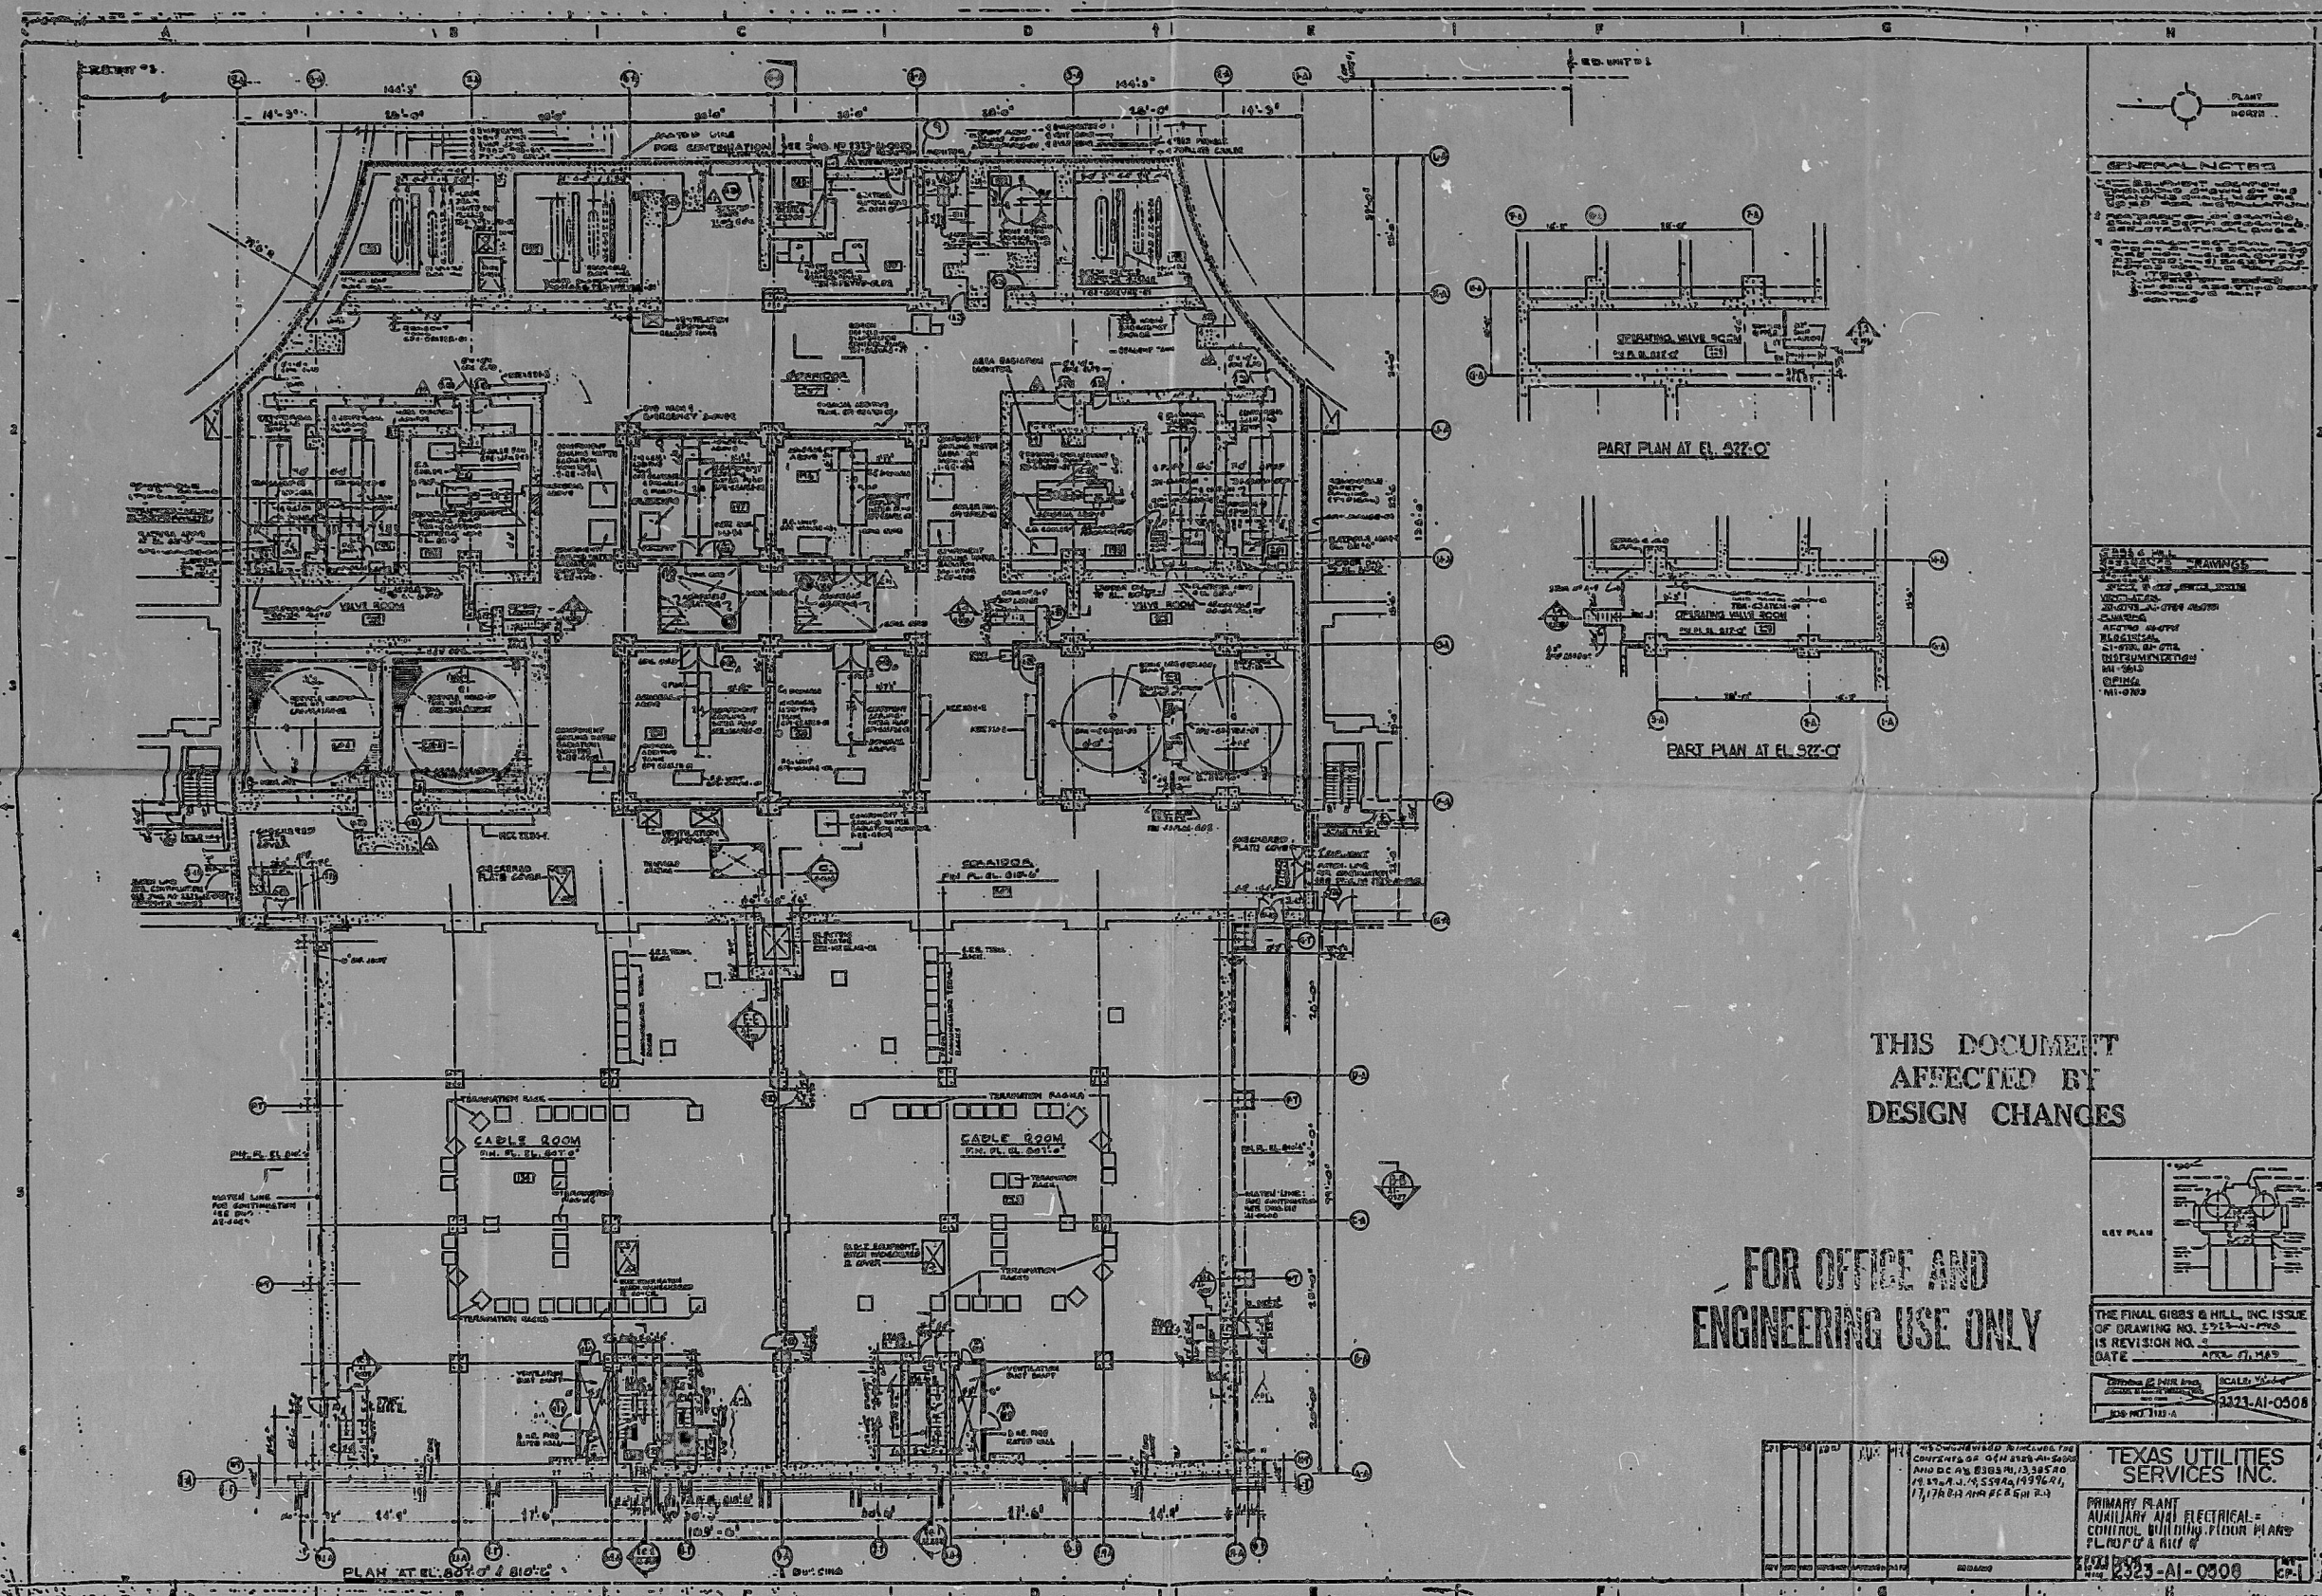



REVISIONS

NO.	DATE	DESCRIPTION
1	11-19-63	ISSUED FOR CONSTRUCTION

THIS DOCUMENT
AFFECTED BY
DESIGN CHANGES

FOR OFFICE AND
ENGINEERING USE ONLY

KEY PLAN

THE FINAL GIBBS & HILL, INC. ISSUE
OF DRAWING NO. 2323-AI-0908
IS REVISION NO. 1
DATE 11-19-63

NO.	DATE	DESCRIPTION
1	11-19-63	ISSUED FOR CONSTRUCTION

TEXAS UTILITIES SERVICES INC.

PRIMARY PLANT
ELECTRICAL
CONTROL BUILDING FLOOR PLANS

2323-AI-0908

TI
APERTURE
CARD

8605230184

PDR

8605230184

