


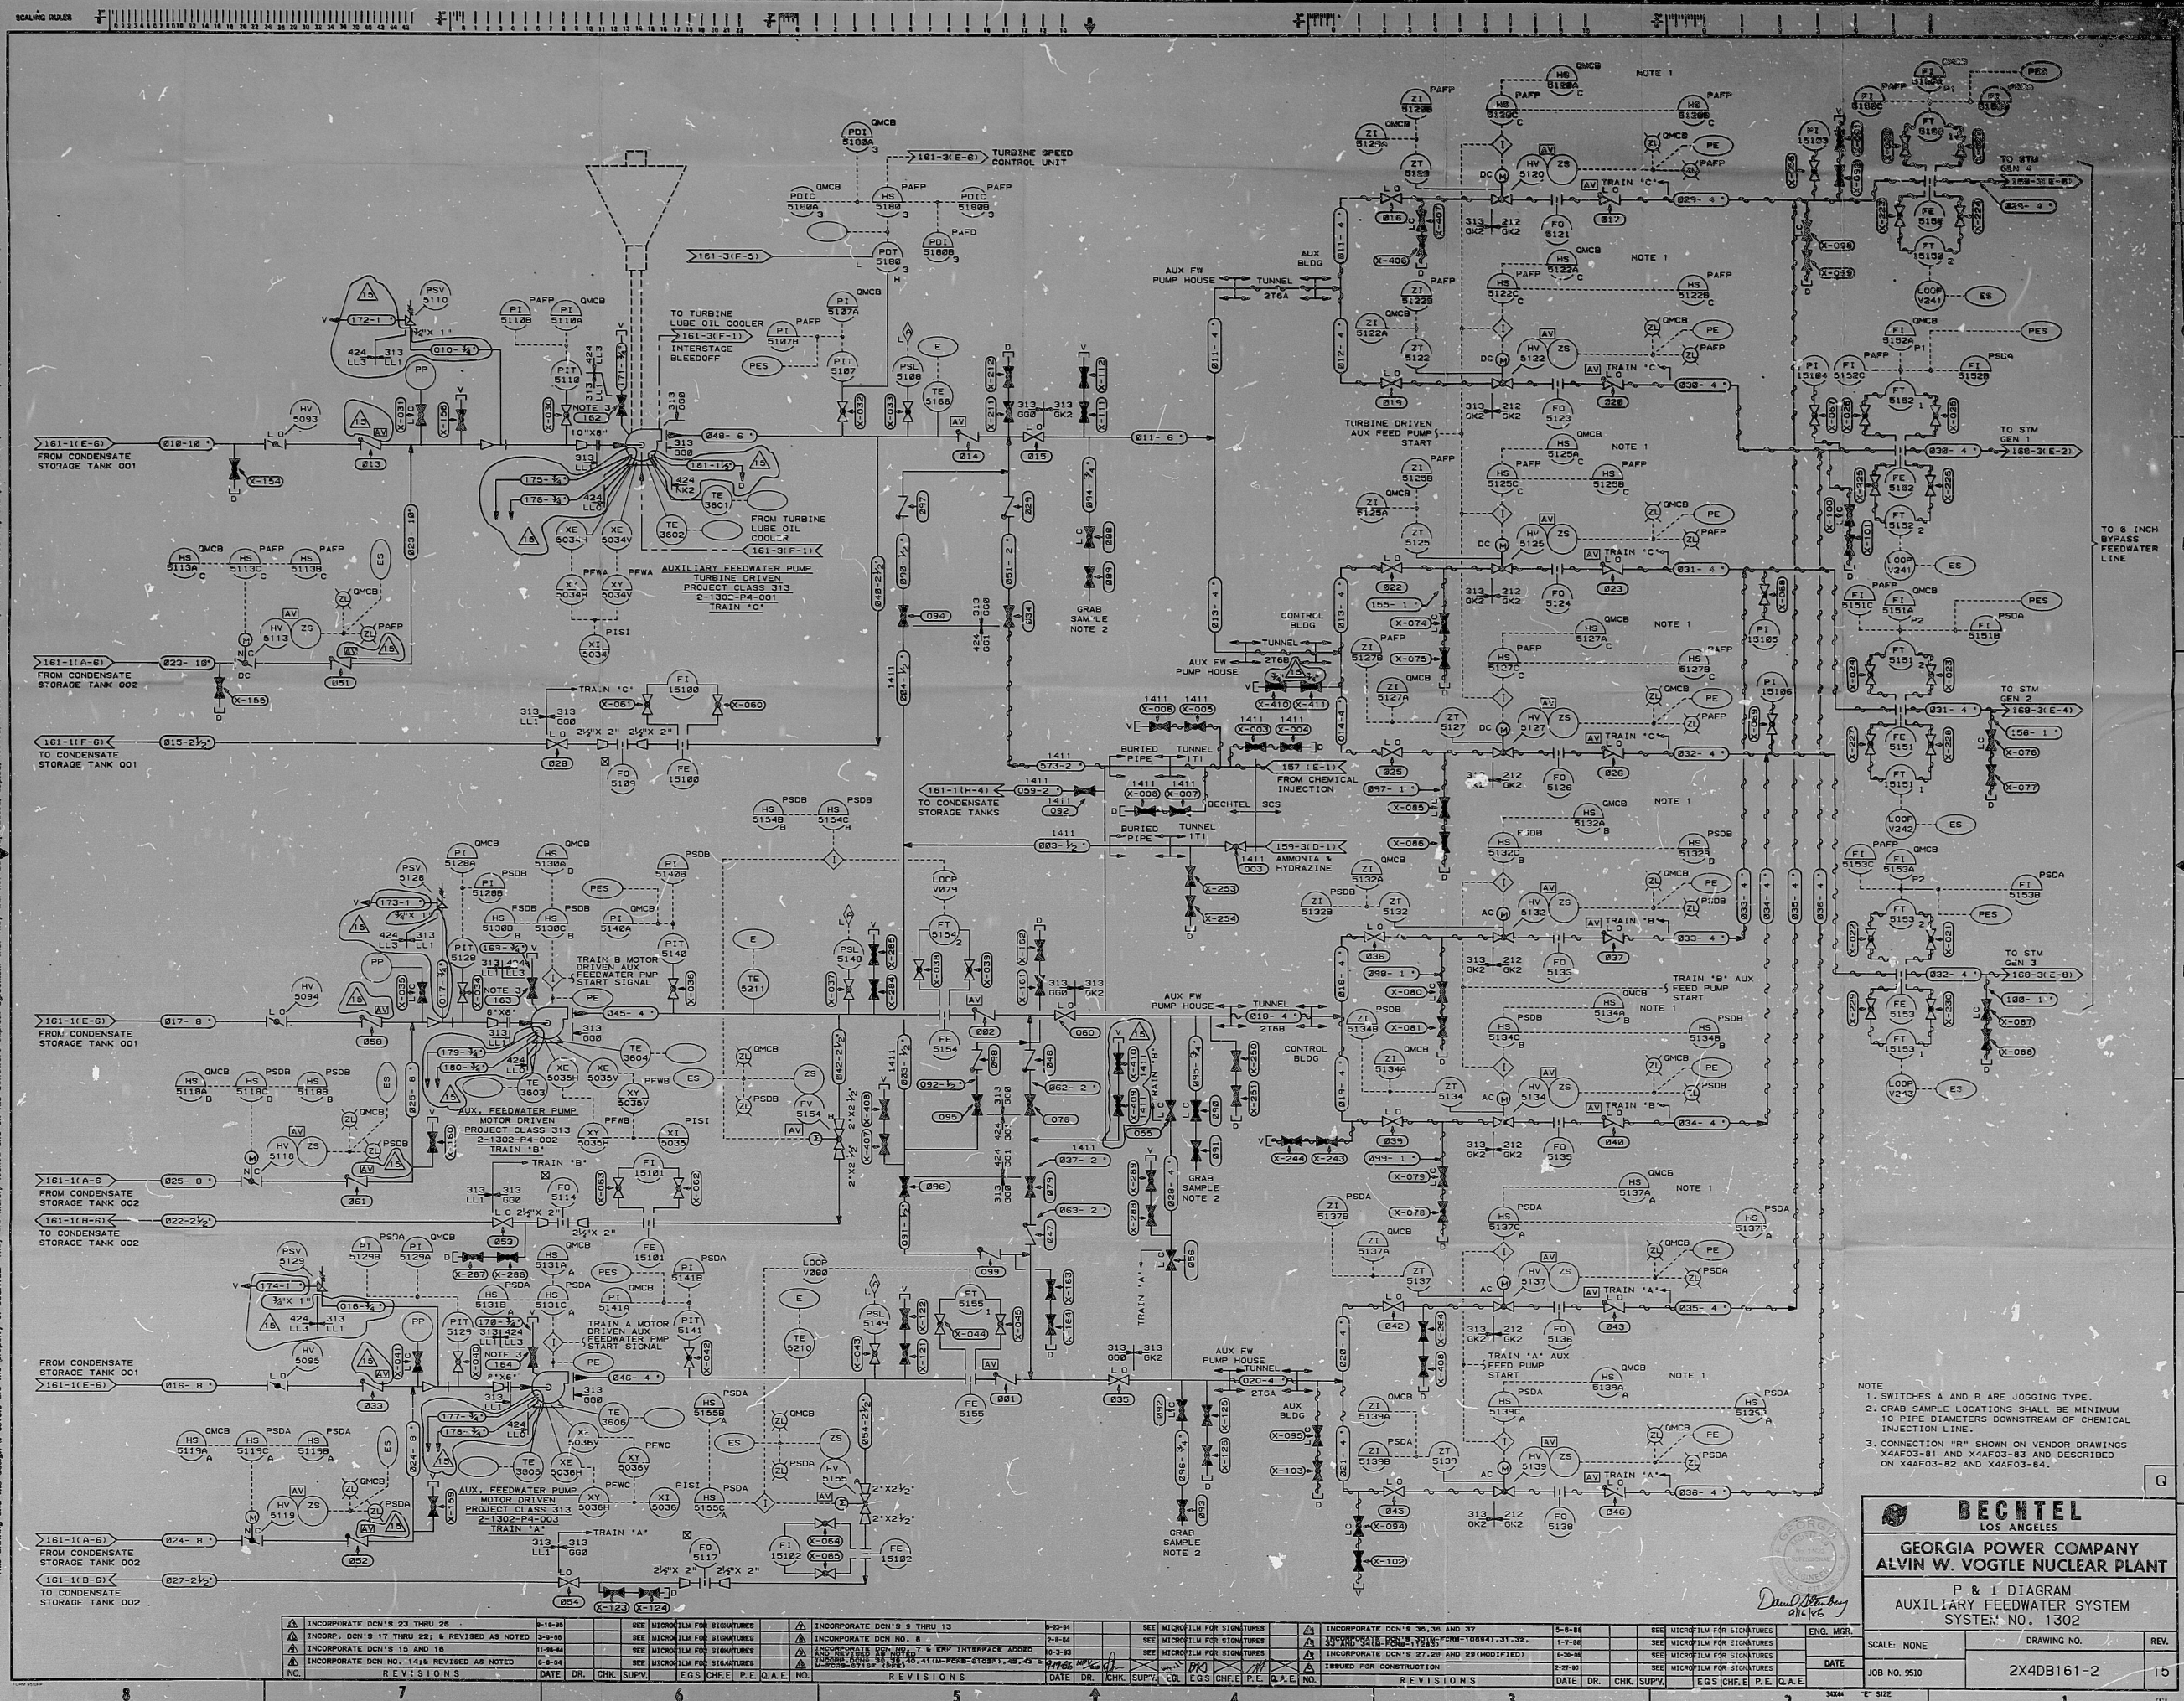

drawings and the design are the property of BECHTEL. They are merely loaned and on the borrower's express agreement that they will not be reproduced, copied, loaned, exhibited, or used except in the limited way and private use permitted by any written consent given by the lender to the borrower.

NOTE

1. SWITCHES A AND B ARE JOGGING TYPE.
2. GRAB SAMPLE LOCATIONS SHALL BE MINIMUM 10 PIPE DIAMETERS DOWNSTREAM OF CHEMICAL INJECTION LINE.

BECHTEL
LOS ANGELES

GEORGIA POWER COMPANY
ALVIN W. VOGTLE NUCLEAR PLANT

P & I DIAGRAM
AUXILIARY FEEDWATER SYSTEM
SYSTEM NO. 1302

David Steinberg
9/16/86

ENG. MGR.	SCALE: NONE	DRAWING NO.	REV
DATE		2X4DB161-2	15
	JOB NO. 9510		

TI
APERTUR

PDR RIDS

8703160434

34

