


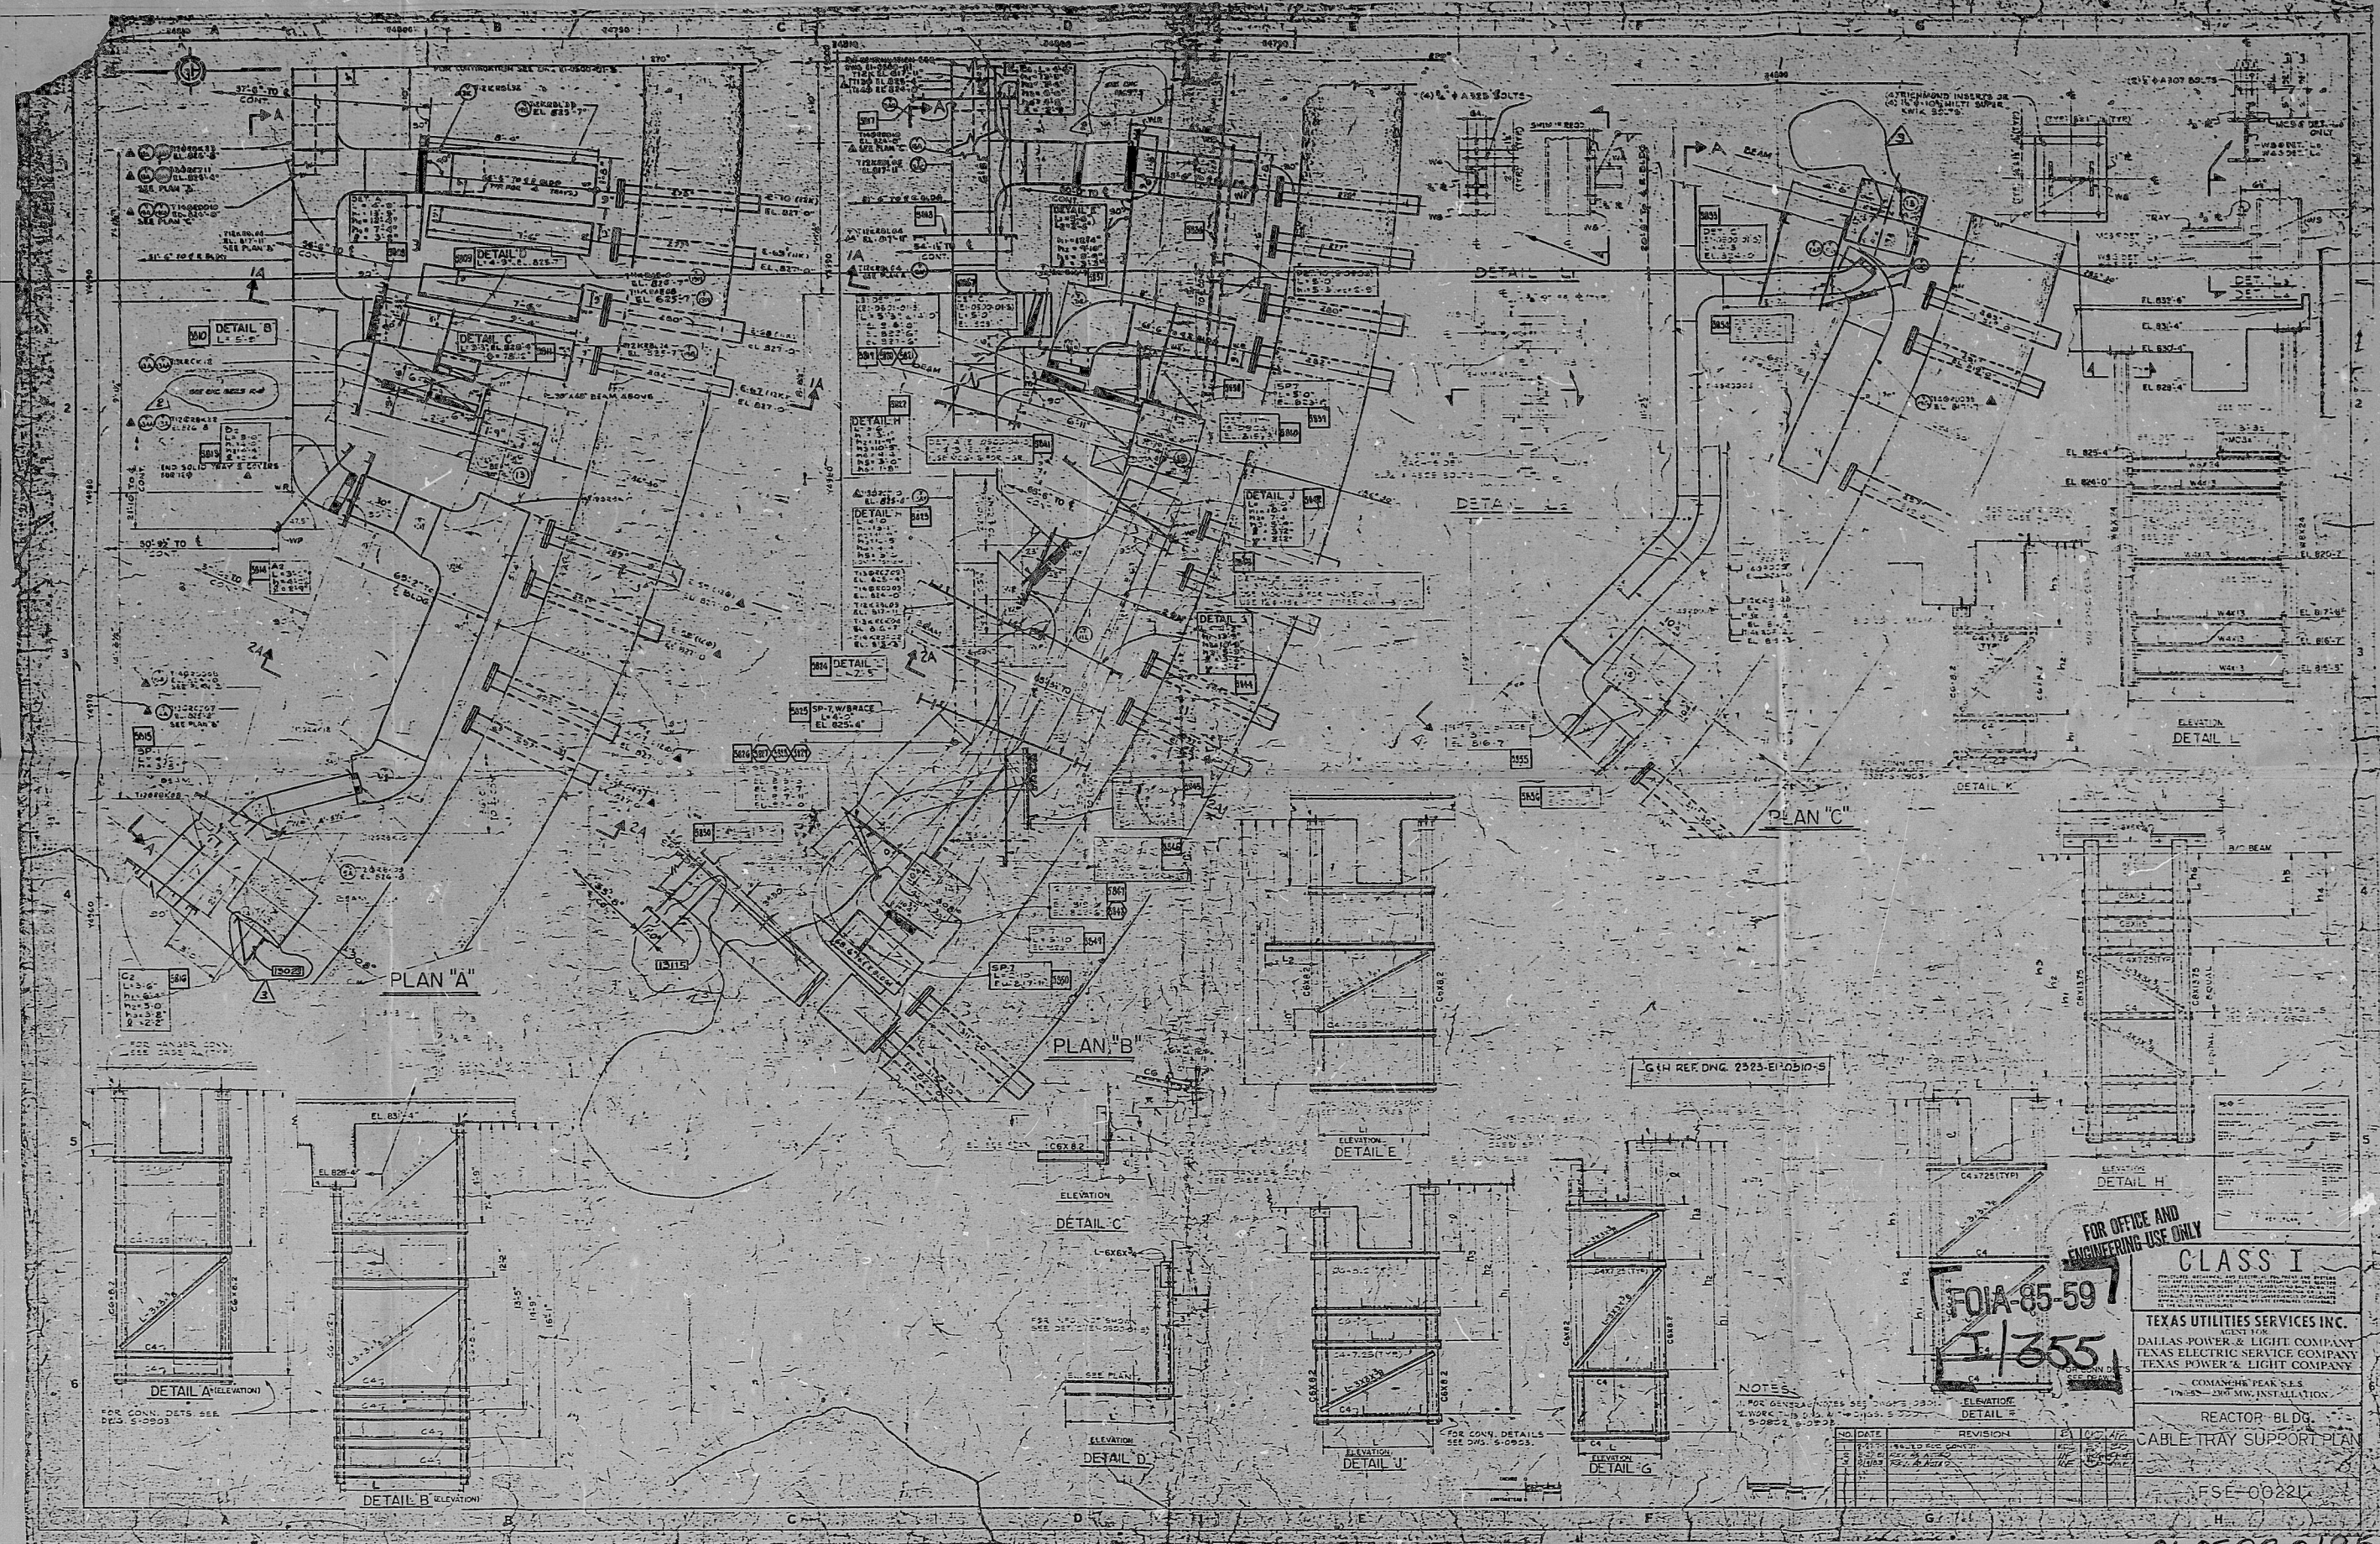

FOIA-85-597
I/355

FOR OFFICE AND
ENGINEERING USE ONLY

CLASS I

TEXAS UTILITIES SERVICES INC.
DALLAS POWER & LIGHT COMPANY
TEXAS ELECTRIC SERVICE COMPANY
TEXAS POWER & LIGHT COMPANY

REACTOR BLDG.
CABLE TRAY SUPPORT PLAN

FS-00221

NO.	DATE	REVISION

8605230195

IT
APERTURE
CARD

PDR

8605230195

