


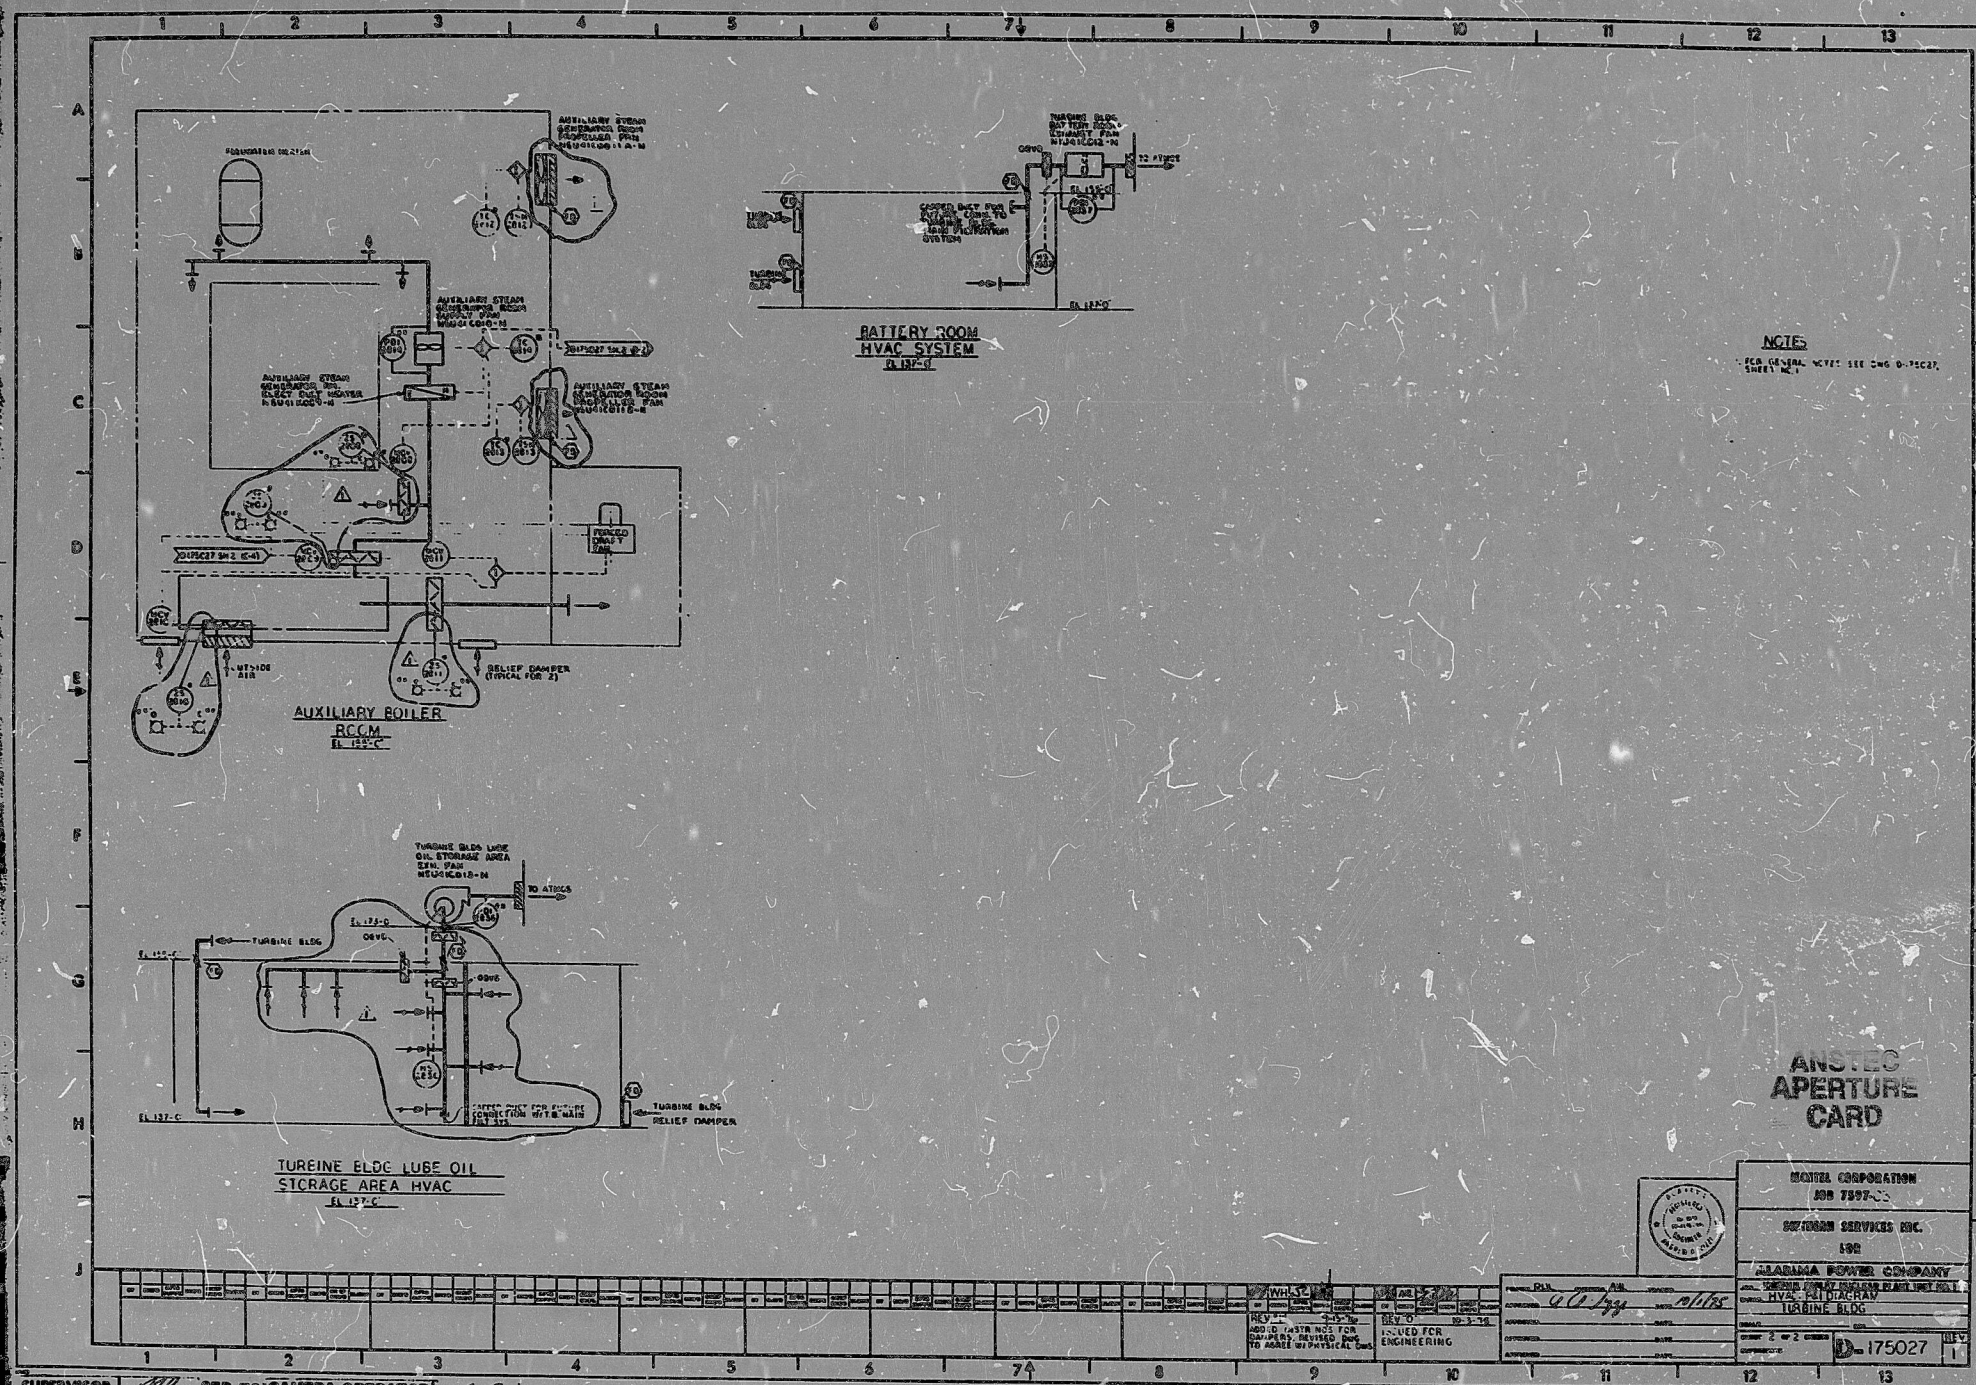

9801210063

PDR RIDS

9801210063

