


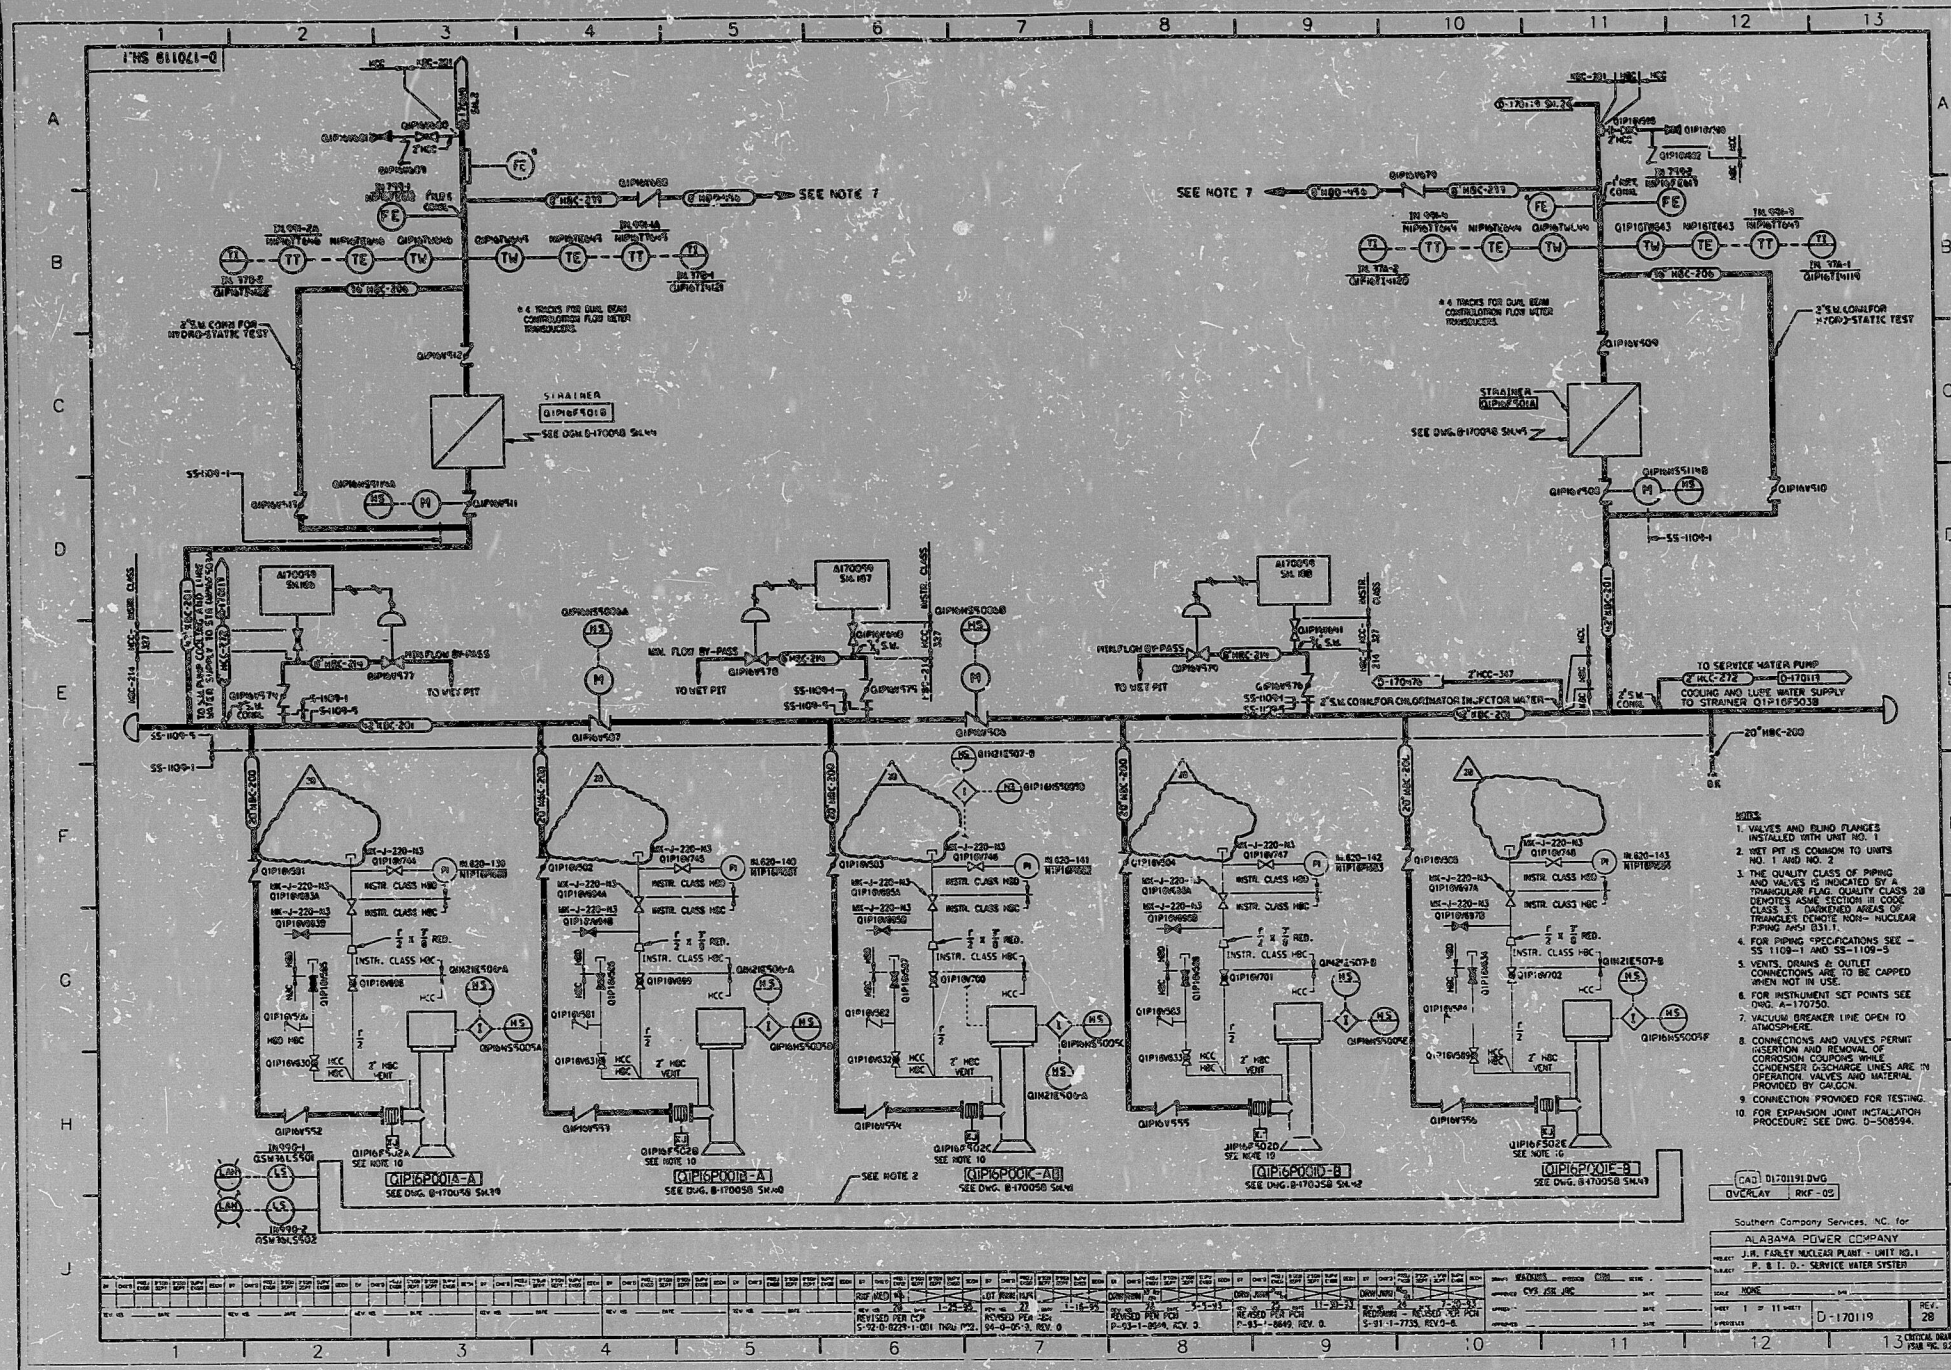

ANSTEC
APERTURE
CARD

PDR RIDS

9605200248

